900353

(1)

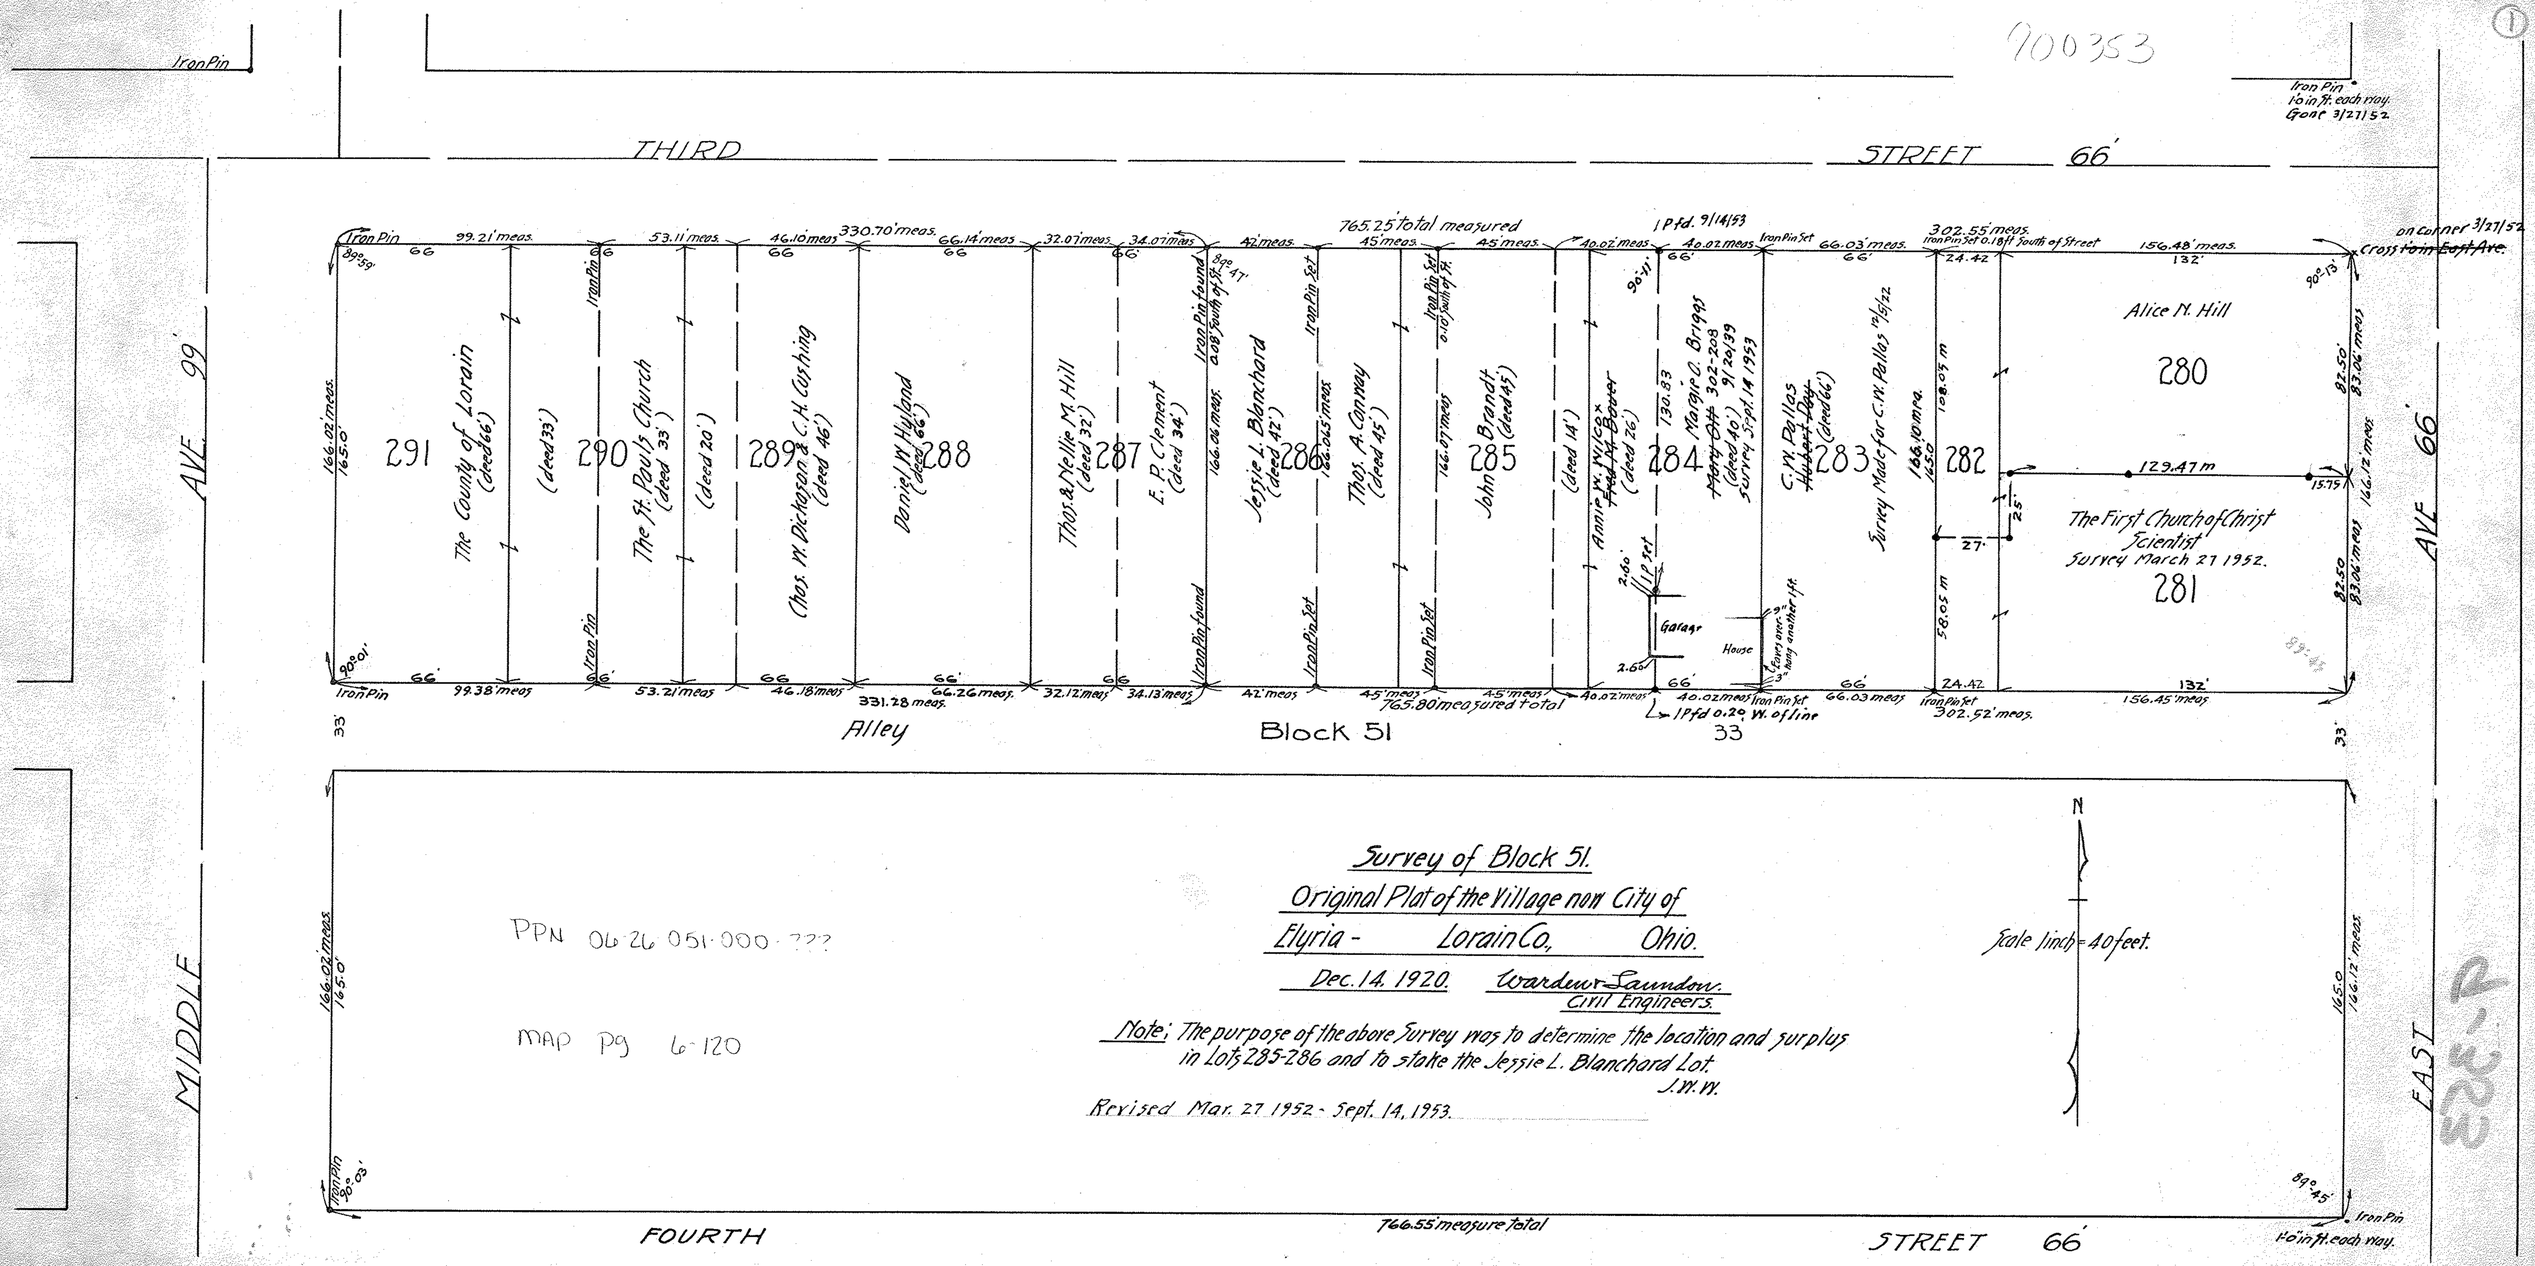

Survey of Block 51.
Original Plat of the Village now City of
Elyria - Lorain Co., Ohio.
Dec. 14. 1920. Wardeur-Saunders, Civil Engineers.

Note: The purpose of the above Survey was to determine the location and surplus in Lots 285-286 and to stake the Jessie L. Blanchard Lot.
J.W.W.

Revised Mar. 27 1952 - Sept. 14, 1953.

PPN 06-26-051-000-???

MAP Pg 6-120

R-123