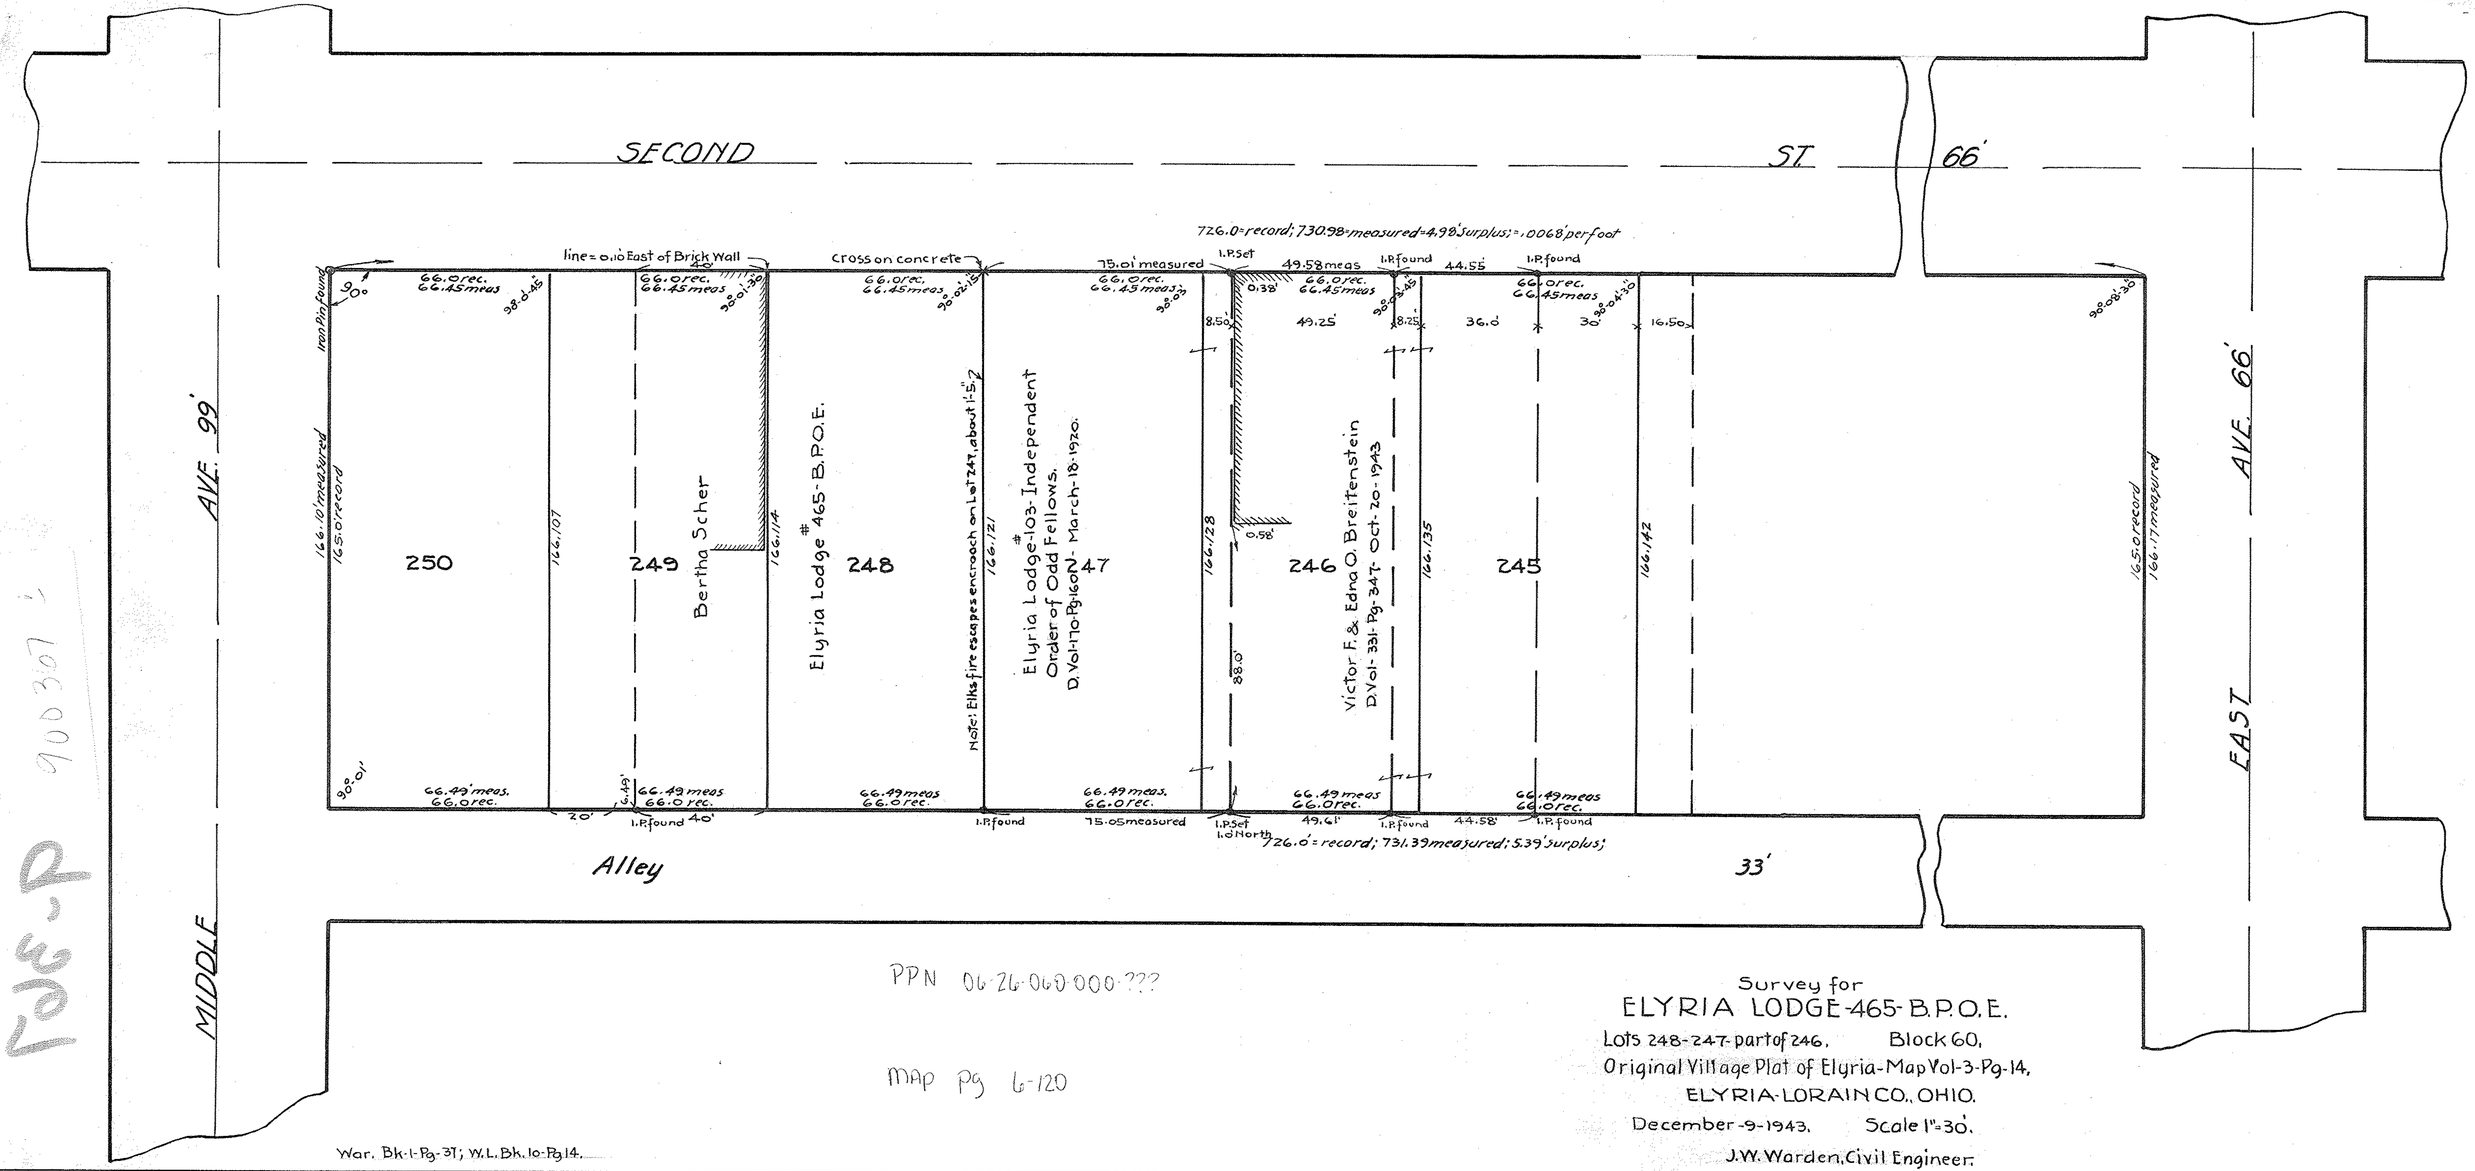

PPN 06-26-060-000-???

MAP Pg 6-120

Survey for
ELYRIA LODGE-465-B.P.O.E.
Lots 248-247-part of 246, Block 60,
Original Village Plat of Elyria-Map Vol-3-Pg-14,
ELYRIA-LORAIN CO., OHIO.
December-9-1943. Scale 1"=30'.
J.W. Warden, Civil Engineer.

War. Bk-1-Pg-31; W.L. Bk. 10-Pg 14.

900307

P-3261