PPN 07-00-021-117-???

MAP Pg 07-00-021-C

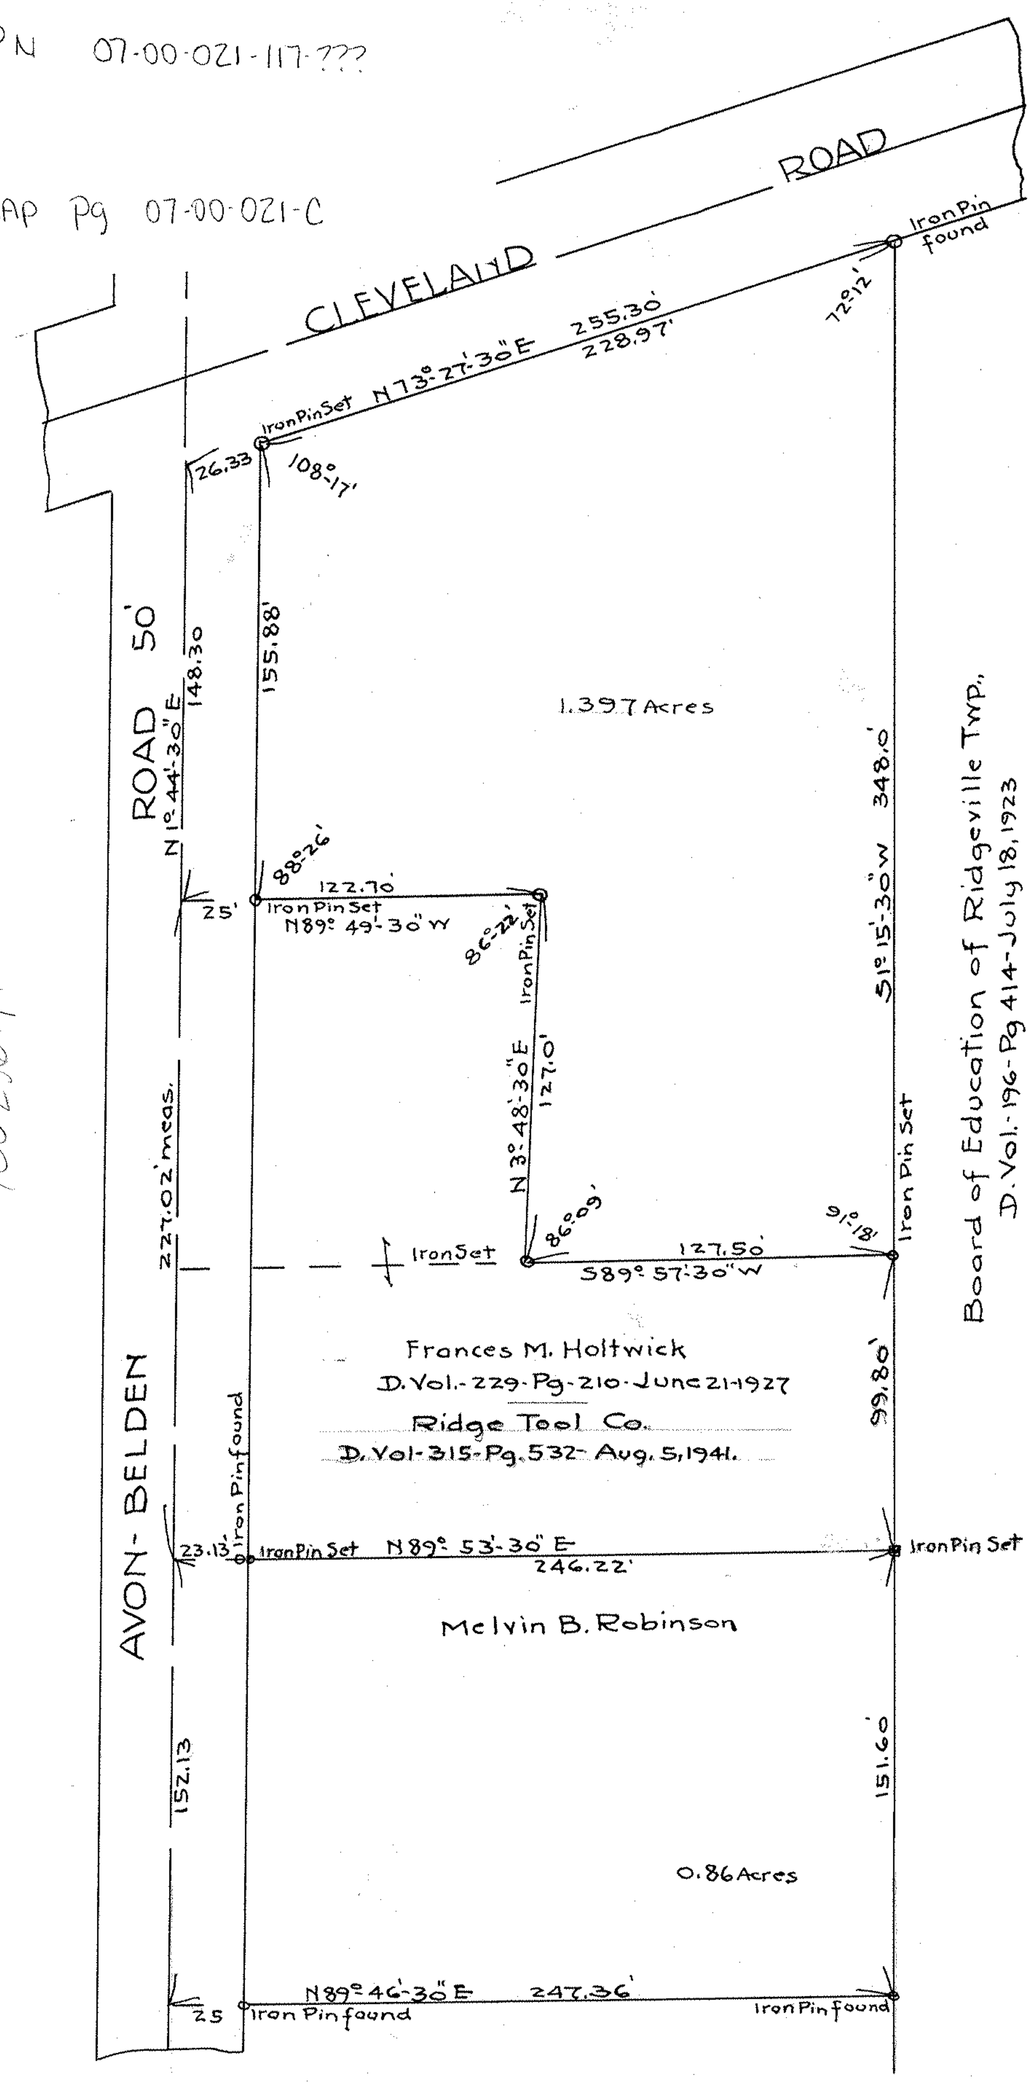

960236 A

Survey for
The Ridge Tool Company.
Original Twp., Lot 21. Ridgeville Twp.,
Lorain Co., O.

March 14, 1941. Scale 1" = 50'.

Revised Oct. 24-1941. J. W. Warden. Registered Surveyor.

Note: Distances and angles shown in red outline taken from information shown on Lorain County Tax Maps.
J. W. W.