


PPN 16-00-007-103-???

MAP Pg 16-00-001-C

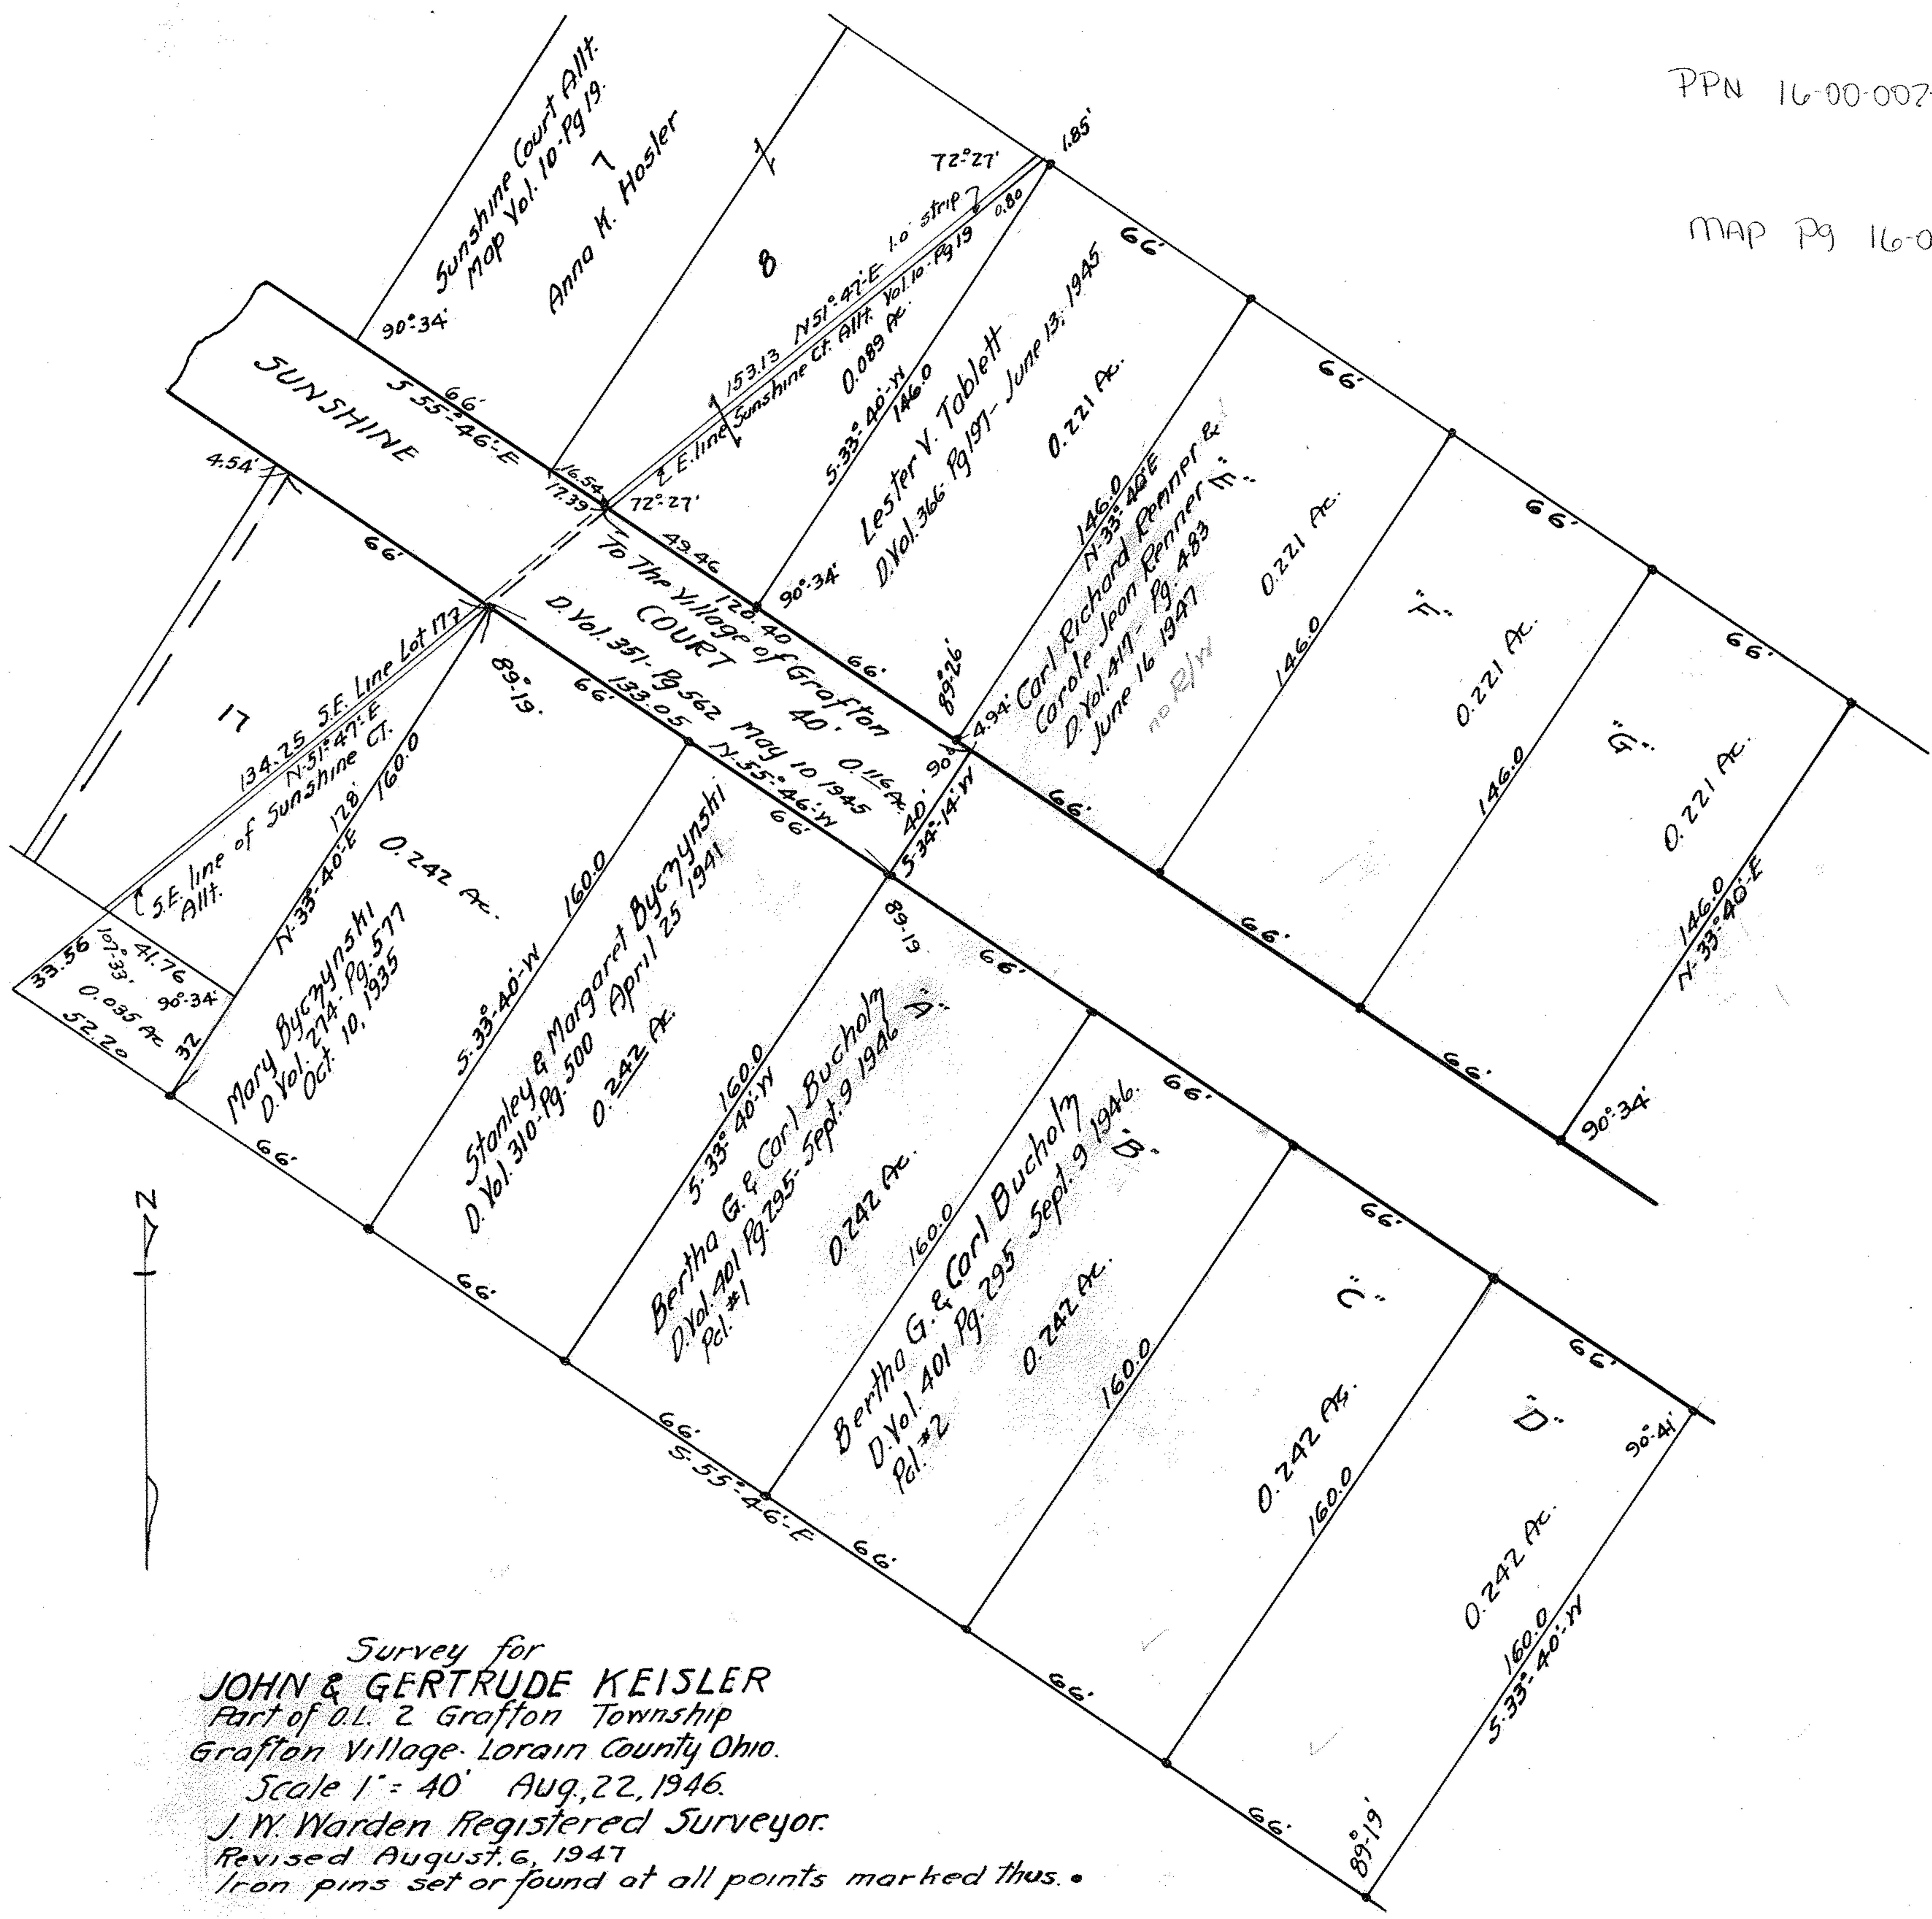

Survey for
JOHN & GERTRUDE KEISLER
 Part of O.L. 2 Grafton Township
 Grafton Village, Lorain County Ohio.
 Scale 1" = 40' Aug. 22, 1946.
 J. W. Warden Registered Surveyor.
 Revised August 6, 1947
 Iron pins set or found at all points marked thus. •