120210

SURVEY FOR B.F. FRESHWATER

of English Farm. Original Twp Lot #4
Amherst Twp. Amherst Village. Lorain Co. Ohio.
Scale 1 inch = 100 ft Dec, 9, 1918.
Warden & Laundon-Surveyors
Elyria, Ohio.

Total Acreage = 97.330

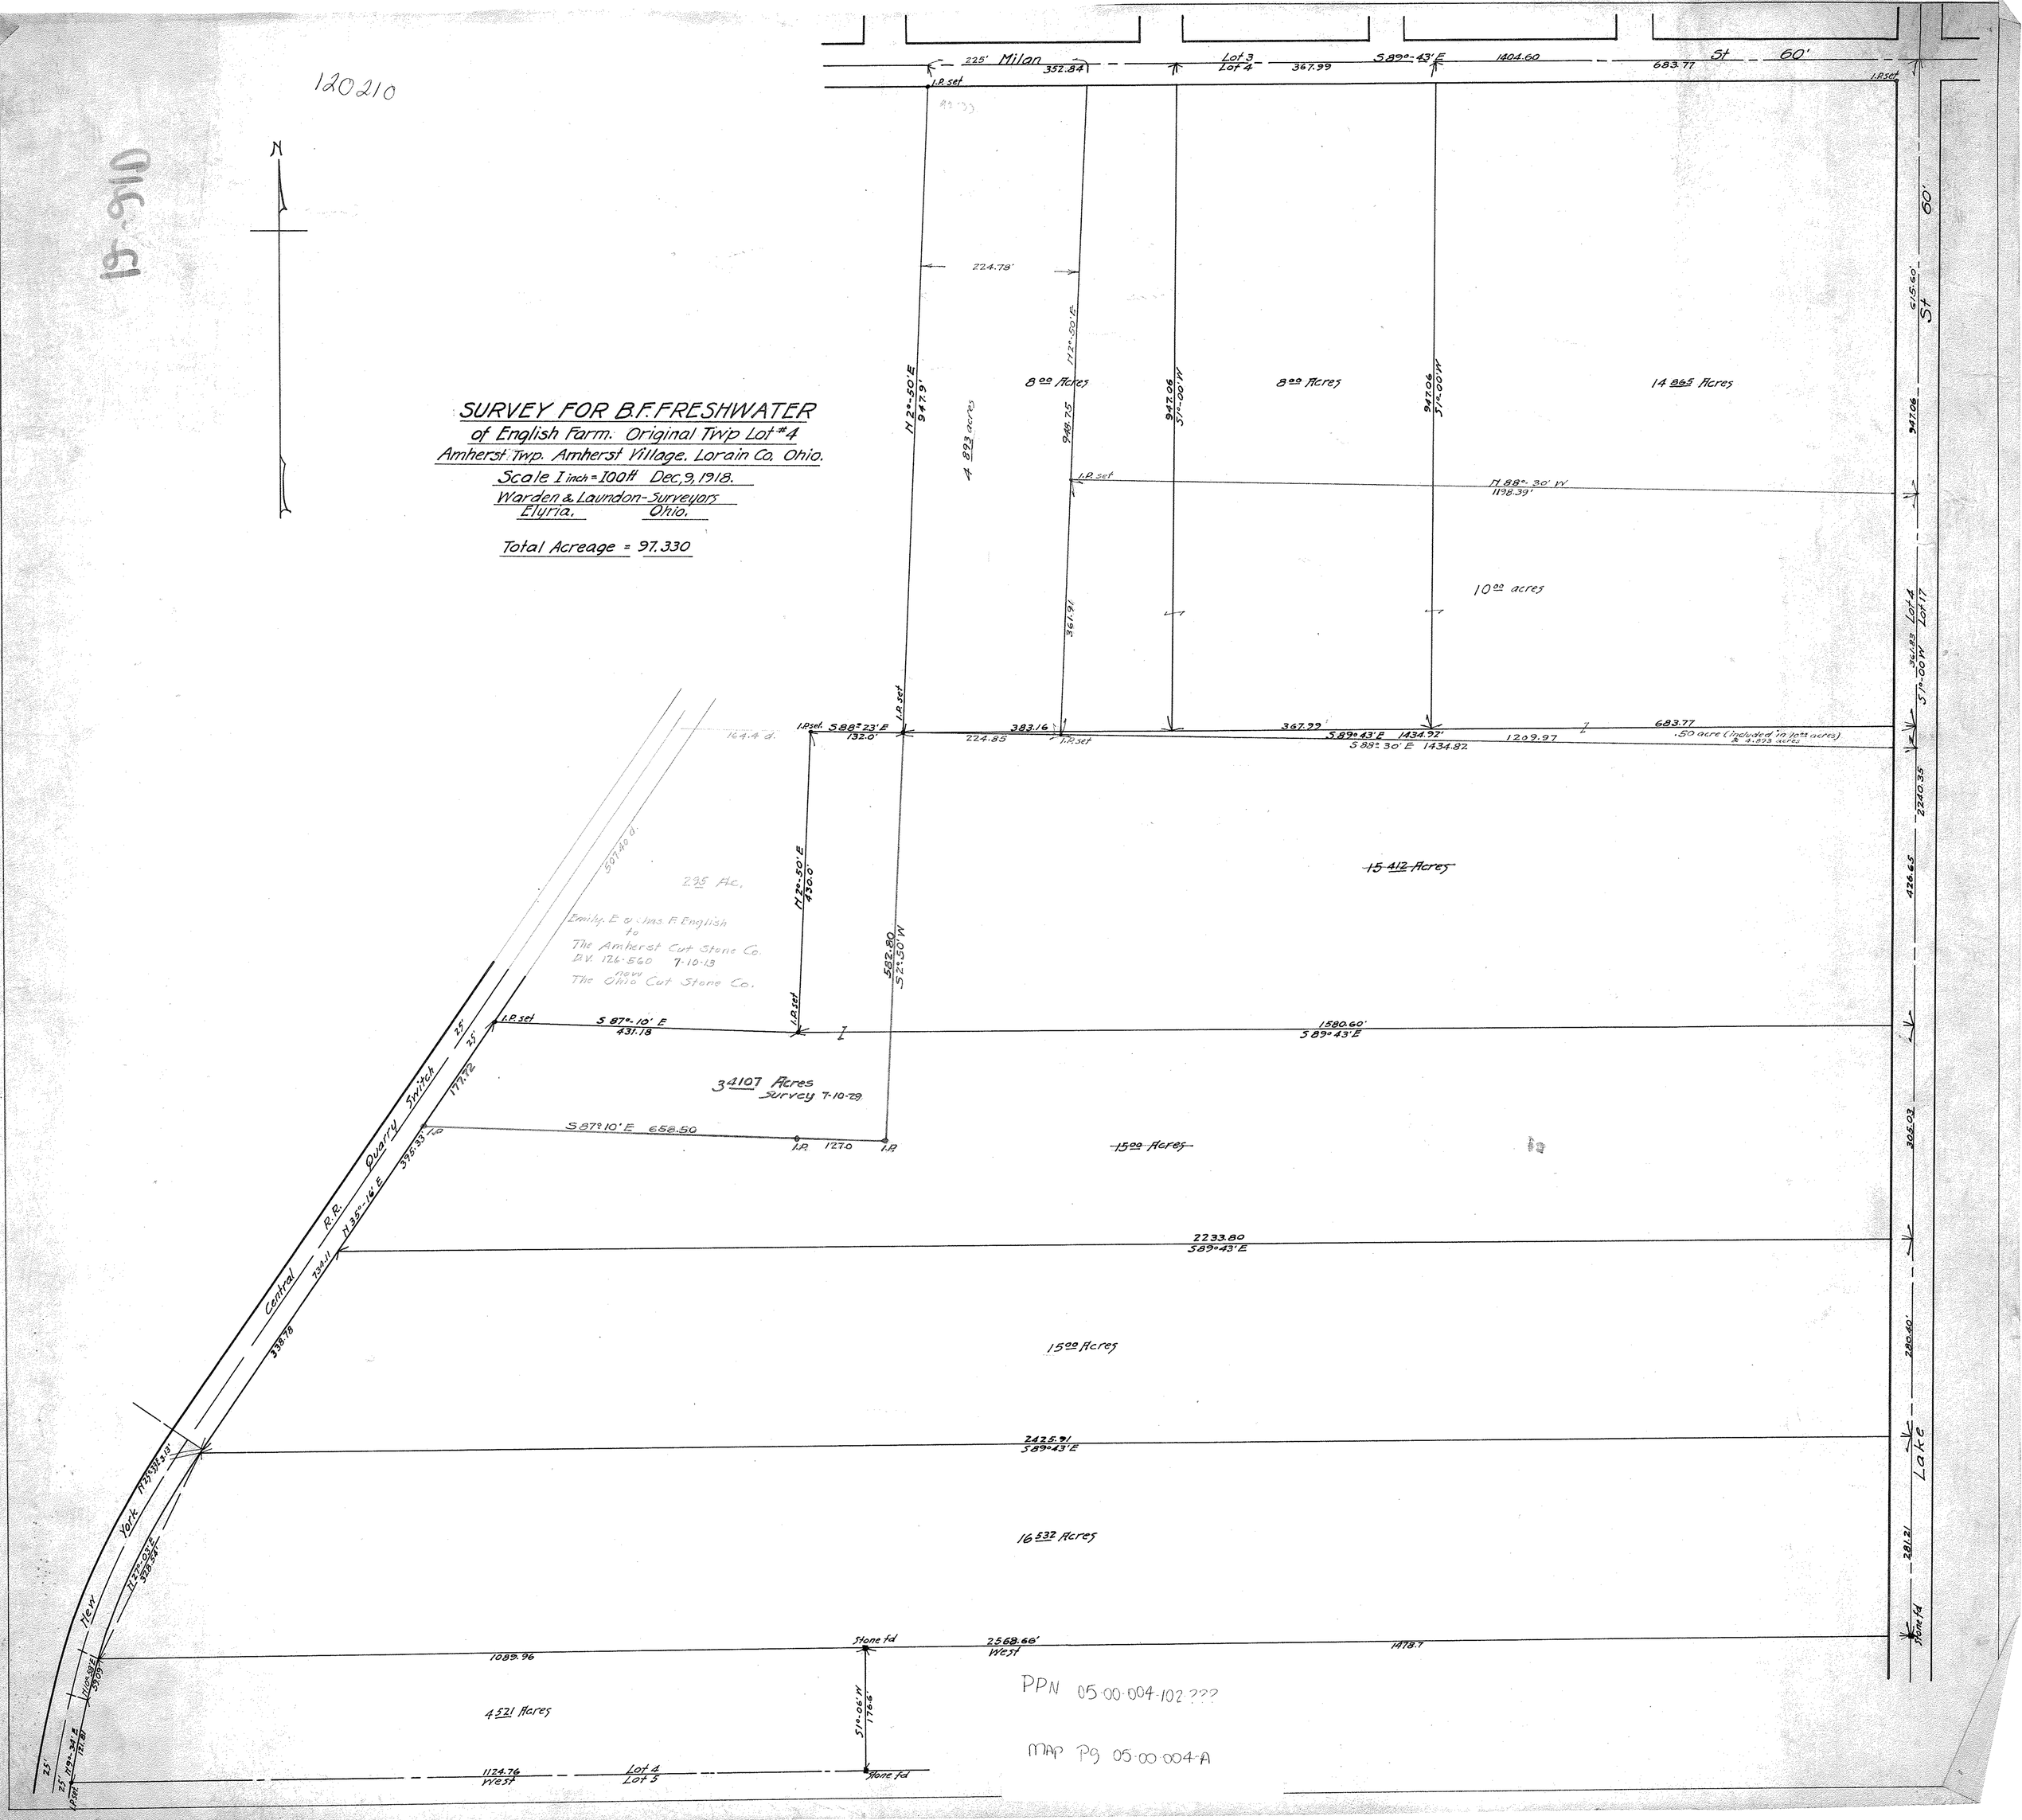

PPN 05-00-004-102 ???

MAP Pg 05-00-004-A