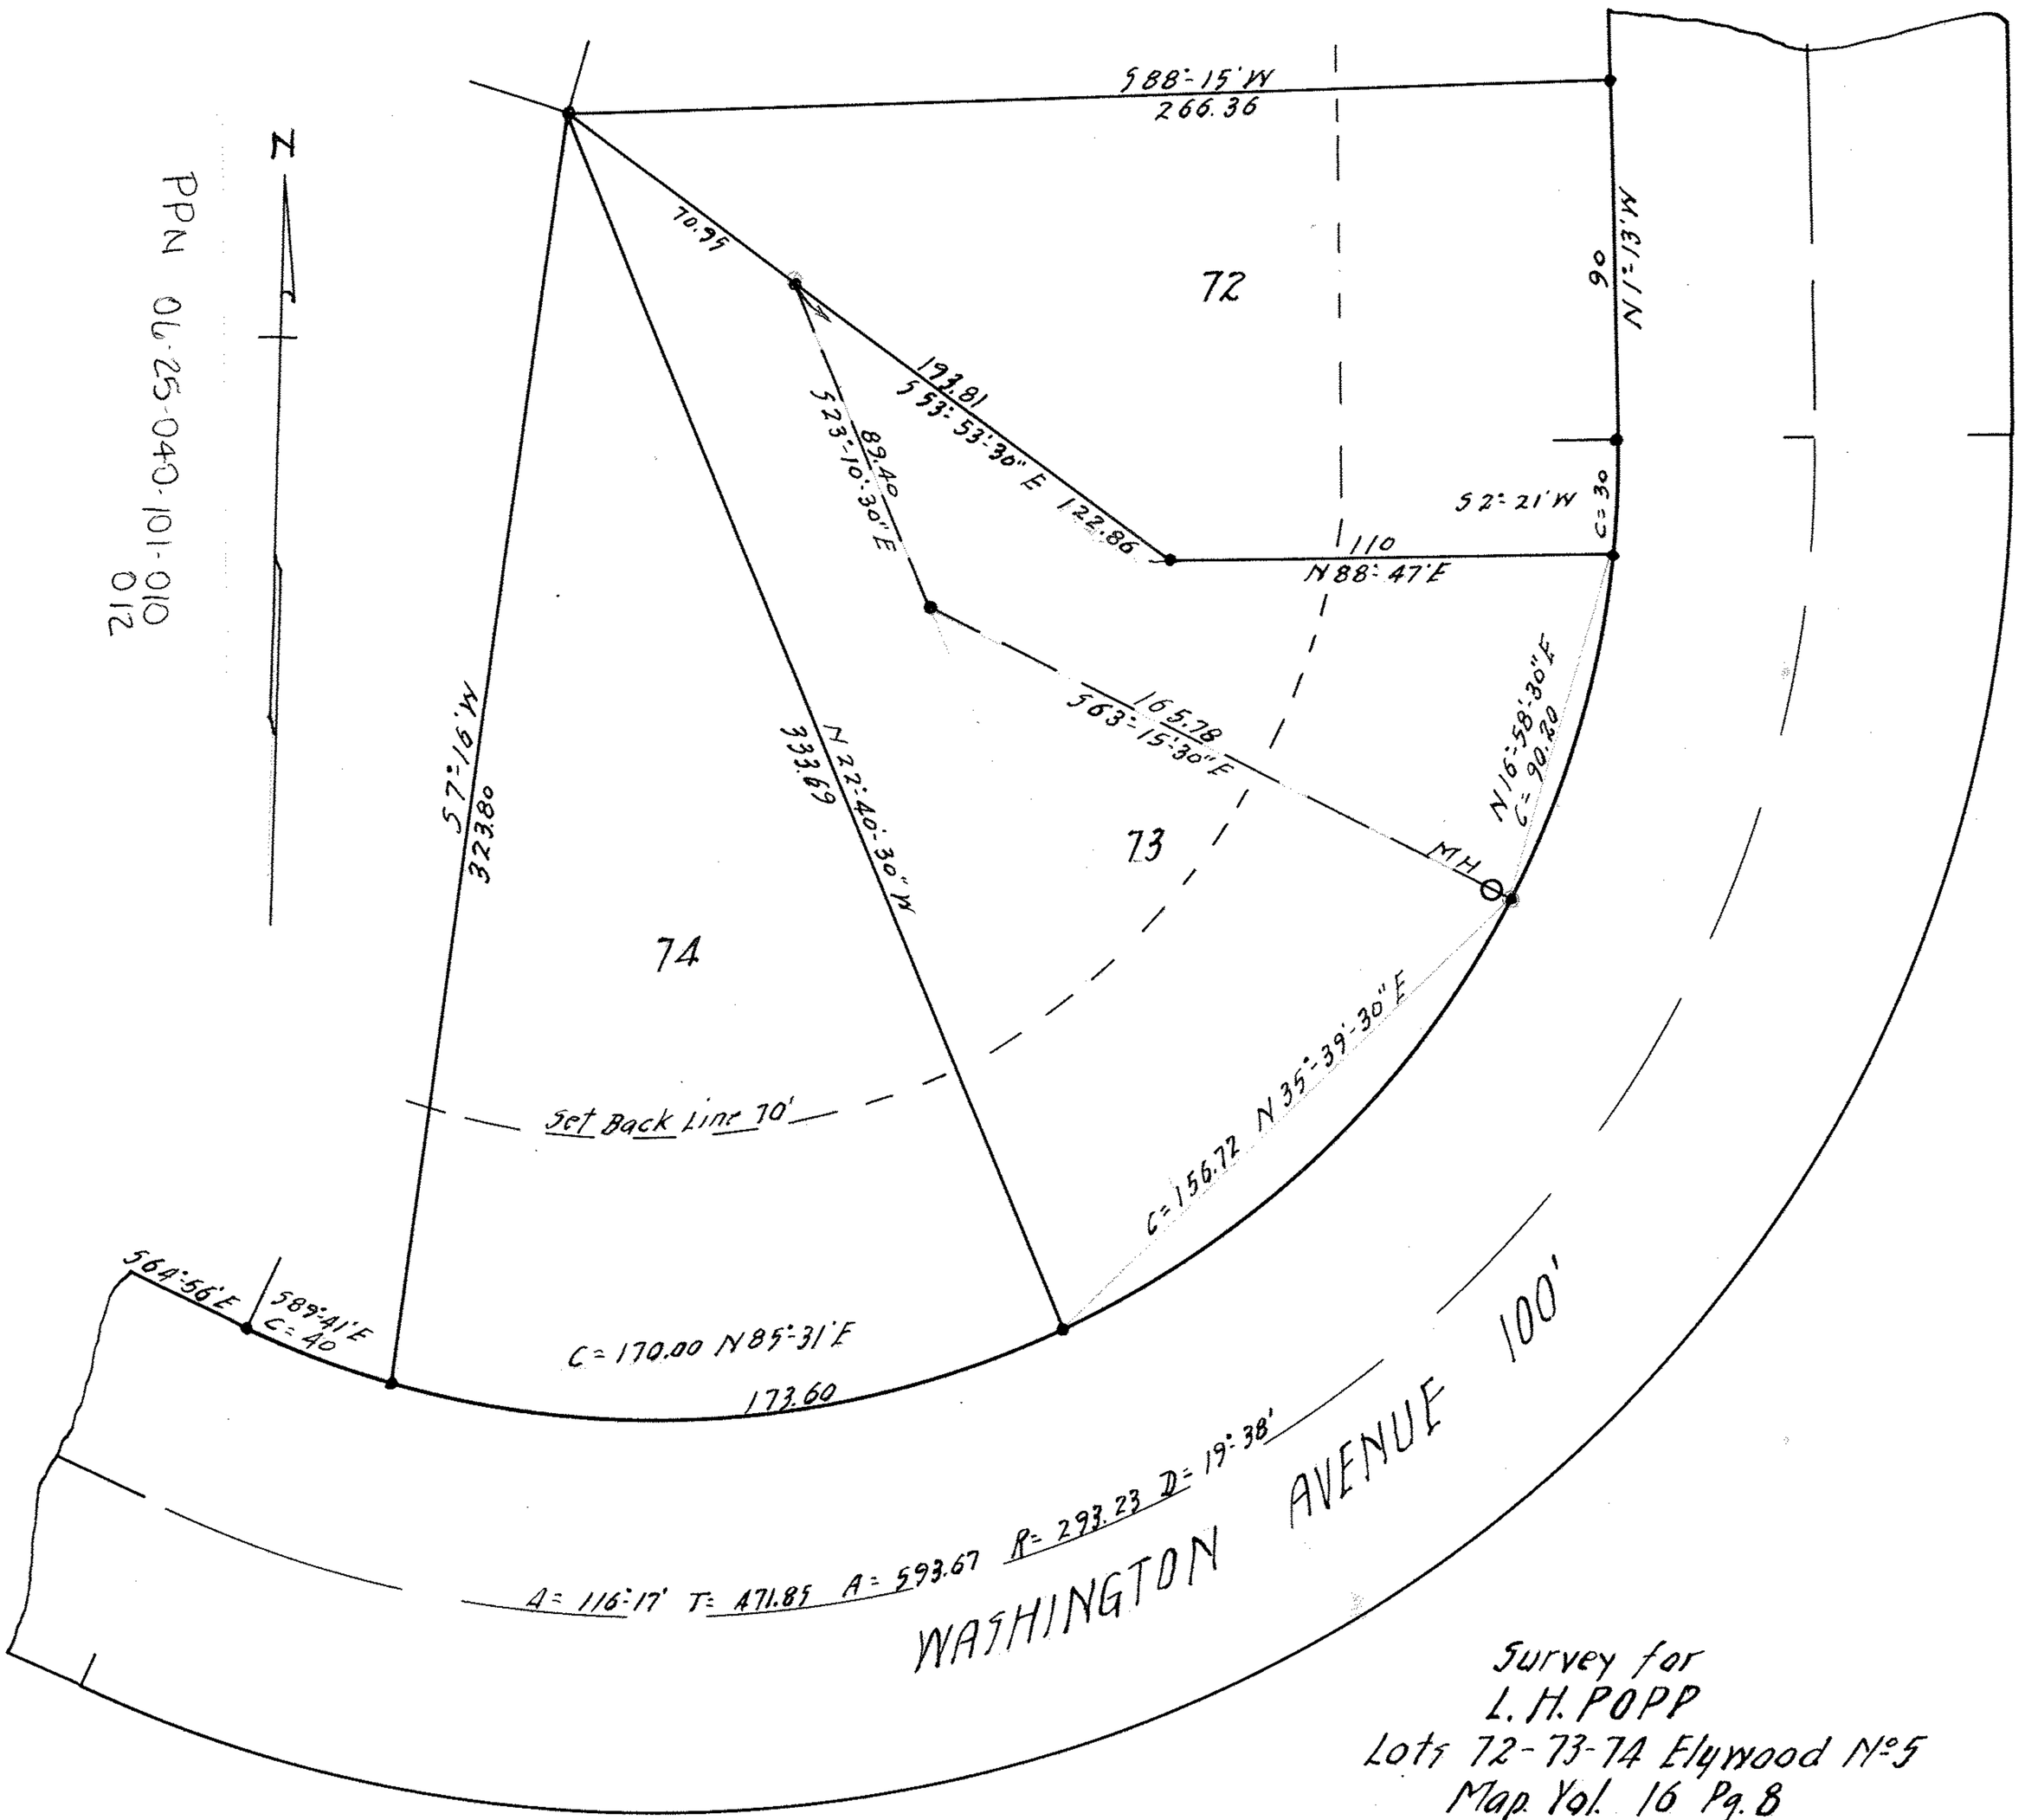

MAP PG 6-85

PPN 016-250-40-101-010
212

Survey for
L. H. POPP
Lots 72-73-74 Elywood No 5
Map Vol. 16 Pg. 8
Scale 1" = 40' Feb. 8. 1957
J. W. Warden and Associates Reg. Surveyors.

121188

73-1188