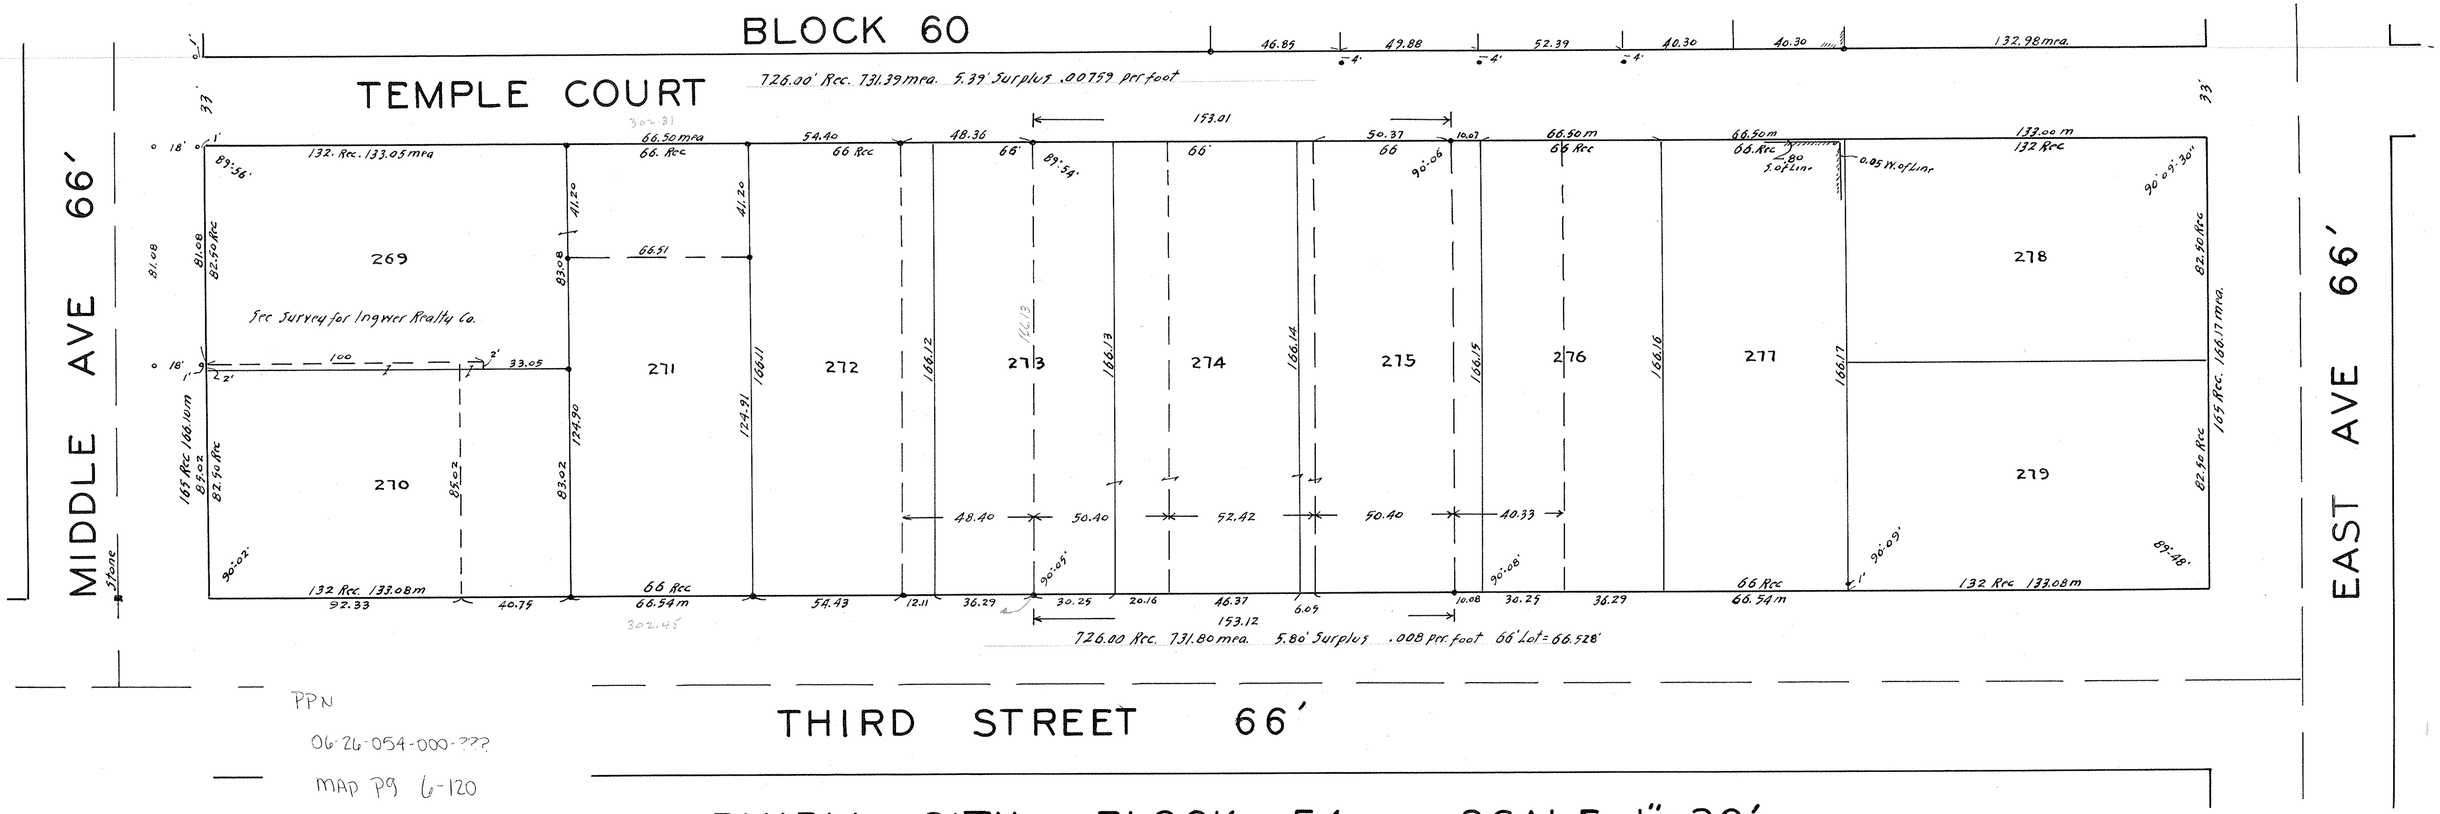
BLOCK 60
TEMPLE COURT
726.00' Rec. 731.39 mea. 5.39' Surplus .00759 per foot
MIDDLE AVE 66'
EAST AVE 66'
THIRD STREET 66'
269
270
271
272
273
274
275
276
277
278
279
See Survey for Ingwer Realty Co.
726.00 Rec. 731.80 mea. 5.80' Surplus .008 per foot 66' Lot = 66.528'
PPN
06-26-054-000-???
MAP Pg 6-120
ELYRIA CITY BLOCK 54 SCALE 1" = 30'
16-1284