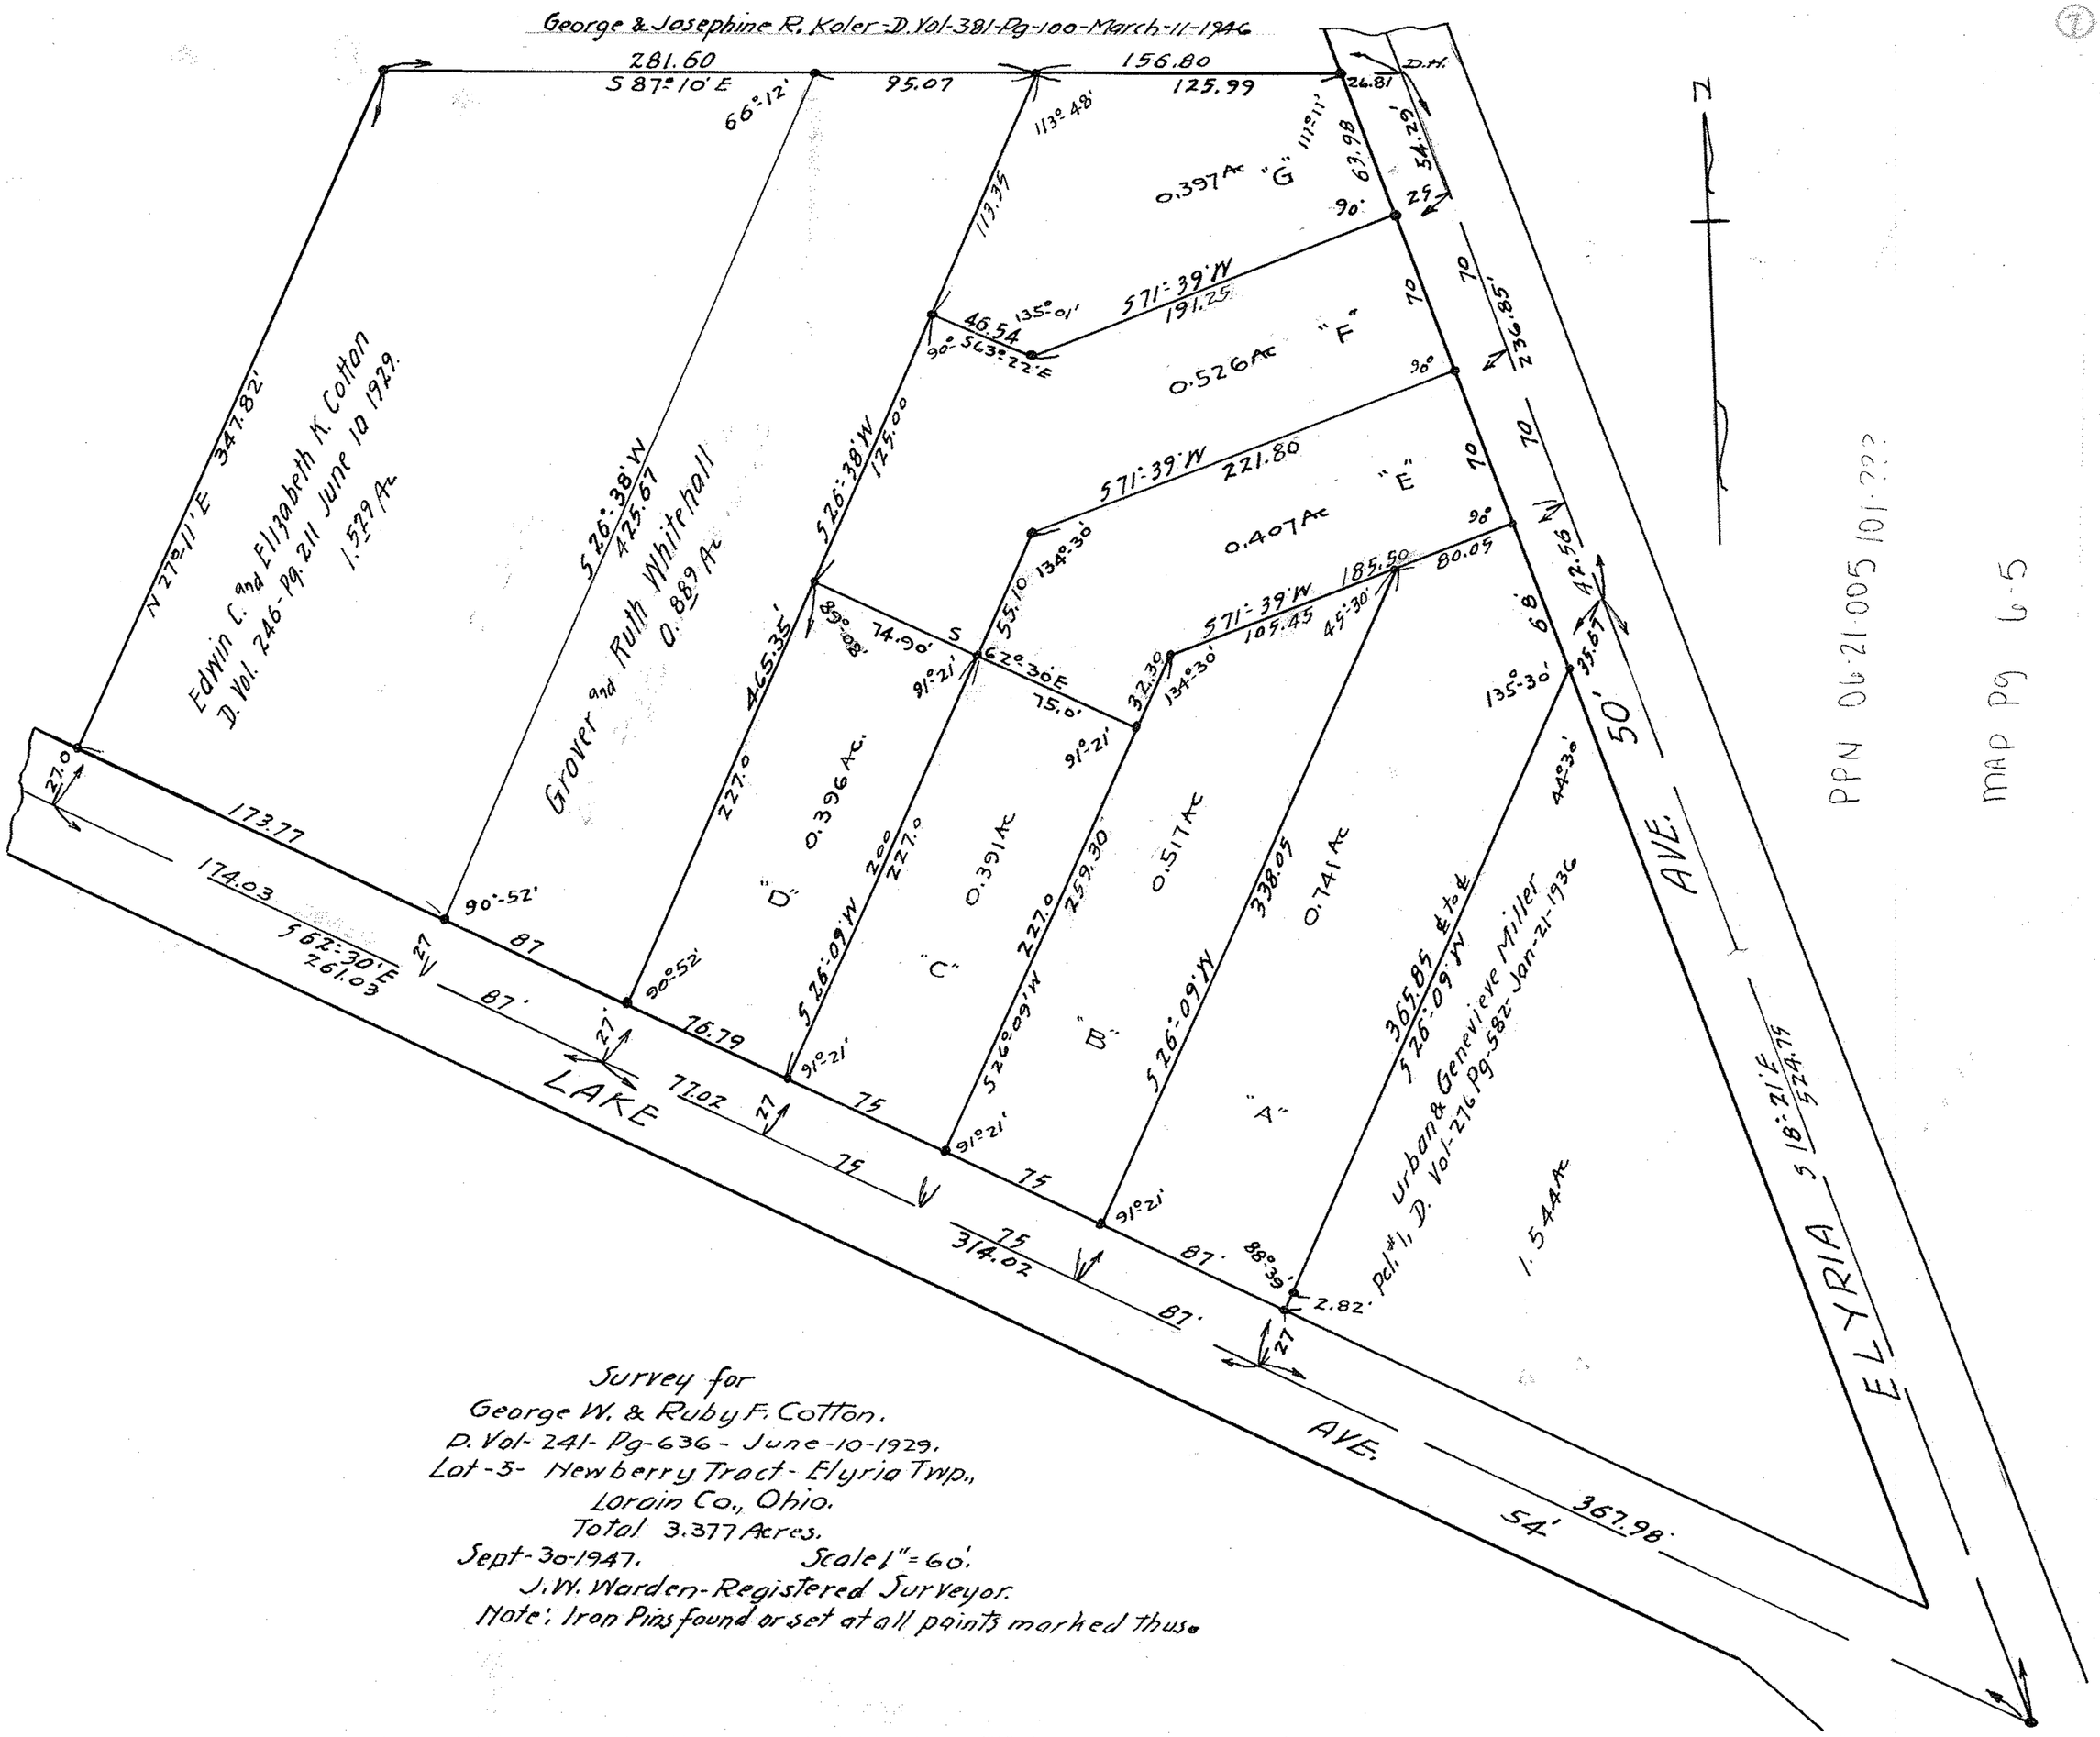

Survey for
George W. & Ruby F. Cotton.
D. Vol- 241- Pg-636 - June-10-1929.
Lot-5- Newberry Tract- Elyria Twp.,
Lorain Co., Ohio.
Total 3.377 Acres.
Sept-30-1947. Scale 1" = 60'.
J.W. Warden-Registered Surveyor.
Note: Iron Pins found or set at all points marked thus.

PPN 06-21-005 101-???

MAP Pg 6-5