Survey for
MRS. A. G. SMITH
Lot 6 Elywood No 1
Map Vol. 12 Pgs. 31-32
Elyria City Lorain Co. Ohio.
Scale 1" = 20' July 23, 1952.
J. W. Warden and Associates Surveyor's.

PPN 06-25-154-000-???

MAP PG 6-102

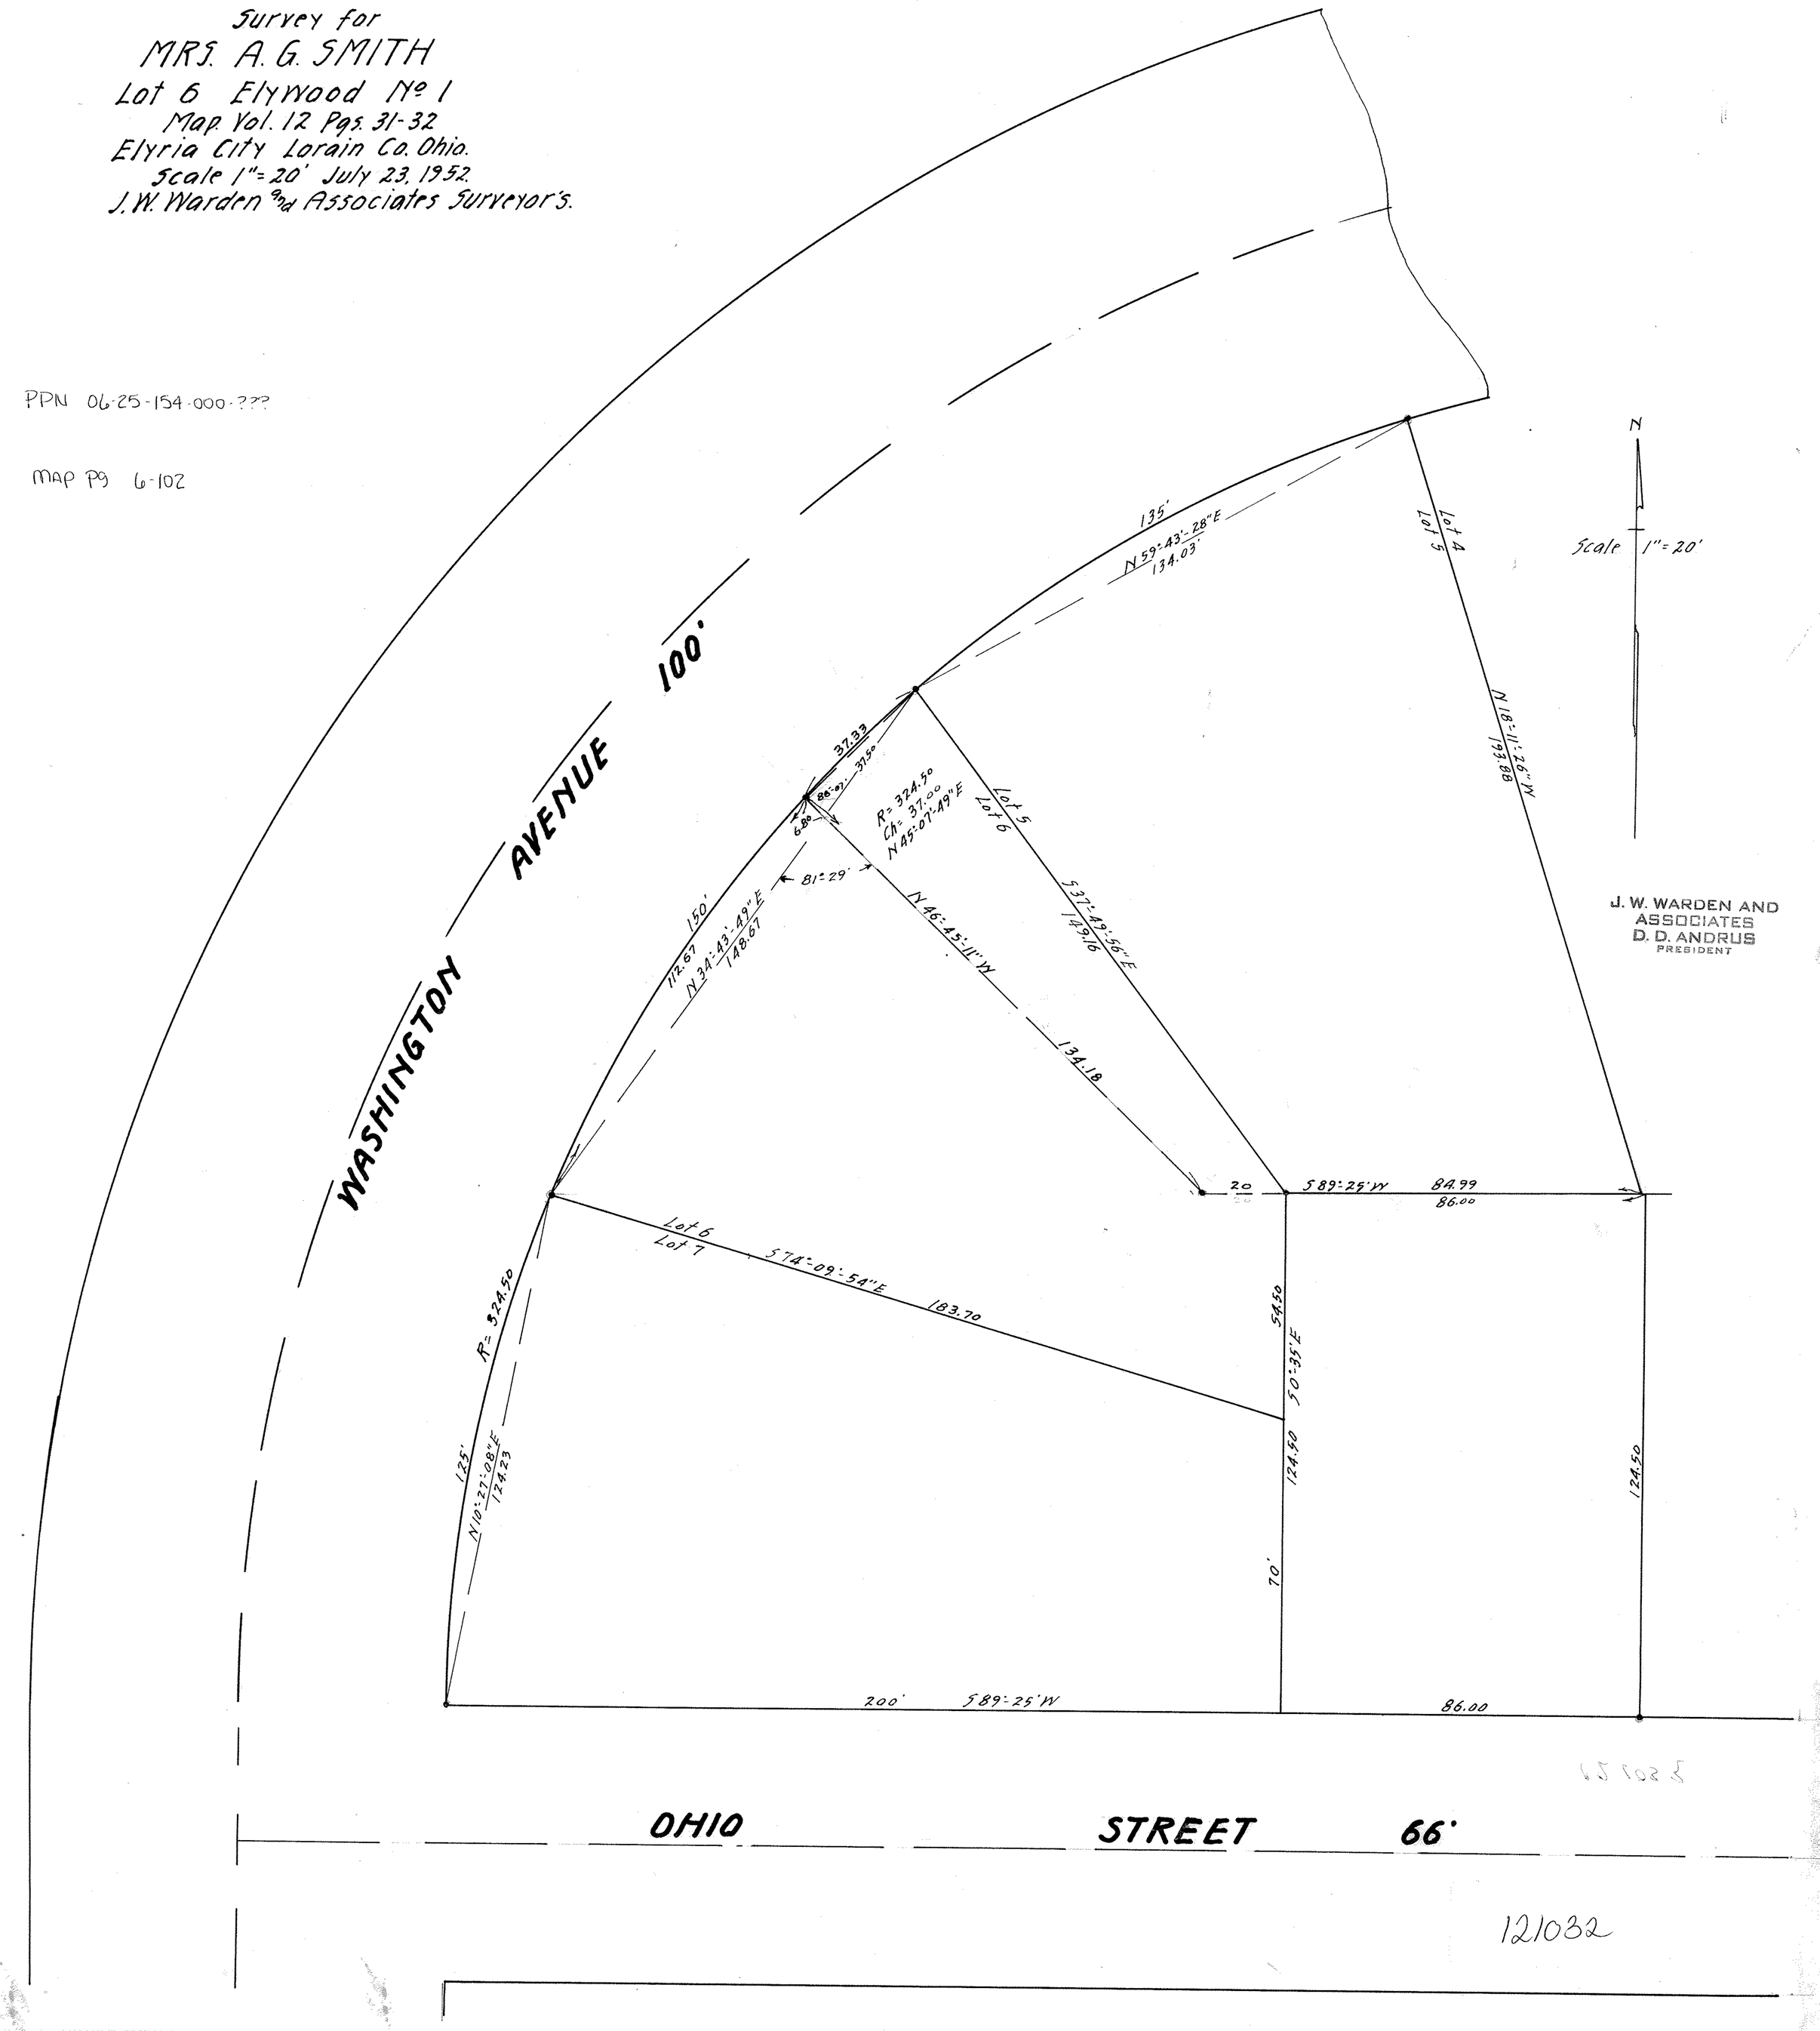

121032