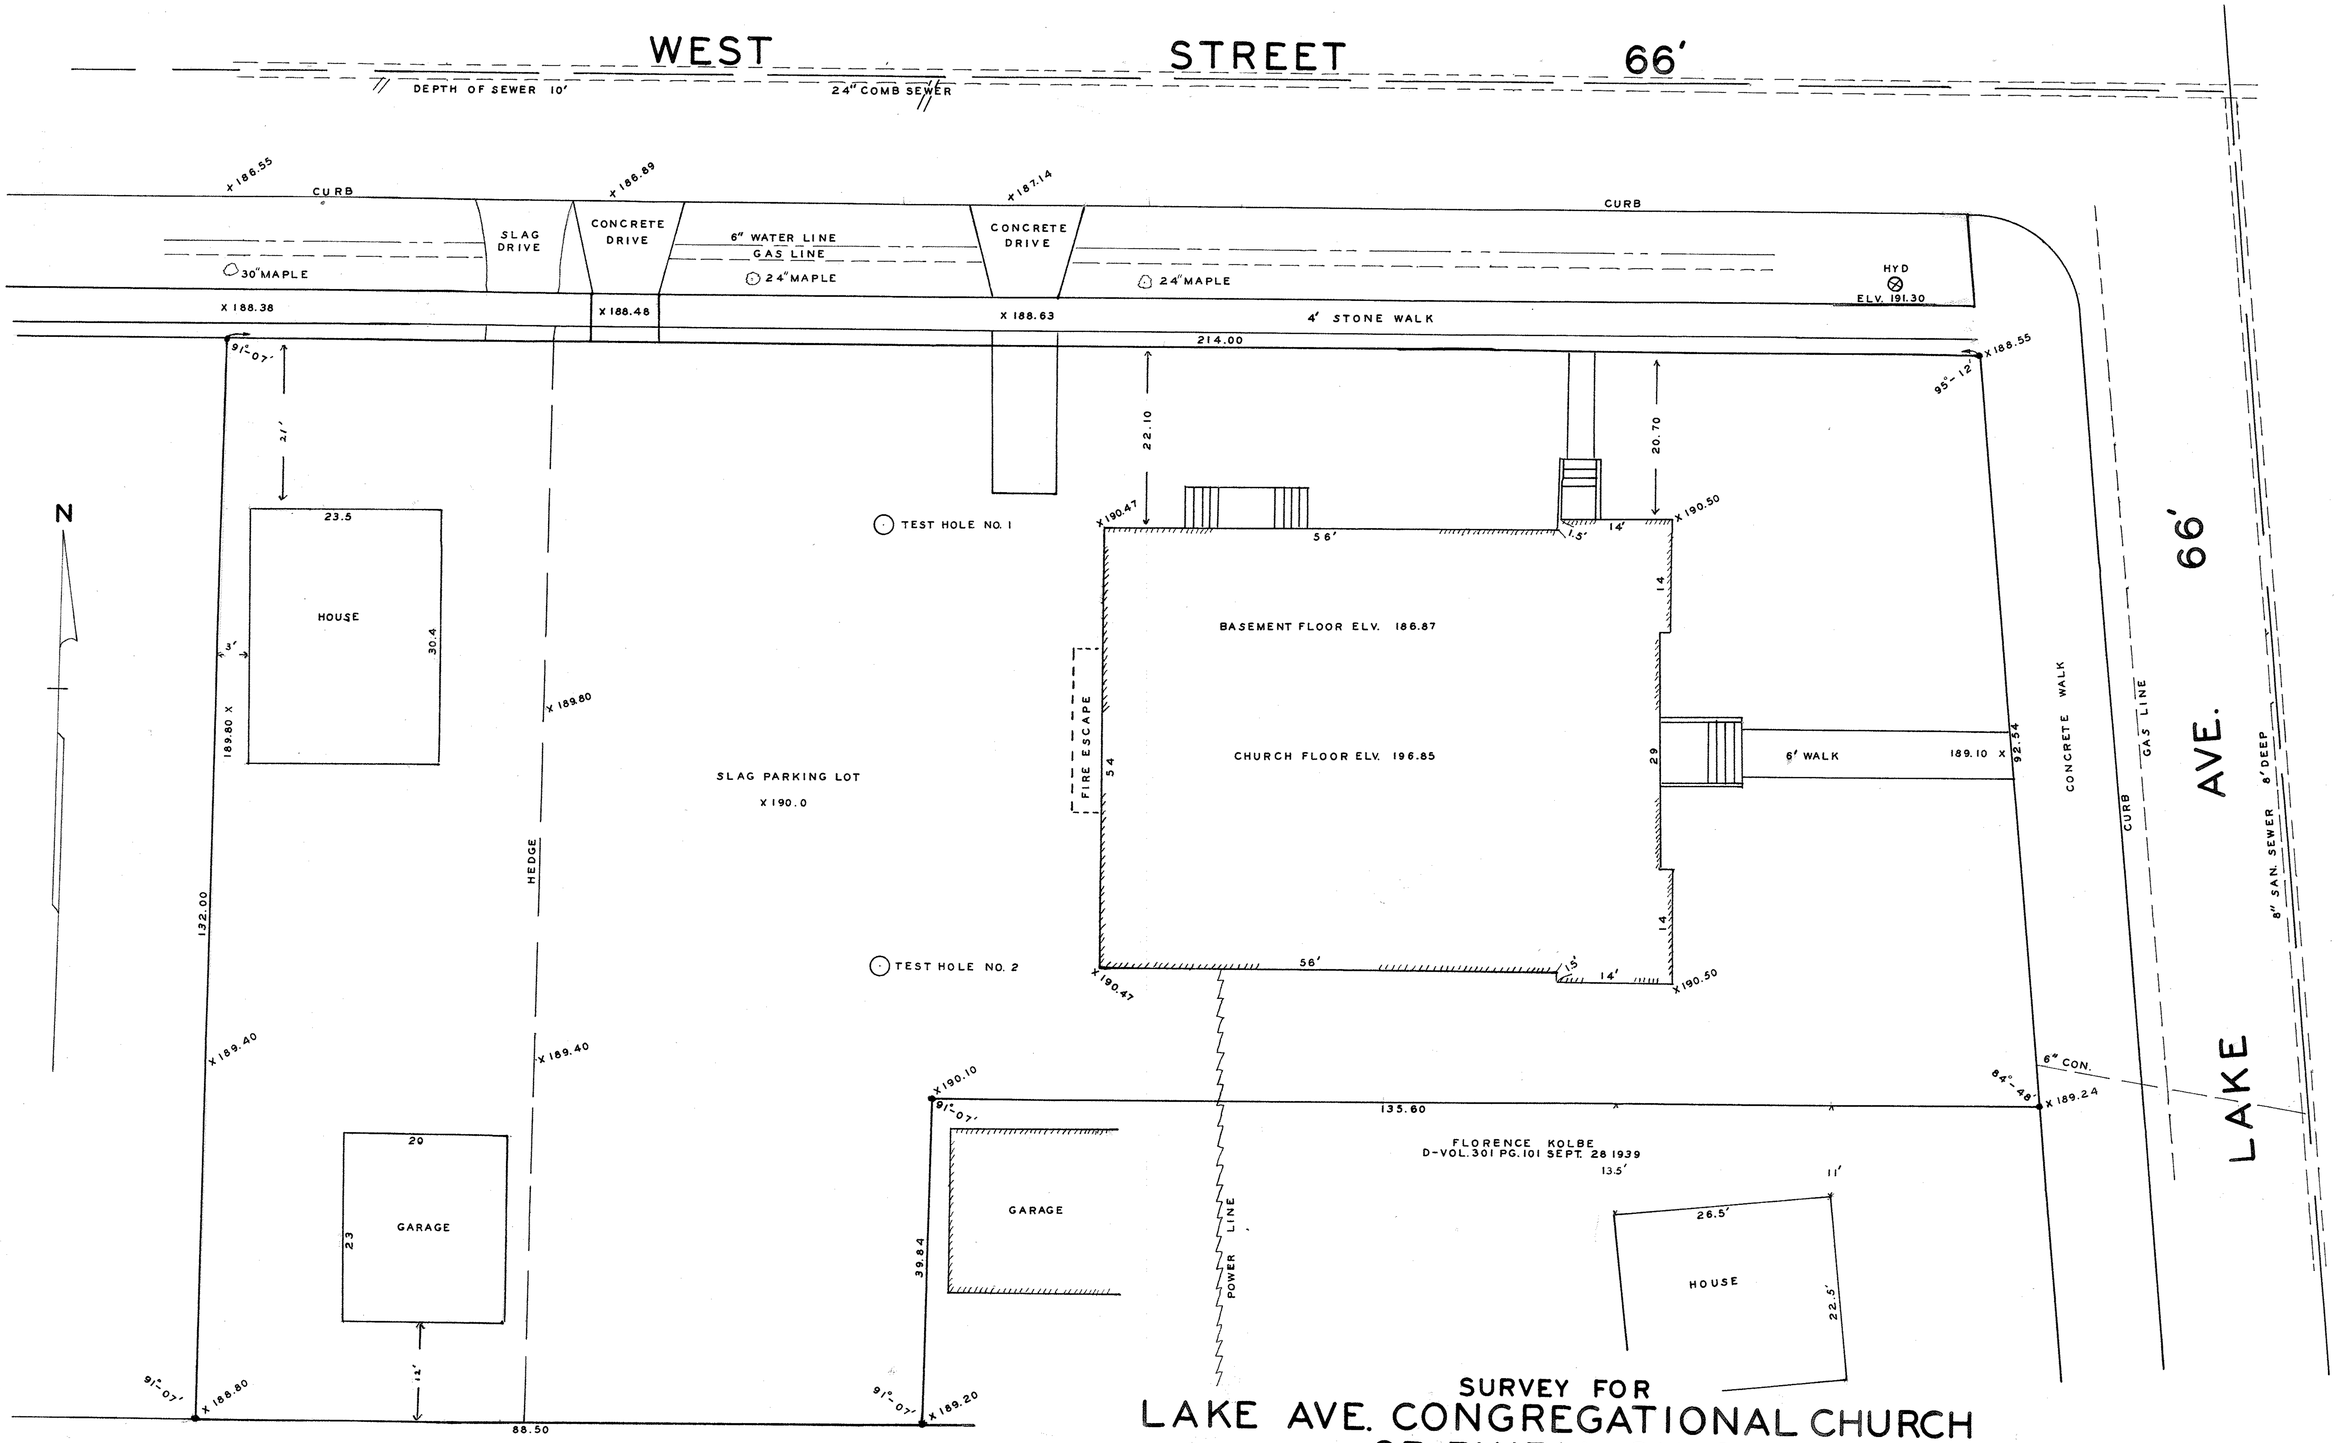

IRON PINS FOUND OR SET AT ALL POINTS THUS ●

PPN 06-24-089-000-009

MAP Pg 6-99

SURVEY FOR

LAKE AVE. CONGREGATIONAL CHURCH OF ELYRIA OHIO

D-VOL. 209 PG. 324 JUNE 3, 1925
D-VOL. 669 PG. 22 JULY 17, 1956
ORIGINAL LOT 89 WEST OF BLACK RIVER
ELYRIA CITY, LORAIN COUNTY, OHIO
SCALE 1" = 10' APRIL 30, 1957
J. W. WARDEN AND ASSOCIATES REG. SURVEYORS
405 ELYRIA BLOCK ELYRIA, OHIO

120024