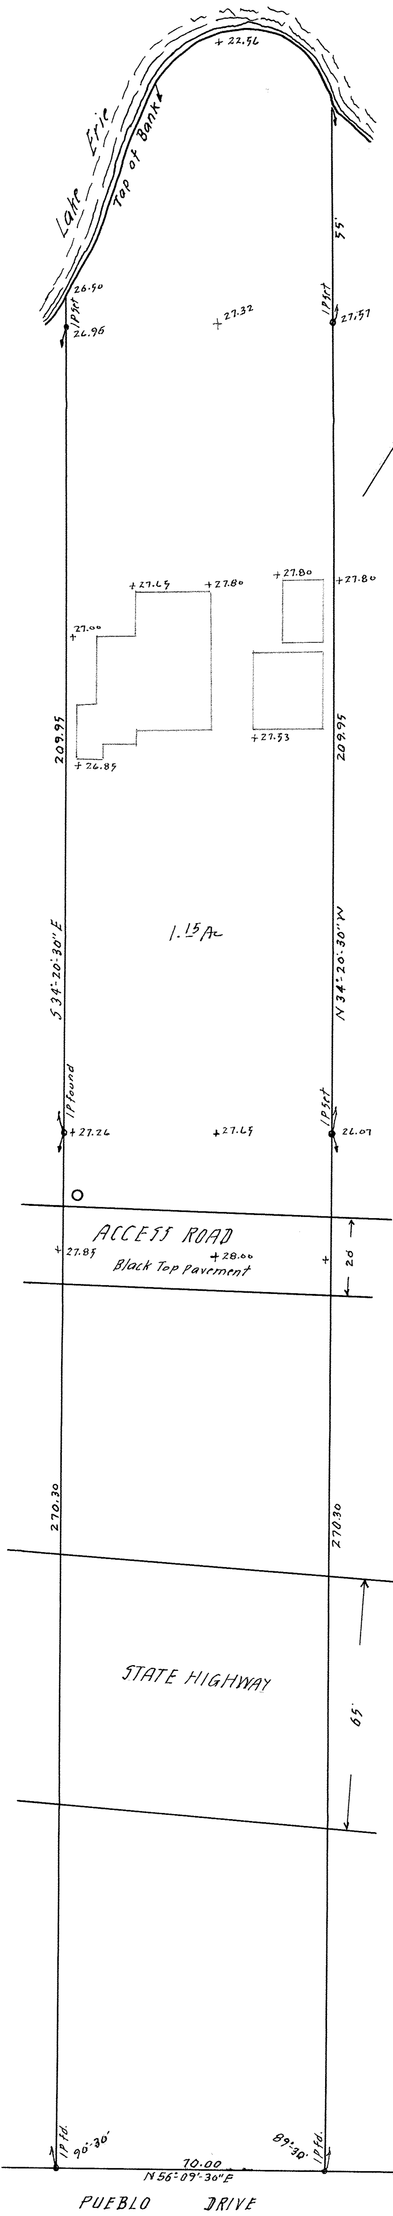

PUEBLO DRIVE

SURVEY LOCATION & TOPO MAP FOR
BERNARD - HARVEY - MARVIN EVENCHIK
D-Vol. 685 Pg. 512
Lot 21 Tract 2 Black River Township.
CITY OF LORAIN OHIO.
Scale 1" = 20' June 28 1968
D. D. Andrus and Associates Reg. Surveyors.

PPN 02-020-01-111-22

Map 83 02-020-A

401546