(3)

PPN 04-00-007-105-061
-037
025

MAP Pg 4-00-007-B

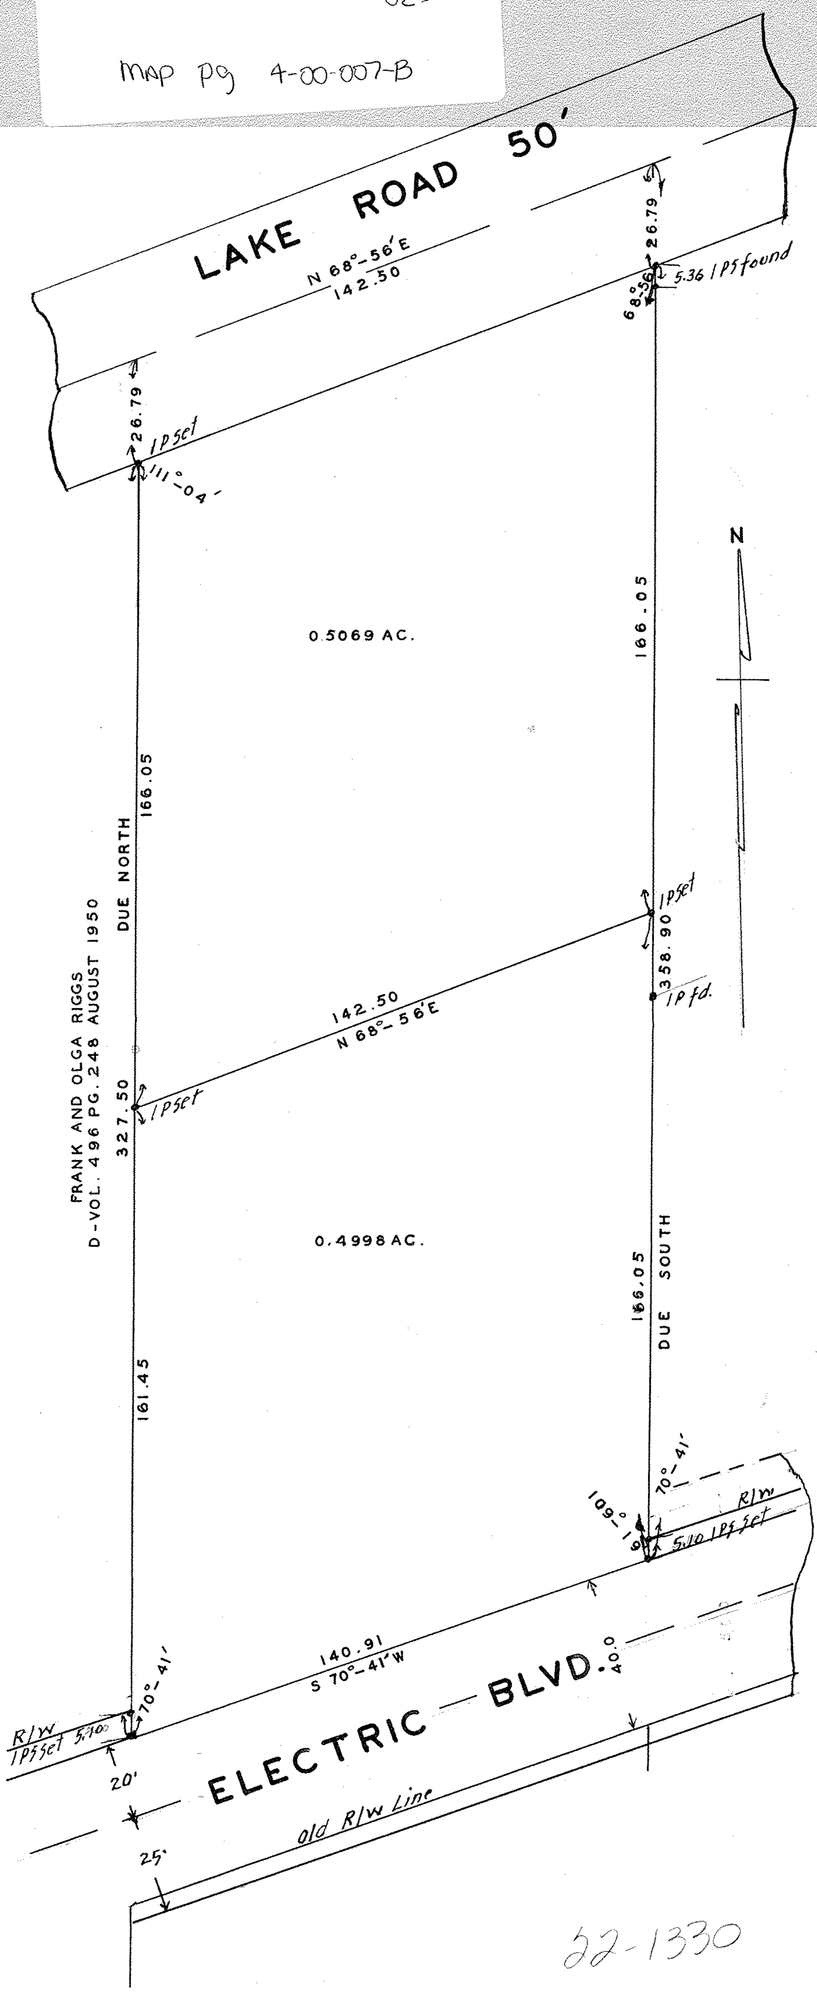

22-1330

SURVEY FOR
STEPHEN AND MARY DOJCSAK
D-VOL 579 PG 196 JULY 27, 1953
SECTION 7 AVON LAKE VILLAGE
LORAIN COUNTY OHIO
SCALE 1" = 30' APRIL 18, 1960
J. W. WARDEN AND ASSOCIATES REG SURVEYORS

By - D. D. Andrus

22-1330