


WEST BROAD STREET 99'

58-8

12" Water Main

B.M. Elev. 192.76 Hydrant N.W. Corner

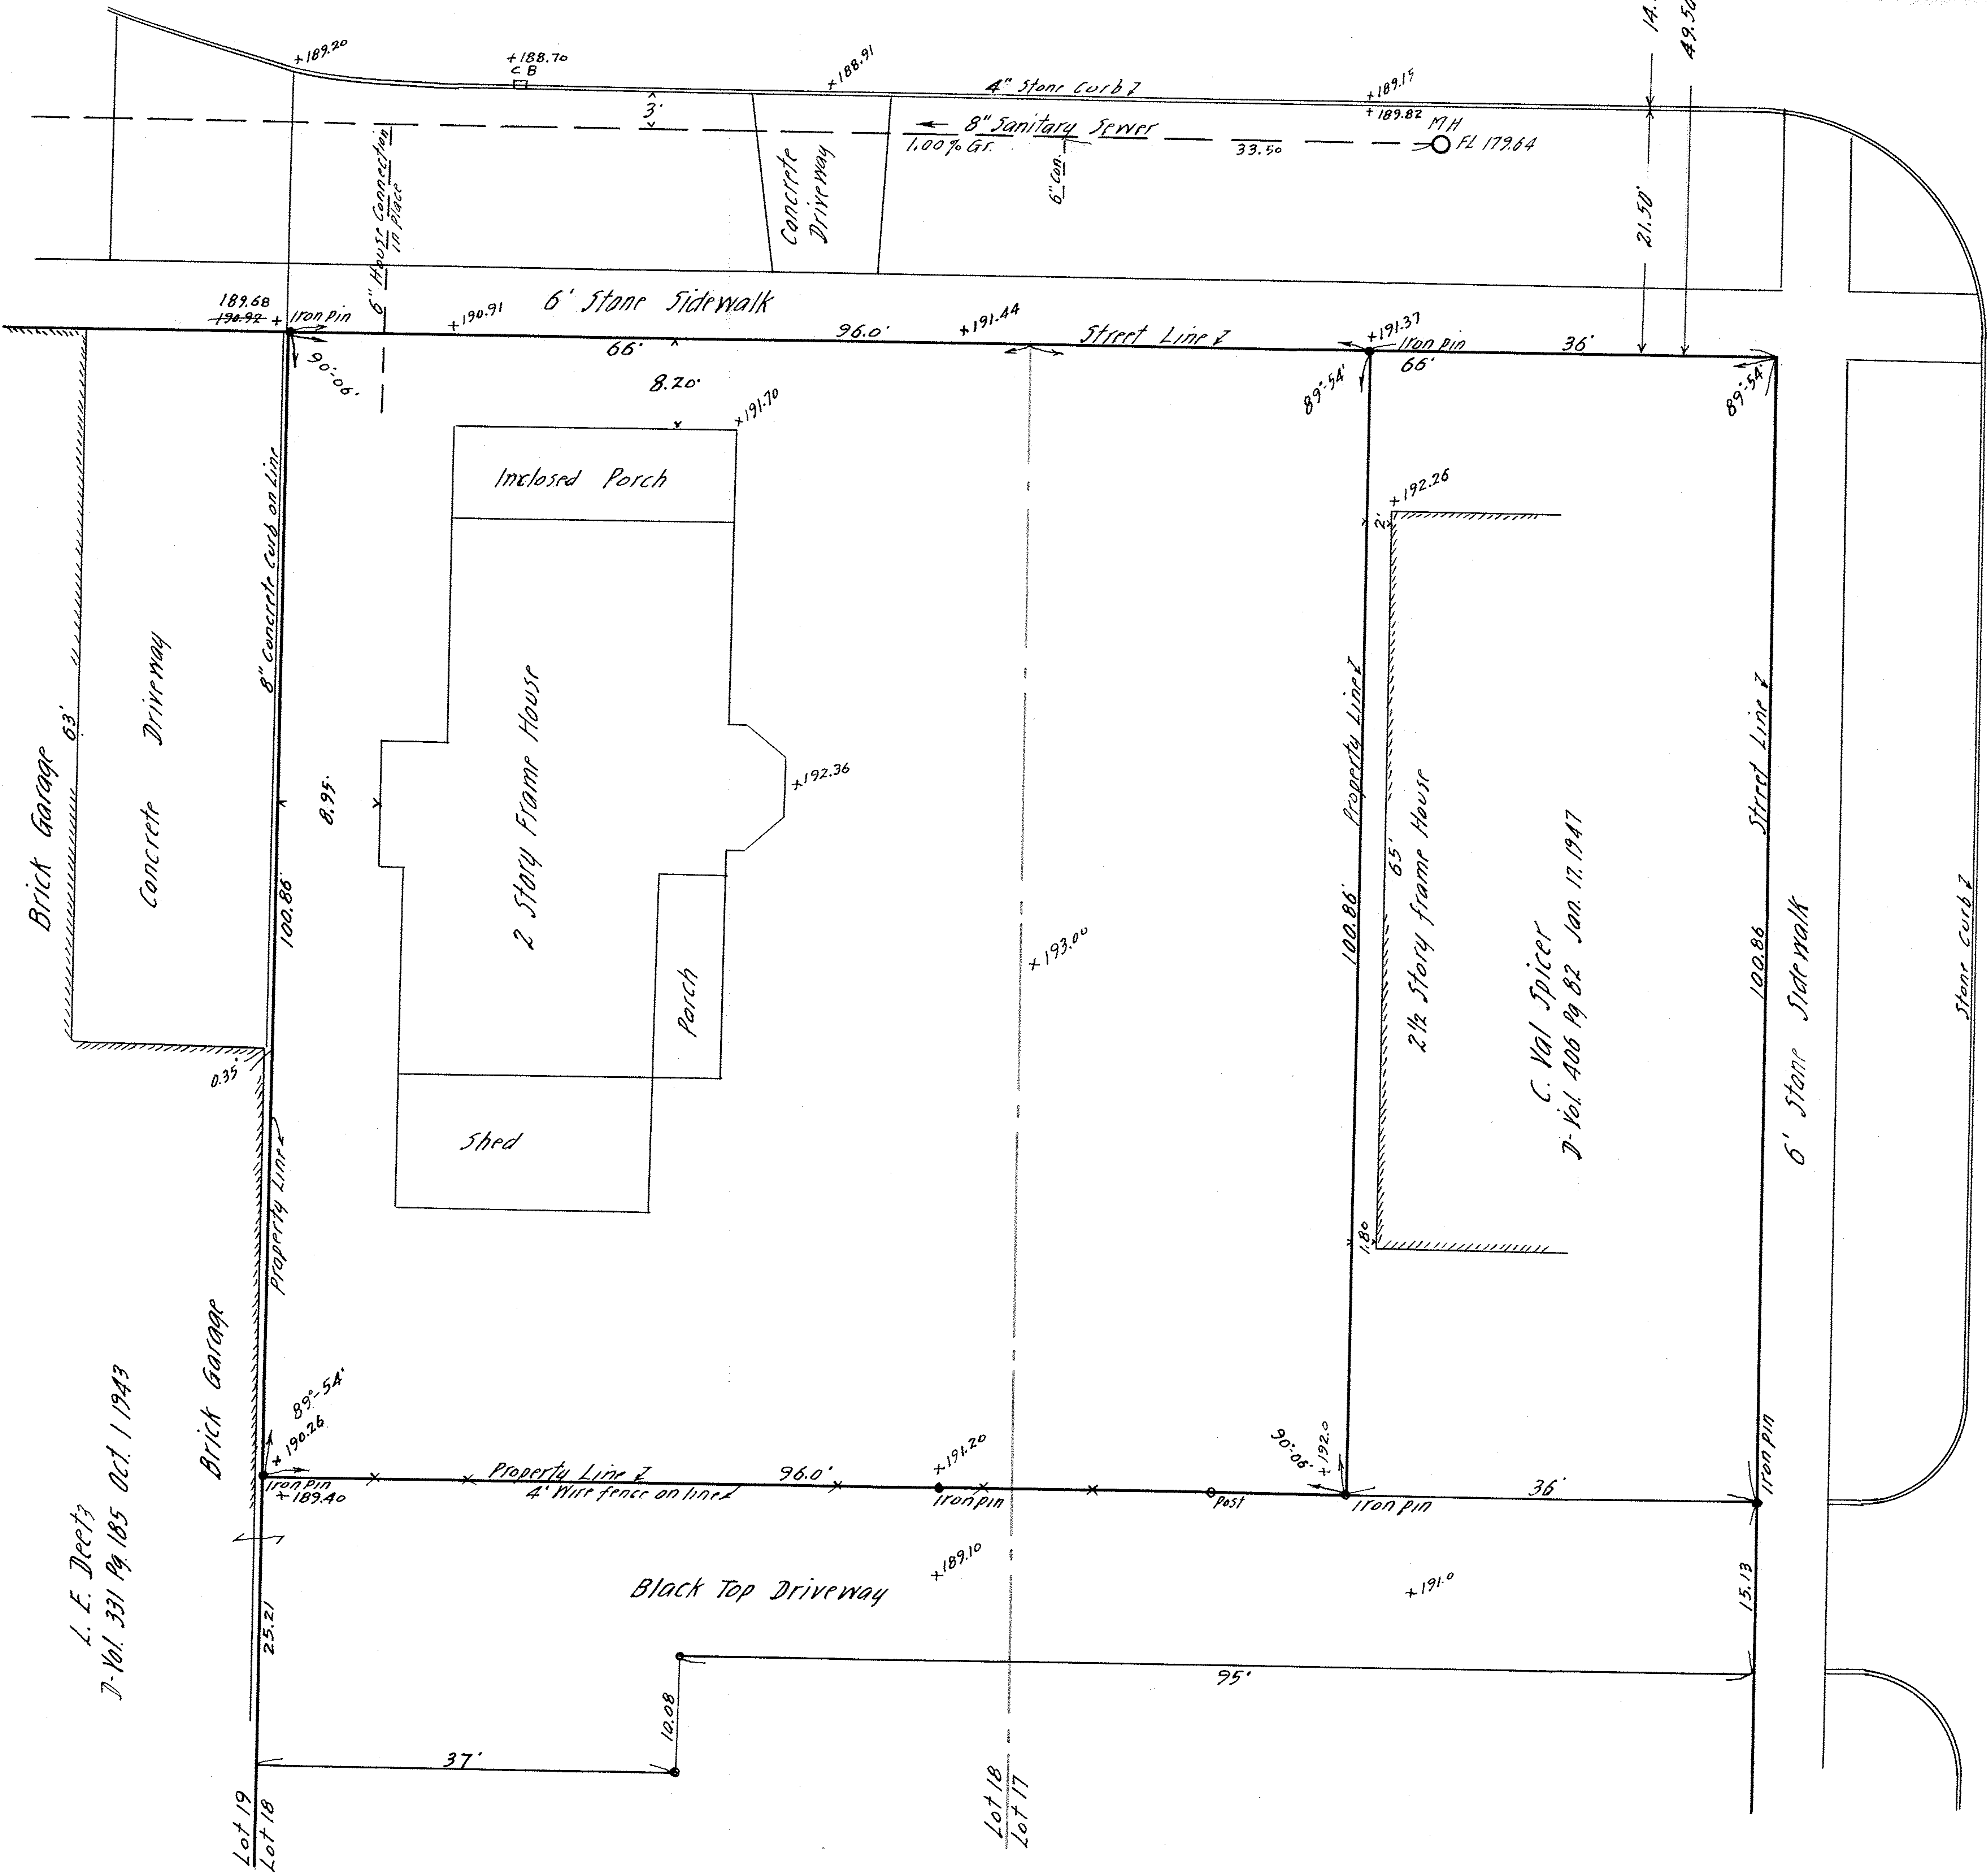

CHESTNUT STREET 66'

30052 A

L. E. Deetz
D-Vol. 331 Pg 185 Oct. 1 1943

C. Val Spicer
D-Vol. 400 Pg 82 Jan. 17 1947

SURVEY FOR

THE SALVATION ARMY INC.

D-VOL 350 PG. 466 FEB. 28, 1945

BLOCK 66 LOTS 17-18 ORIGINAL PLAT VOL. 3, PG. 14

ELYRIA CITY LORAIN COUNTY, OHIO

SCALE 1" = 10' DEC. 7, 1950.

J. W. WARDEN, CIVIL ENGINEER.

PPN 06-26-066-000-015

MAP Pg 6-118