


SOUTH MAIN STREET

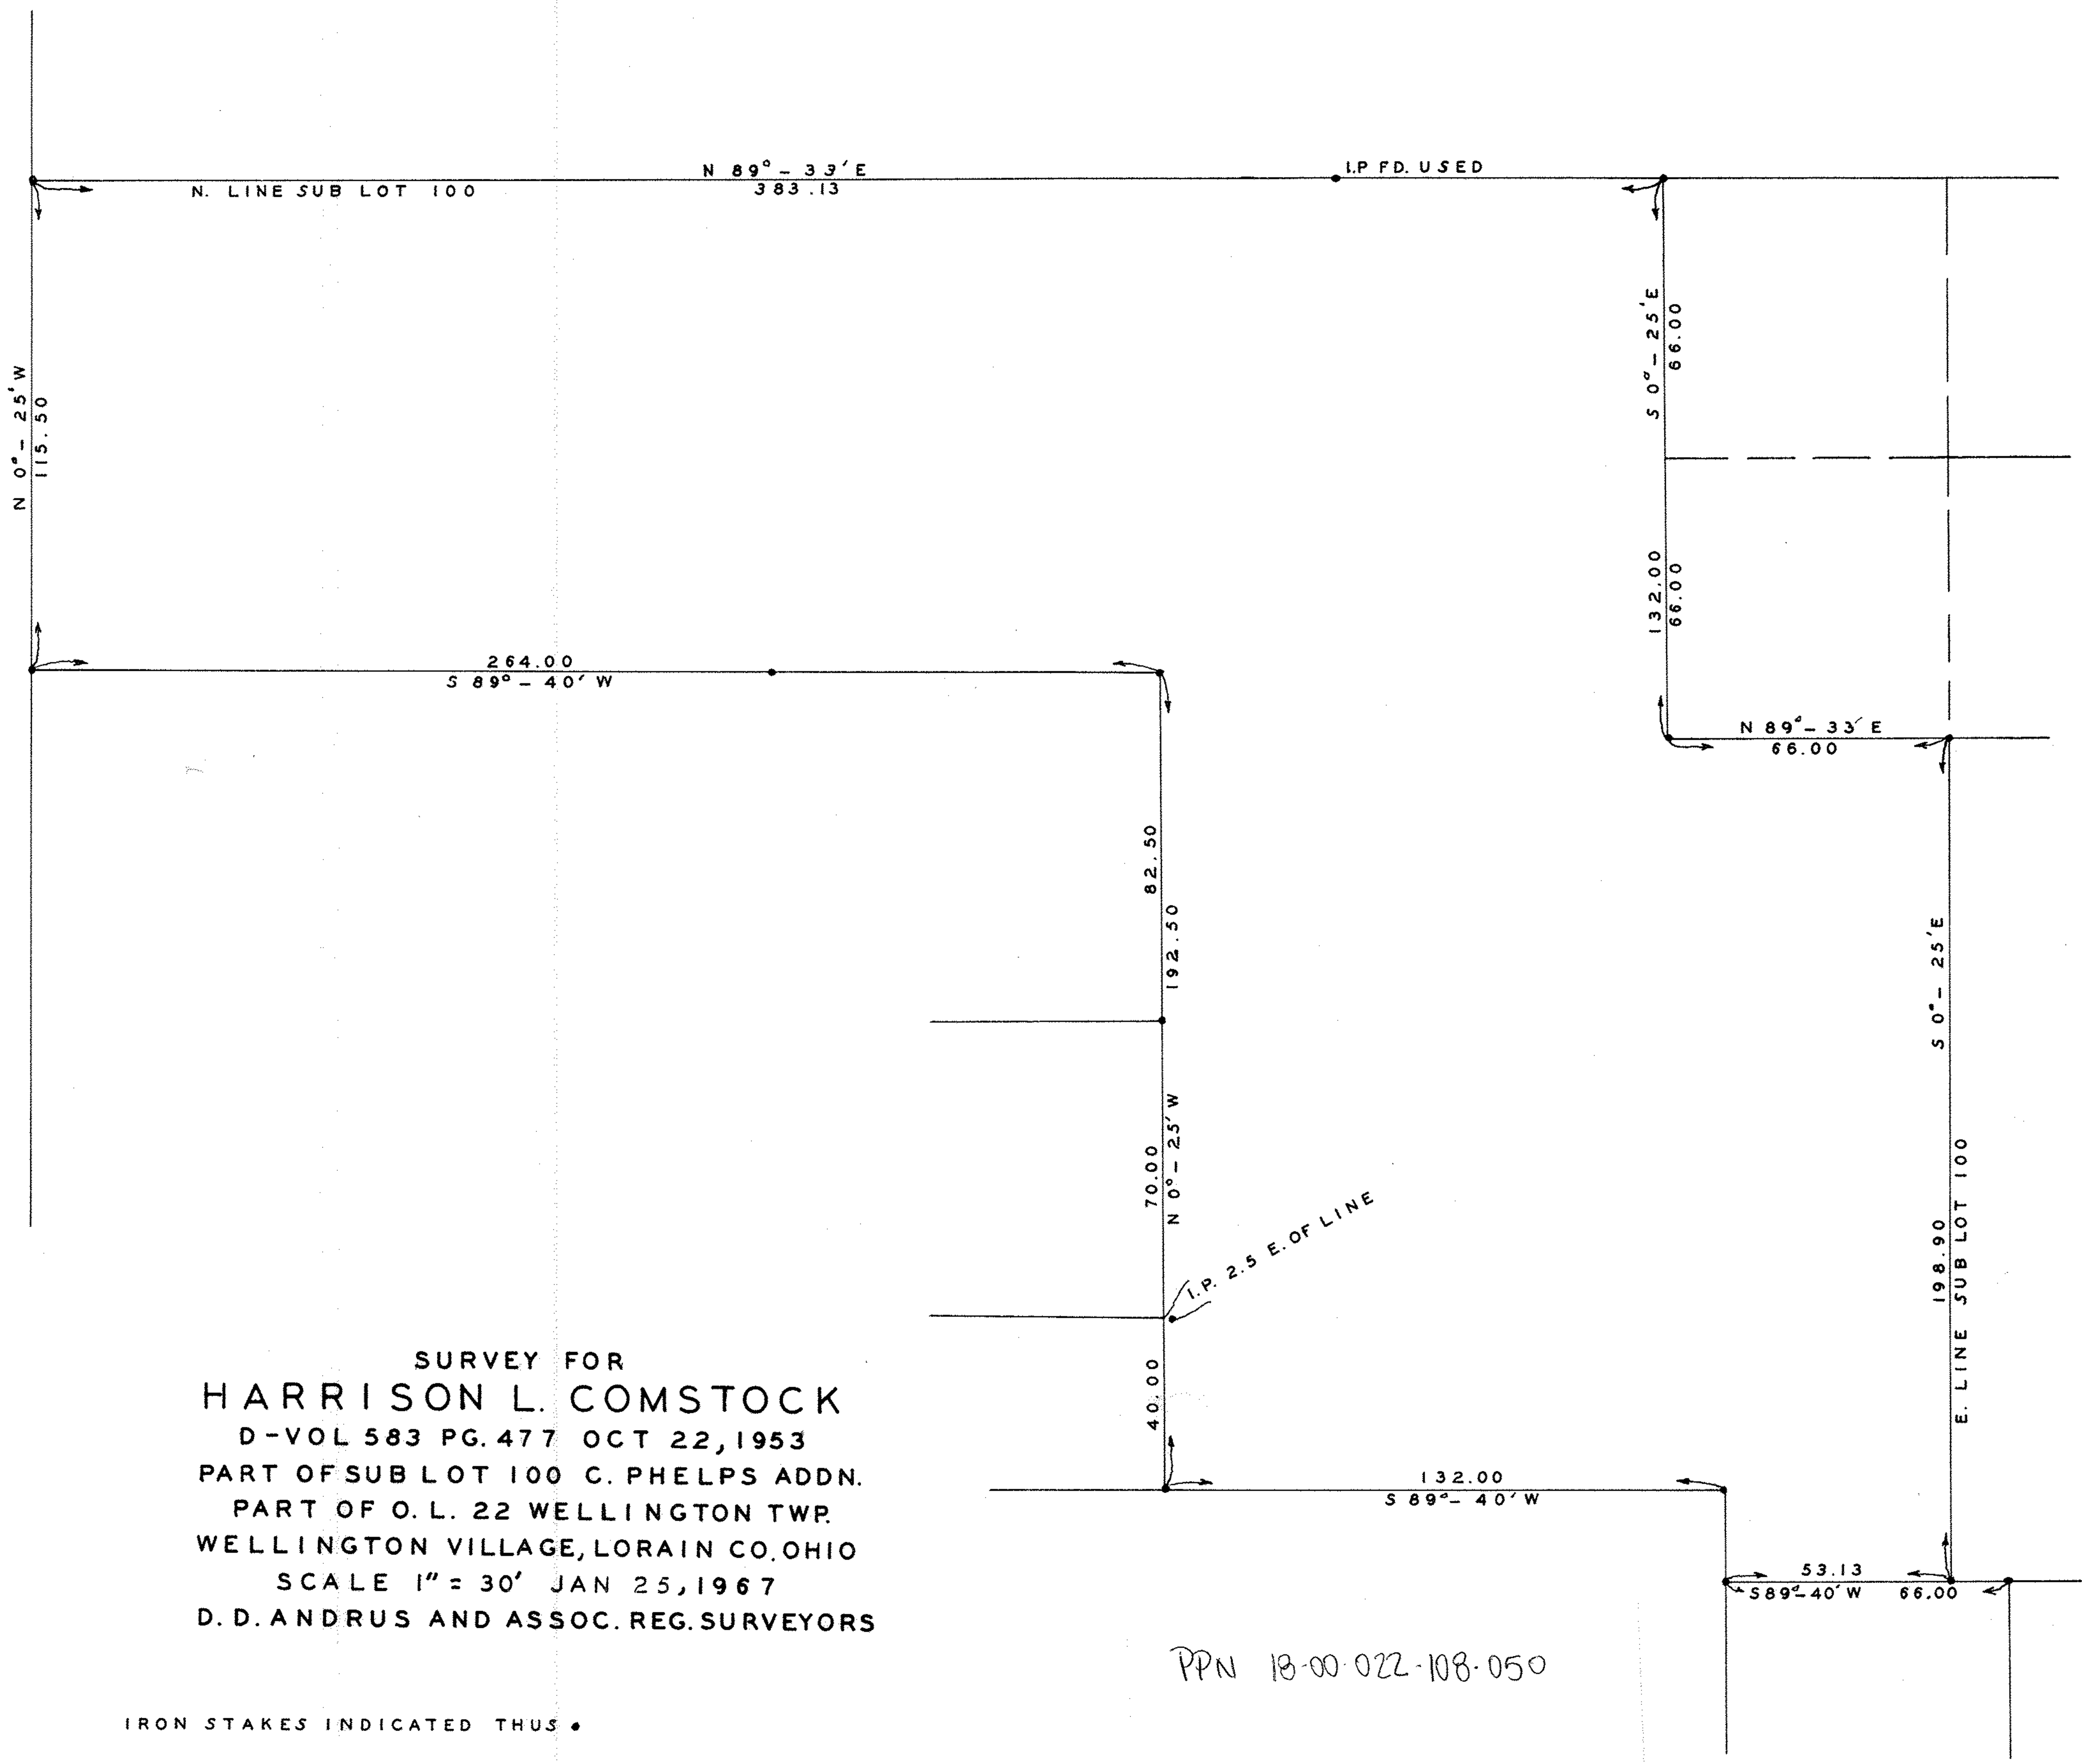

SURVEY FOR
HARRISON L. COMSTOCK
 D-VOL 583 PG. 477 OCT 22, 1953
 PART OF SUB LOT 100 C. PHELPS ADDN.
 PART OF O. L. 22 WELLINGTON TWP.
 WELLINGTON VILLAGE, LORAIN CO. OHIO
 SCALE 1" = 30' JAN 25, 1967
 D. D. ANDRUS AND ASSOC. REG. SURVEYORS

IRON STAKES INDICATED THUS •

17-1486

PPN 18-00-022-108-050

MAP PG 18-00-022-C