③

17-1486

SURVEY FOR
VESTA AND BELLE CLISBY
SUB LOTS 100-101-102-103-104-105-106-107
C. PHELPS ADDN MAP VOL. 3 PG. 96
PART OF ORIGINAL LOT 22 WELLINGTON TWP.
WELLINGTON VILLAGE LORAIN CO. OHIO
SCALE 1" = 20' SEPT. 13, 1965
D.D. ANDRUS AND ASSOCIATES REG. SURVEYORS

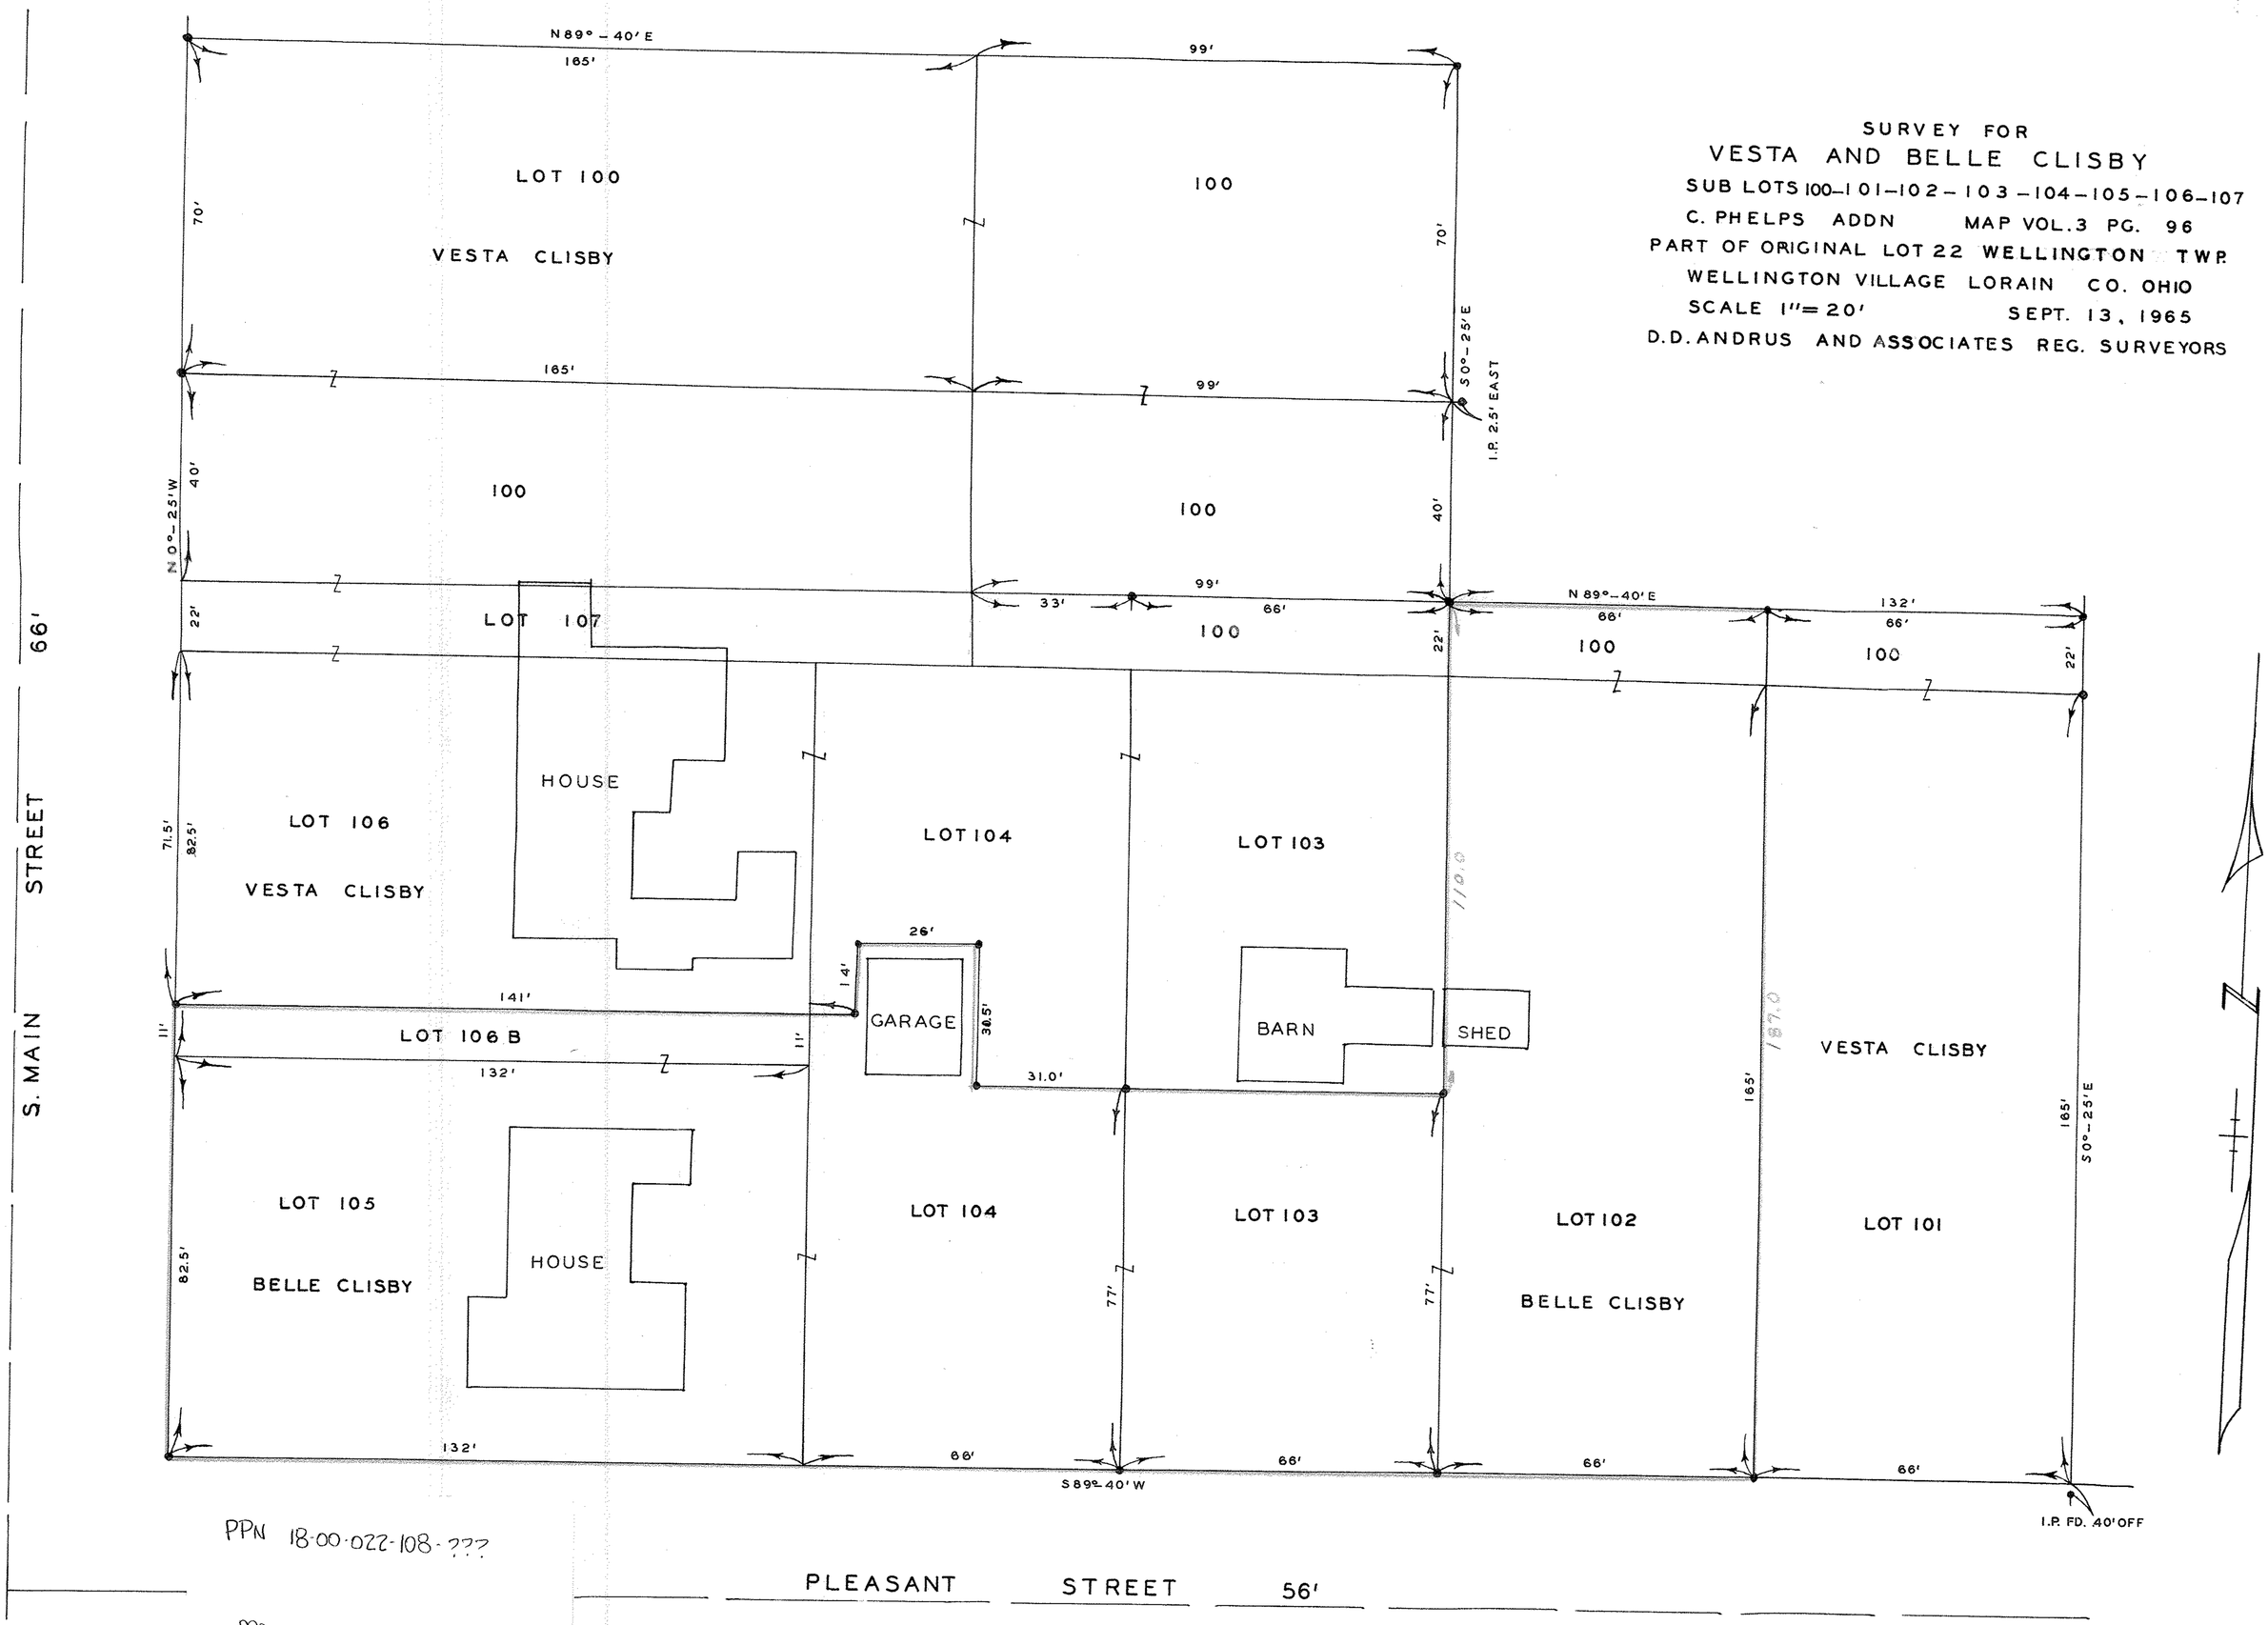

PPN 18-00-022-108-???

MAP PG 18-00-022-C

17-1486-2