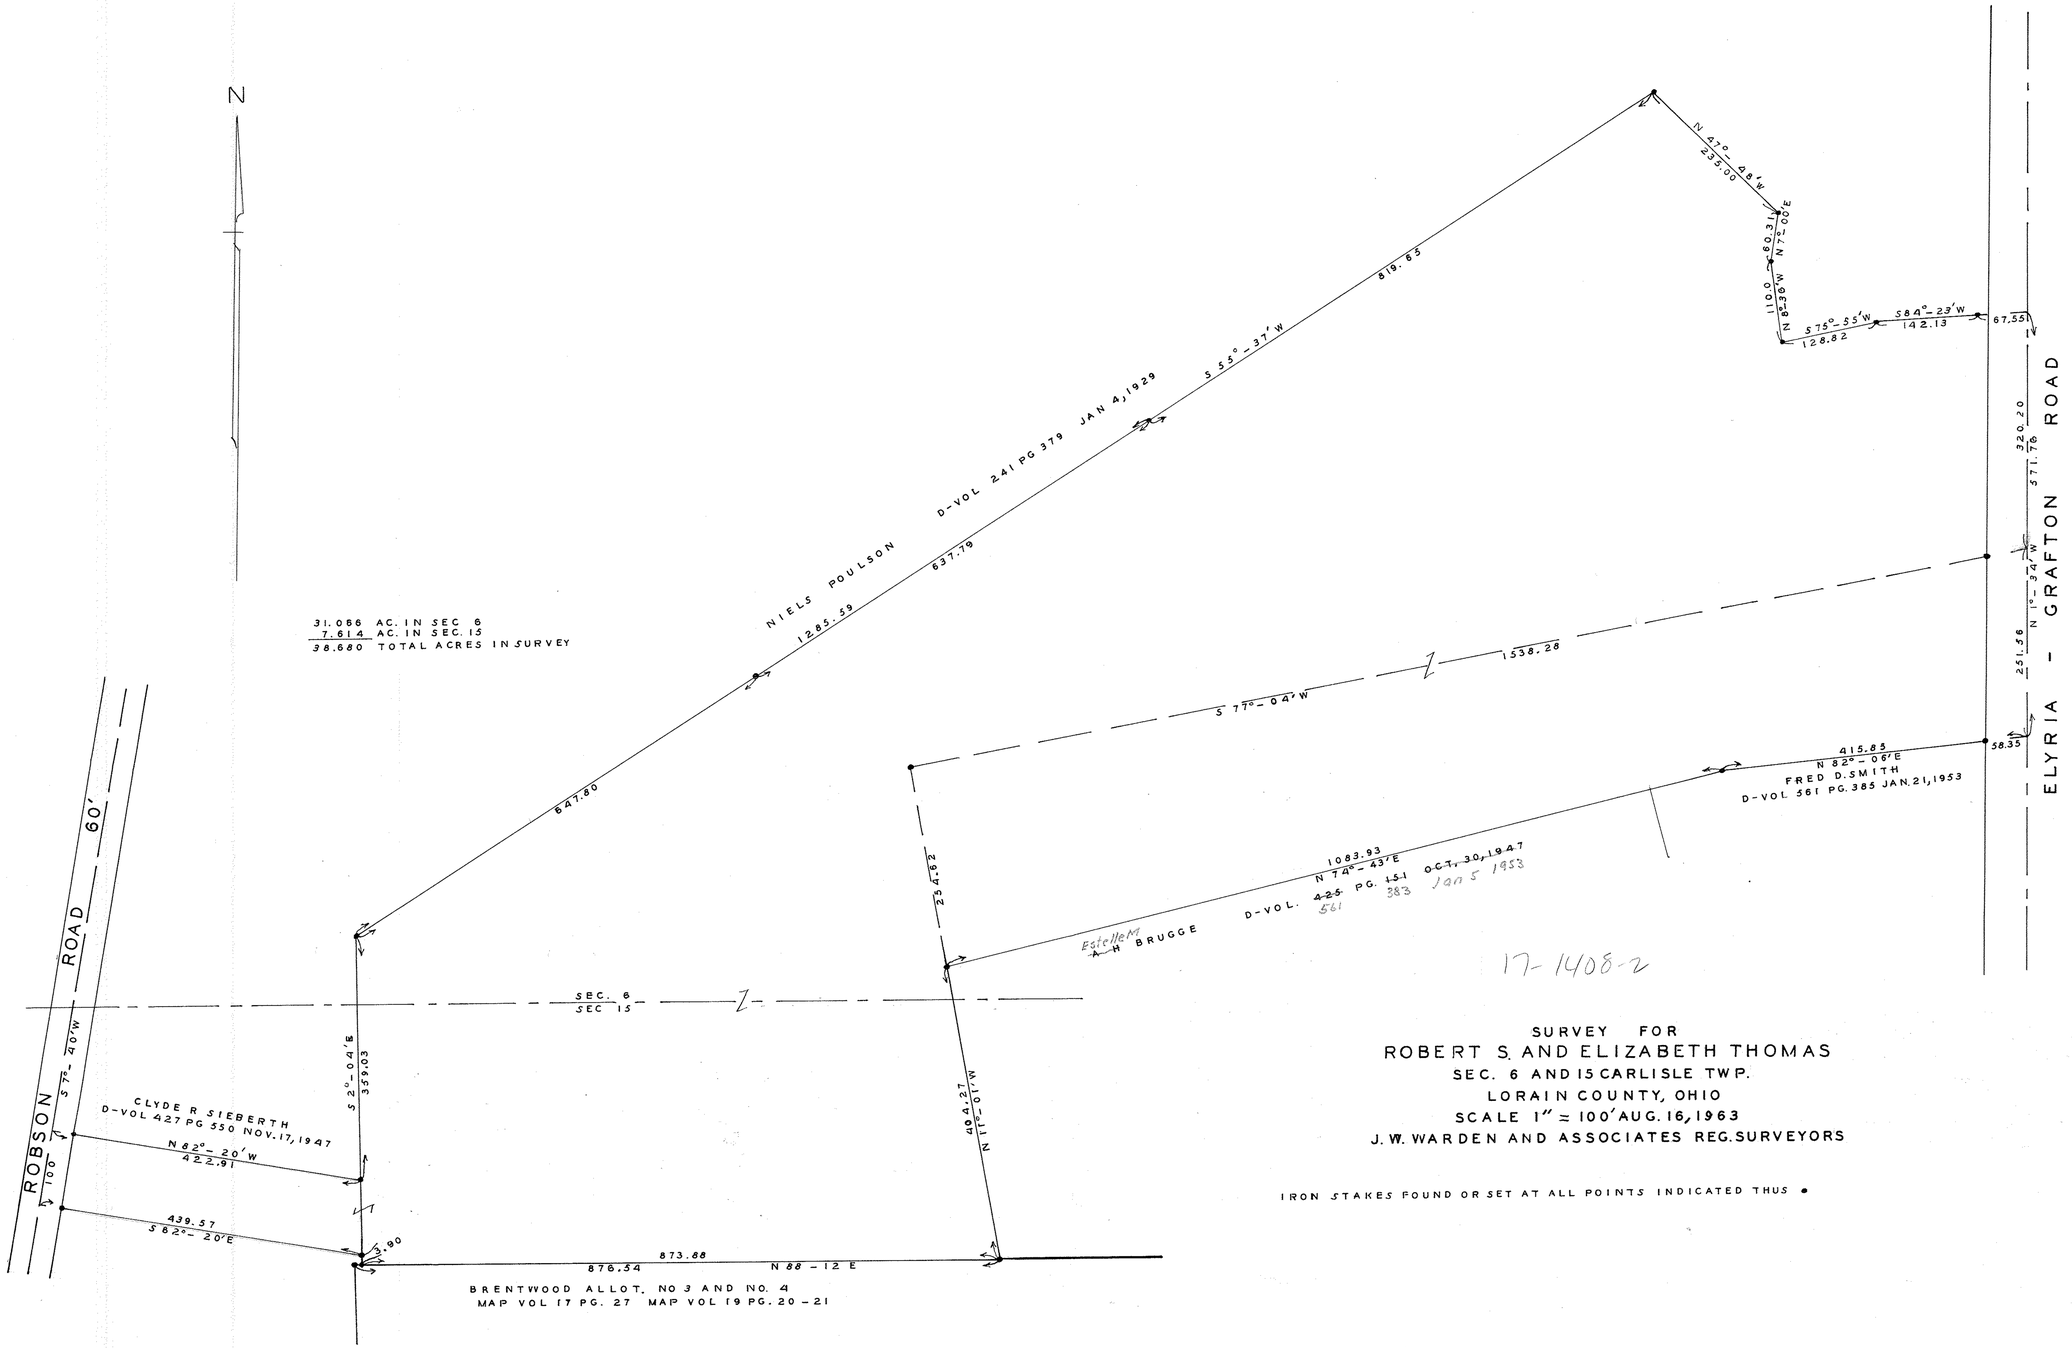


17-1408-2

SURVEY FOR
ROBERT S. AND ELIZABETH THOMAS
SEC. 6 AND 15 CARLISLE TWP.
LORAIN COUNTY, OHIO
SCALE 1" = 100' AUG. 16, 1963
J. W. WARDEN AND ASSOCIATES REG. SURVEYORS

IRON STAKES FOUND OR SET AT ALL POINTS INDICATED THUS •

PPN 10-00-004-126-777

MAP PG 10-00-006-G