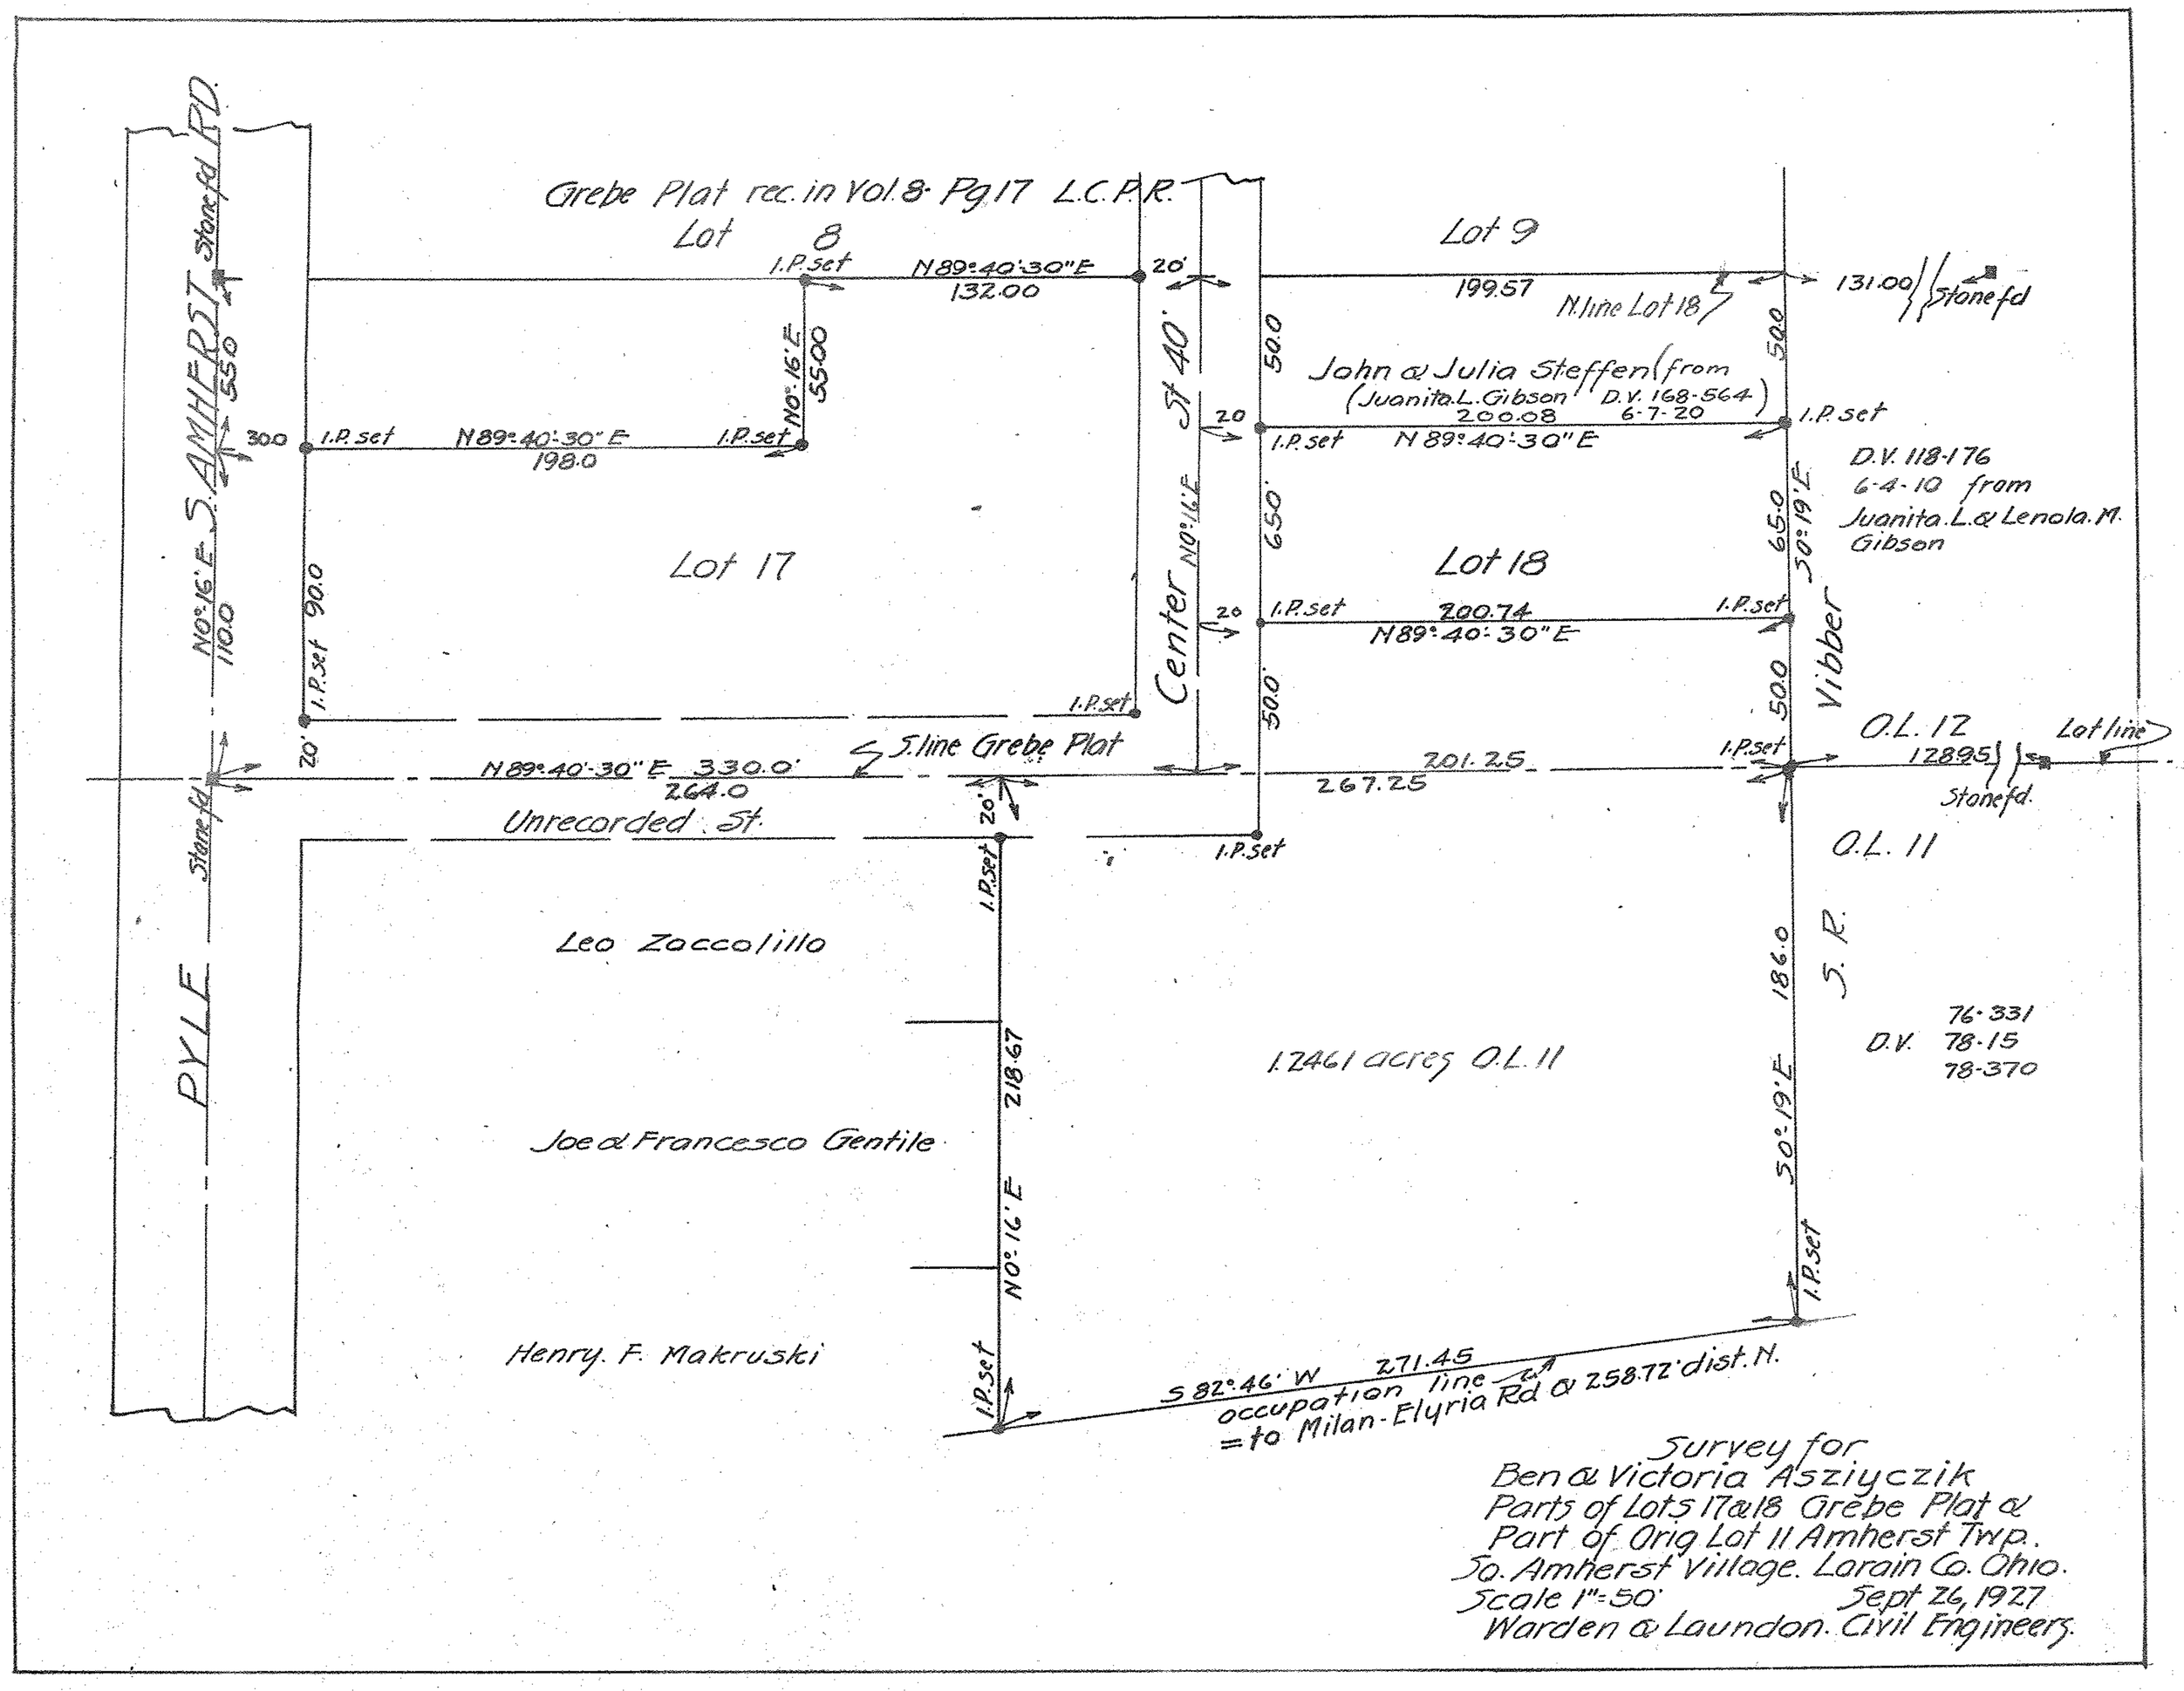

Grebe Plat rec. in Vol. 8 Pg. 17 L.C.P.R.
Lot 8
Lot 9
Lot 17
Lot 18
S. AMHERST RD.
PYLE
Stone fd
I.P. set
N 89°40'30" E
132.00
20'
199.57
N. line Lot 18
131.00
Stone fd
John & Julia Steffen (from (Juanita L. Gibson D.V. 168-564 6-7-20)
200.08
N 89°40'30" E
D.V. 118-176 6-4-10 from Juanita L. & Lenola M. Gibson
N 89°40'30" E
198.0
N 0°16' E
55.00
30.0
55.0
90.0
110.0
Center St 40'
N 0°16' E
65.0
50.0
200.74
N 89°40'30" E
S 0°19' E
Vibber
S. line Grebe Plat
N 89°40'30" E 330.0'
264.0
201.25
267.25
O.L. 12
128.95
Lot line
Stone fd.
Unrecorded St.
O.L. 11
Leo Zaccolillo
S. R.
186.0
D.V. 76-331 78-15 78-370
1.2461 acres O.L. 11
218.67
Joe & Francesco Gentile
N 0°16' E
S 0°19' E
Henry F. Makruski
S 82°46' W 271.45
occupation line
= to Milan-Elyria Rd & 258.72' dist. N.
Survey for
Ben & Victoria Asziyczik
Parts of Lots 17 & 18 Grebe Plat &
Part of Orig Lot 11 Amherst Twp.
So. Amherst Village. Lorain Co. Ohio.
Scale 1" = 50'
Sept 26, 1927
Warden & Laundon. Civil Engineers.