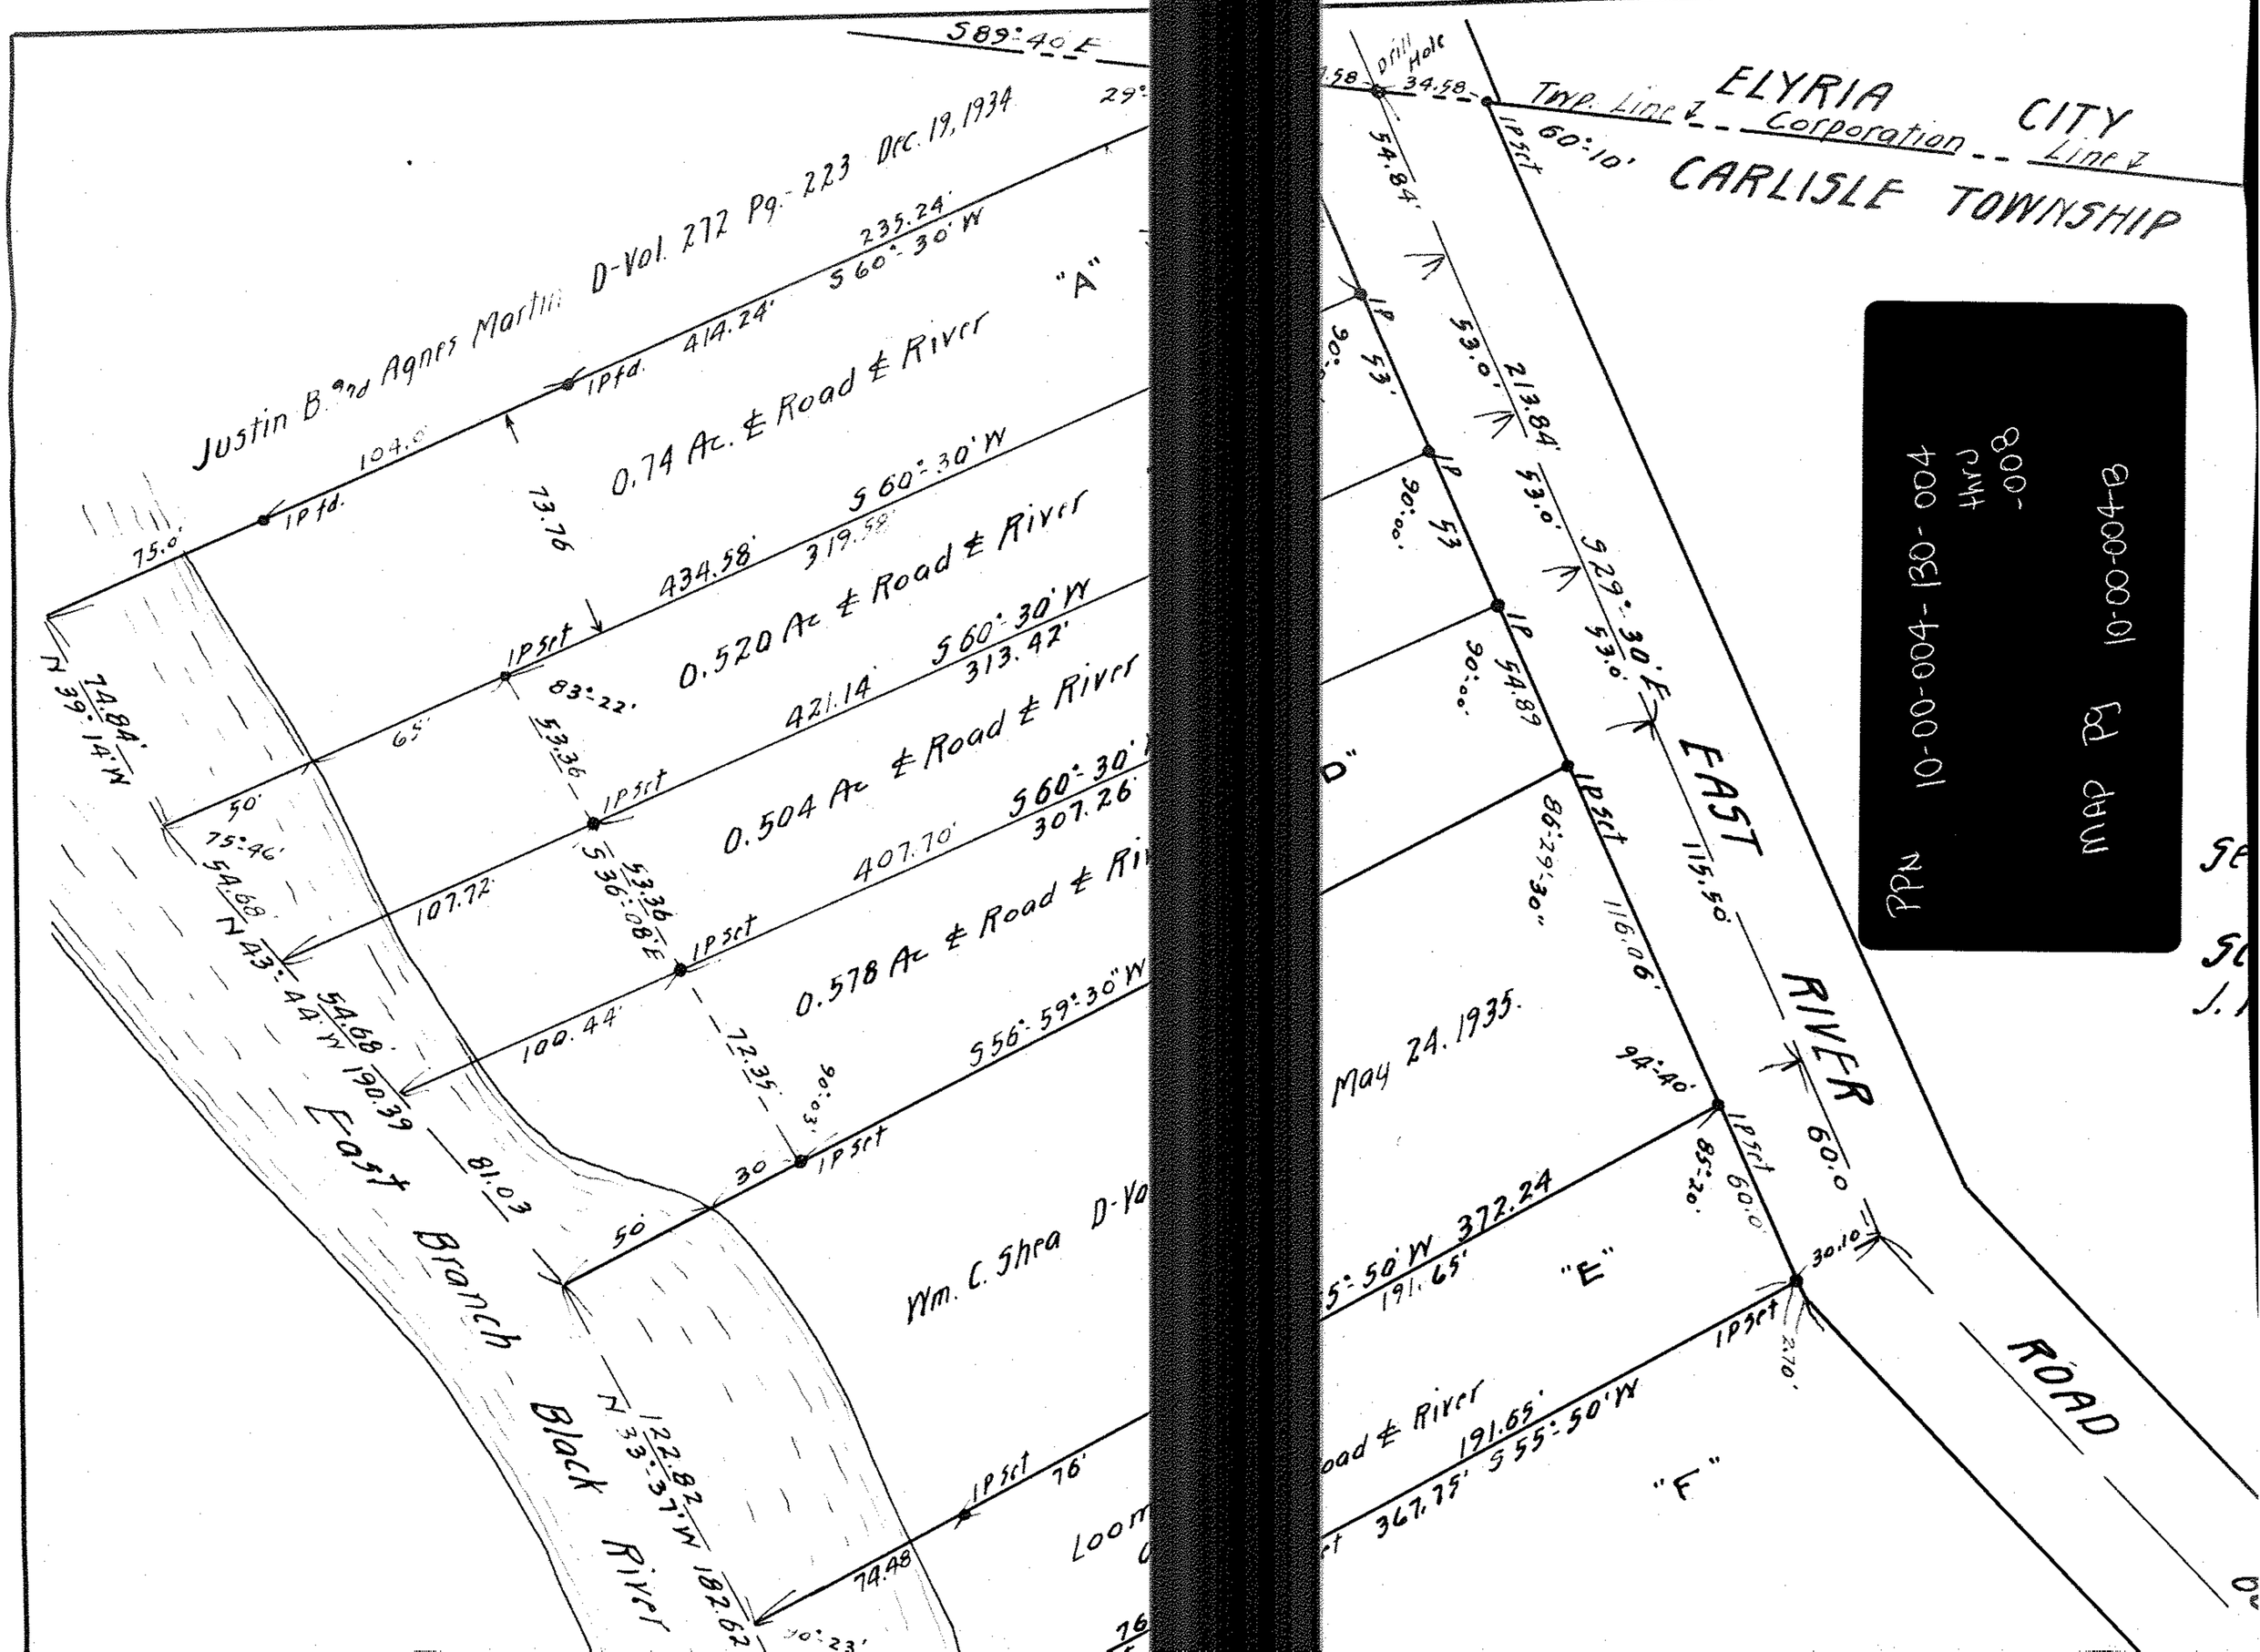

S89°40'E
Justin B. and Agnes Martin D-Vol. 272 Pg.-223 Dec. 19, 1934
235.24'
S 60°-30' W
414.24'
"A"
104.0'
1P fd.
1P fd.
75.0'
73.76
0.74 Ac. ℄ Road ℄ River
S 60°-30' W
434.58'
319.58'
1P Set
0.520 Ac ℄ Road ℄ River
83°-22'
65'
53.36
421.14'
S 60°-30' W
313.42'
1P Set
0.504 Ac ℄ Road ℄ River
S 60°-30' W
307.26'
407.70'
1P Set
0.578 Ac ℄ Road ℄ River
107.72'
53.36
S 36°-08' E
100.44'
72.35'
90°-03'
S 56°-59'-30" W
1P Set
30
50'
81.03
Wm. C. Shea D-Vo
East Branch Black River
122.82
N 33°-37' W 182.62
1P Set
76'
74.48
90°-23'
74.84'
N 39°-14' W
50'
75°-46'
54.68
N 43°-44' W
54.68
190.39
Drill Hole
34.58
Twp. Line
ELYRIA CITY
Corporation Line
60°-10'
CARLISLE TOWNSHIP
1P Set
54.84'
1P
53'
53.0'
213.84'
53.0'
1P
53
90°-00'
S 29°-30' E
53.0'
1P
54.89
90°-00'
EAST RIVER ROAD
115.50'
86°-29'-30"
116.06'
May 24. 1935.
94°-40'
1P Set
60.0
85°-20'
60.0
5°-50' W 372.24
191.65'
"E"
30.10
1P Set
2.70'
oad ℄ River
191.65'
S 55°-50' W
367.75'
"F"
PPN 10-00-004-130-004 thru -008
MAP Pg 10-00-004-B