 

Survey for

WILLIAM GOLDE ESTATE.

Lots 37-40. West of Black River,
Elyria Twp., Lorain Co., Ohio.
Nov. 4, 1940. Scale 1" = 100'.
J. W. Warden - Registered Surveyor.

Note:- Survey = 24.805 Acres from East line 12' strip to King - to West Line Lake Ave (54' width).

PPN 06-28-037-104-???

MAP PG 6-42

Tan 1°46'30" = 1.00048
Cos 1°46'30" = .99952

Tan 0°01'30" .00044

Tan 5°42" = .01481
Sec 5°42" = 1.00477
Cos 5°42" = .99522