

JOHN W. WARDEN
 CIVIL ENGINEER AND SURVEYOR
 405 ELYRIA BLOCK
 ELYRIA, OHIO

STATE OF OHIO


REGISTERED } PROFESSIONAL ENG.
 } SURVEYOR

PHONE

BUSINESS 3211

RESIDENCE 38

(now Joseph Schrembs, Bishop)
 John Snyder Jr
 D. Vol-90-Pg-185-Feb-6-1903

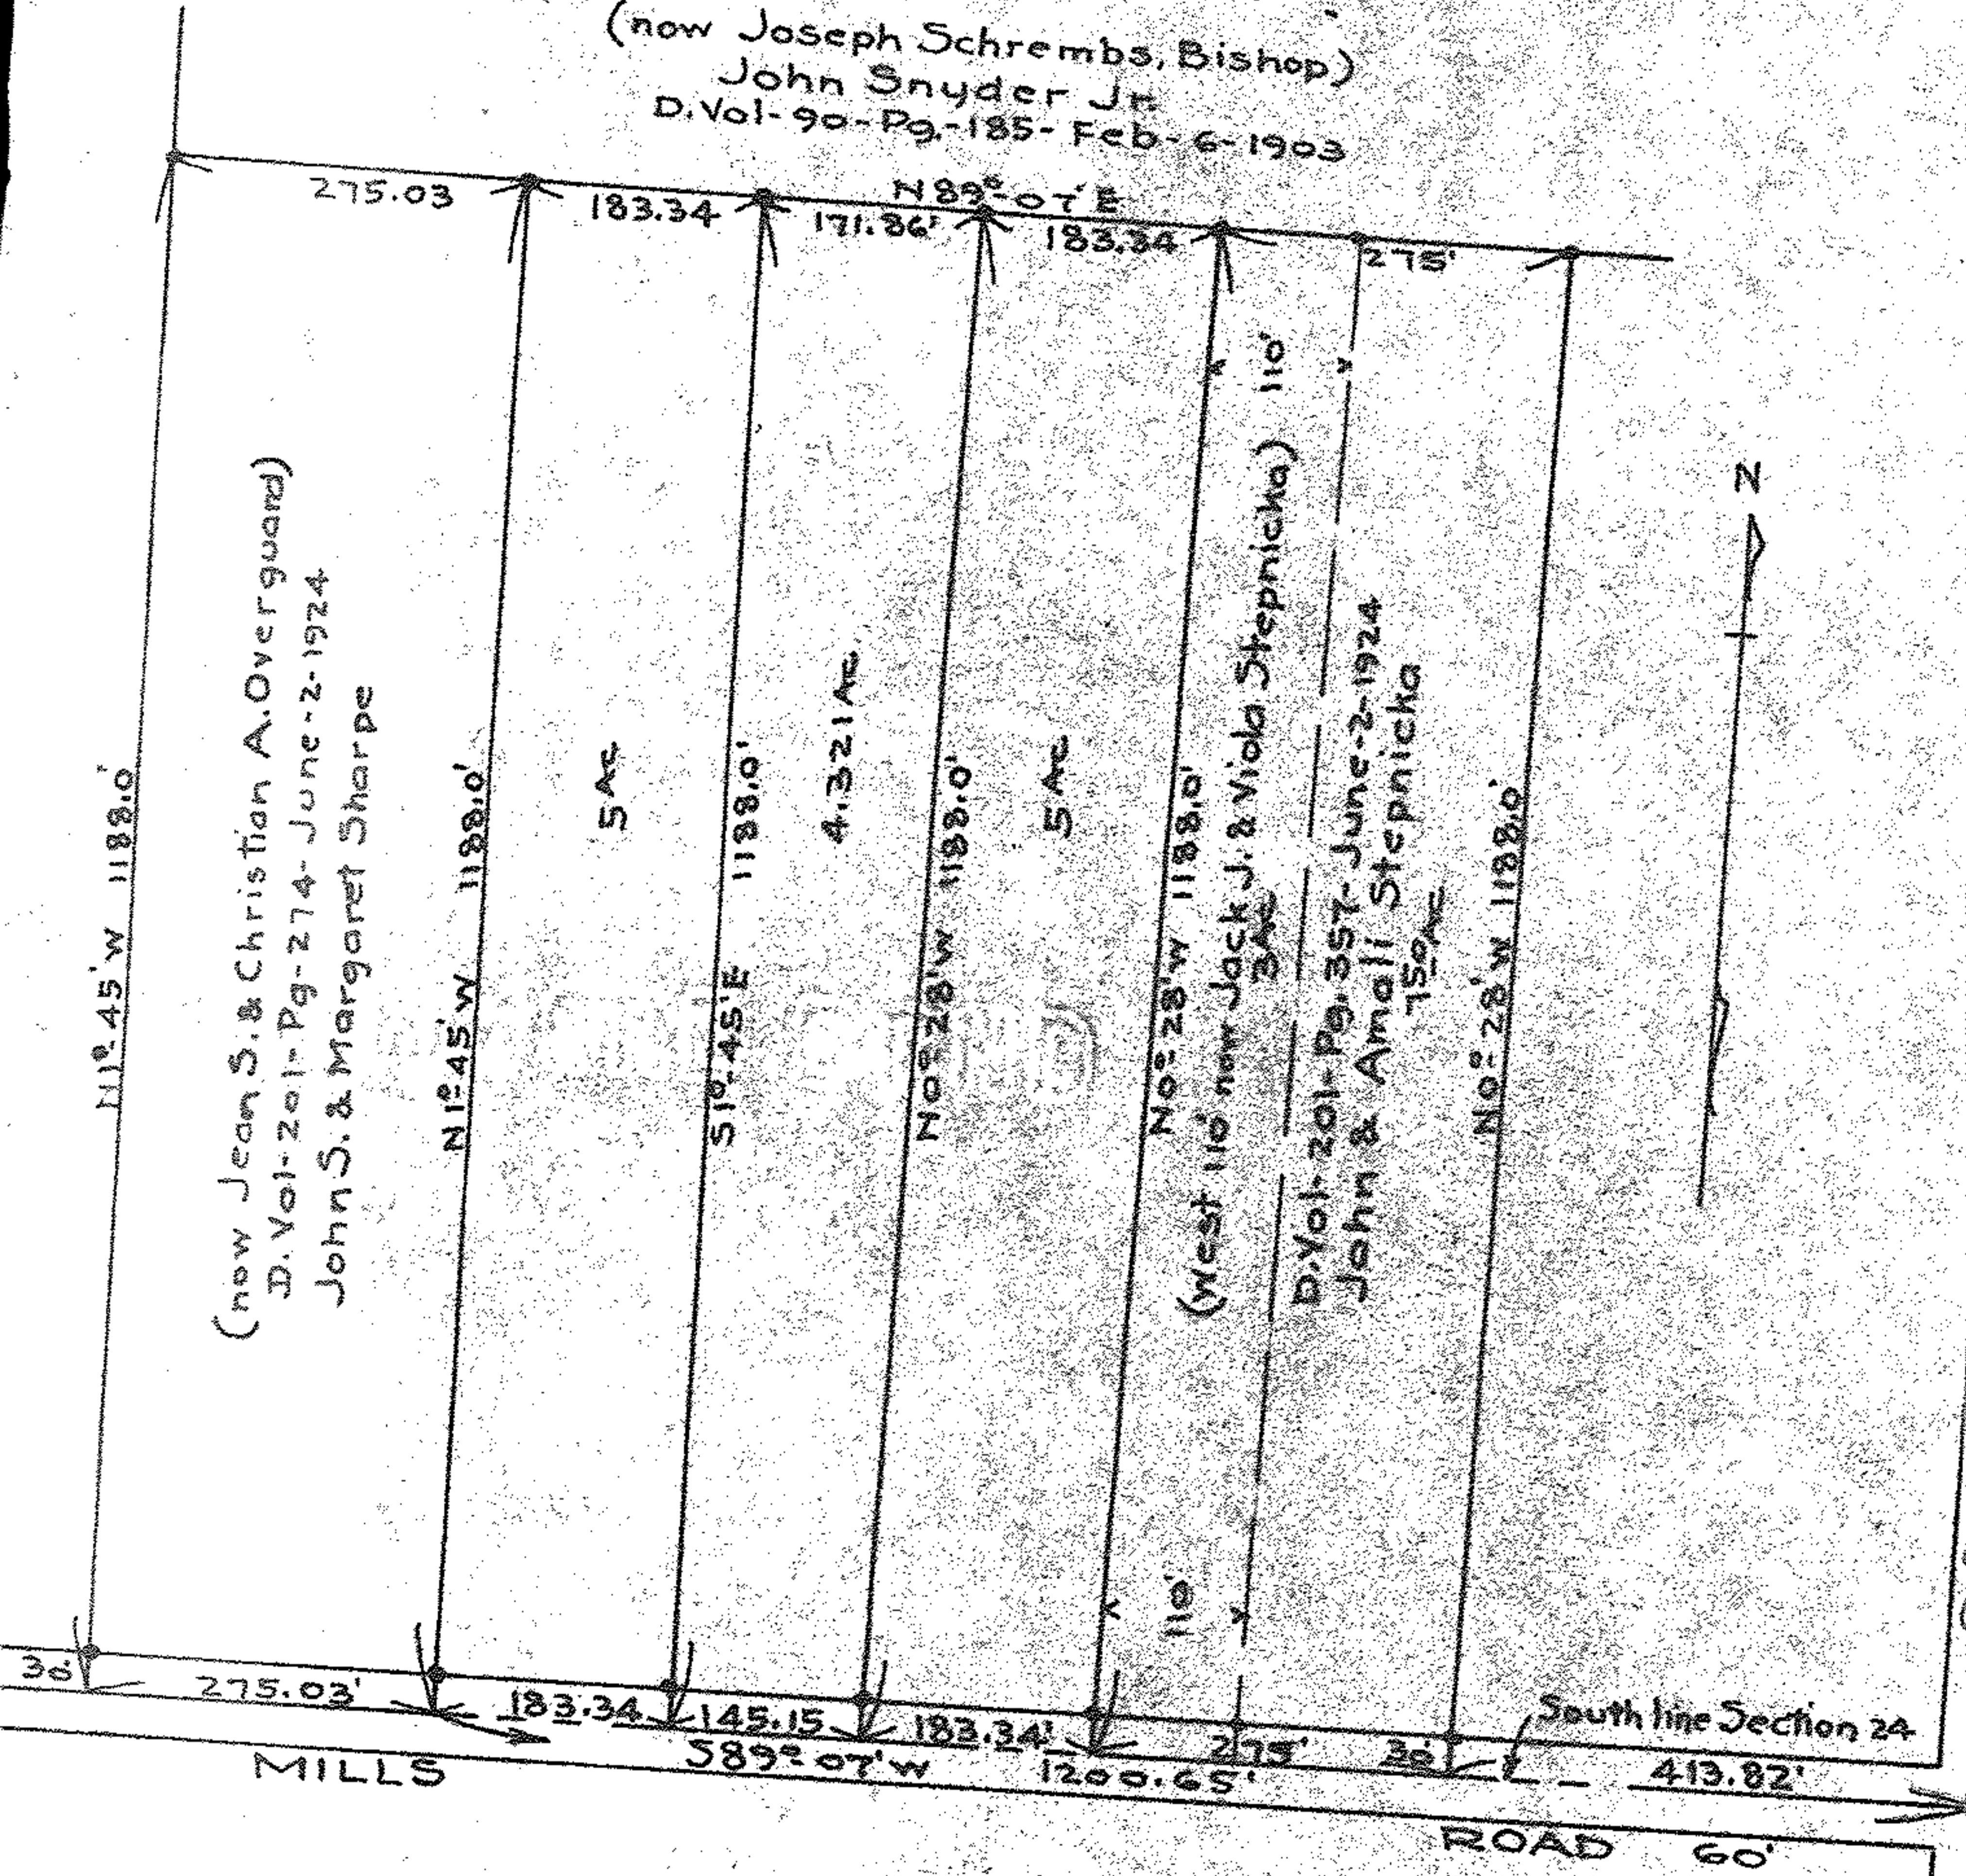

Deed to Village of Avon, dated
 ct. 1-1936-D. Vol-284-Pg. 351 for 10 feet
 to widen Mills Road from 40' to 60'.

Survey for
 The Spokane Realty Co.,
 Sec. 24- Avon Village, formerly Avon Twp.,
 Lorain Co., Ohio.

April 28, 1941.

Scale 1" = 200'

Iron pins set or found at all points marked thus