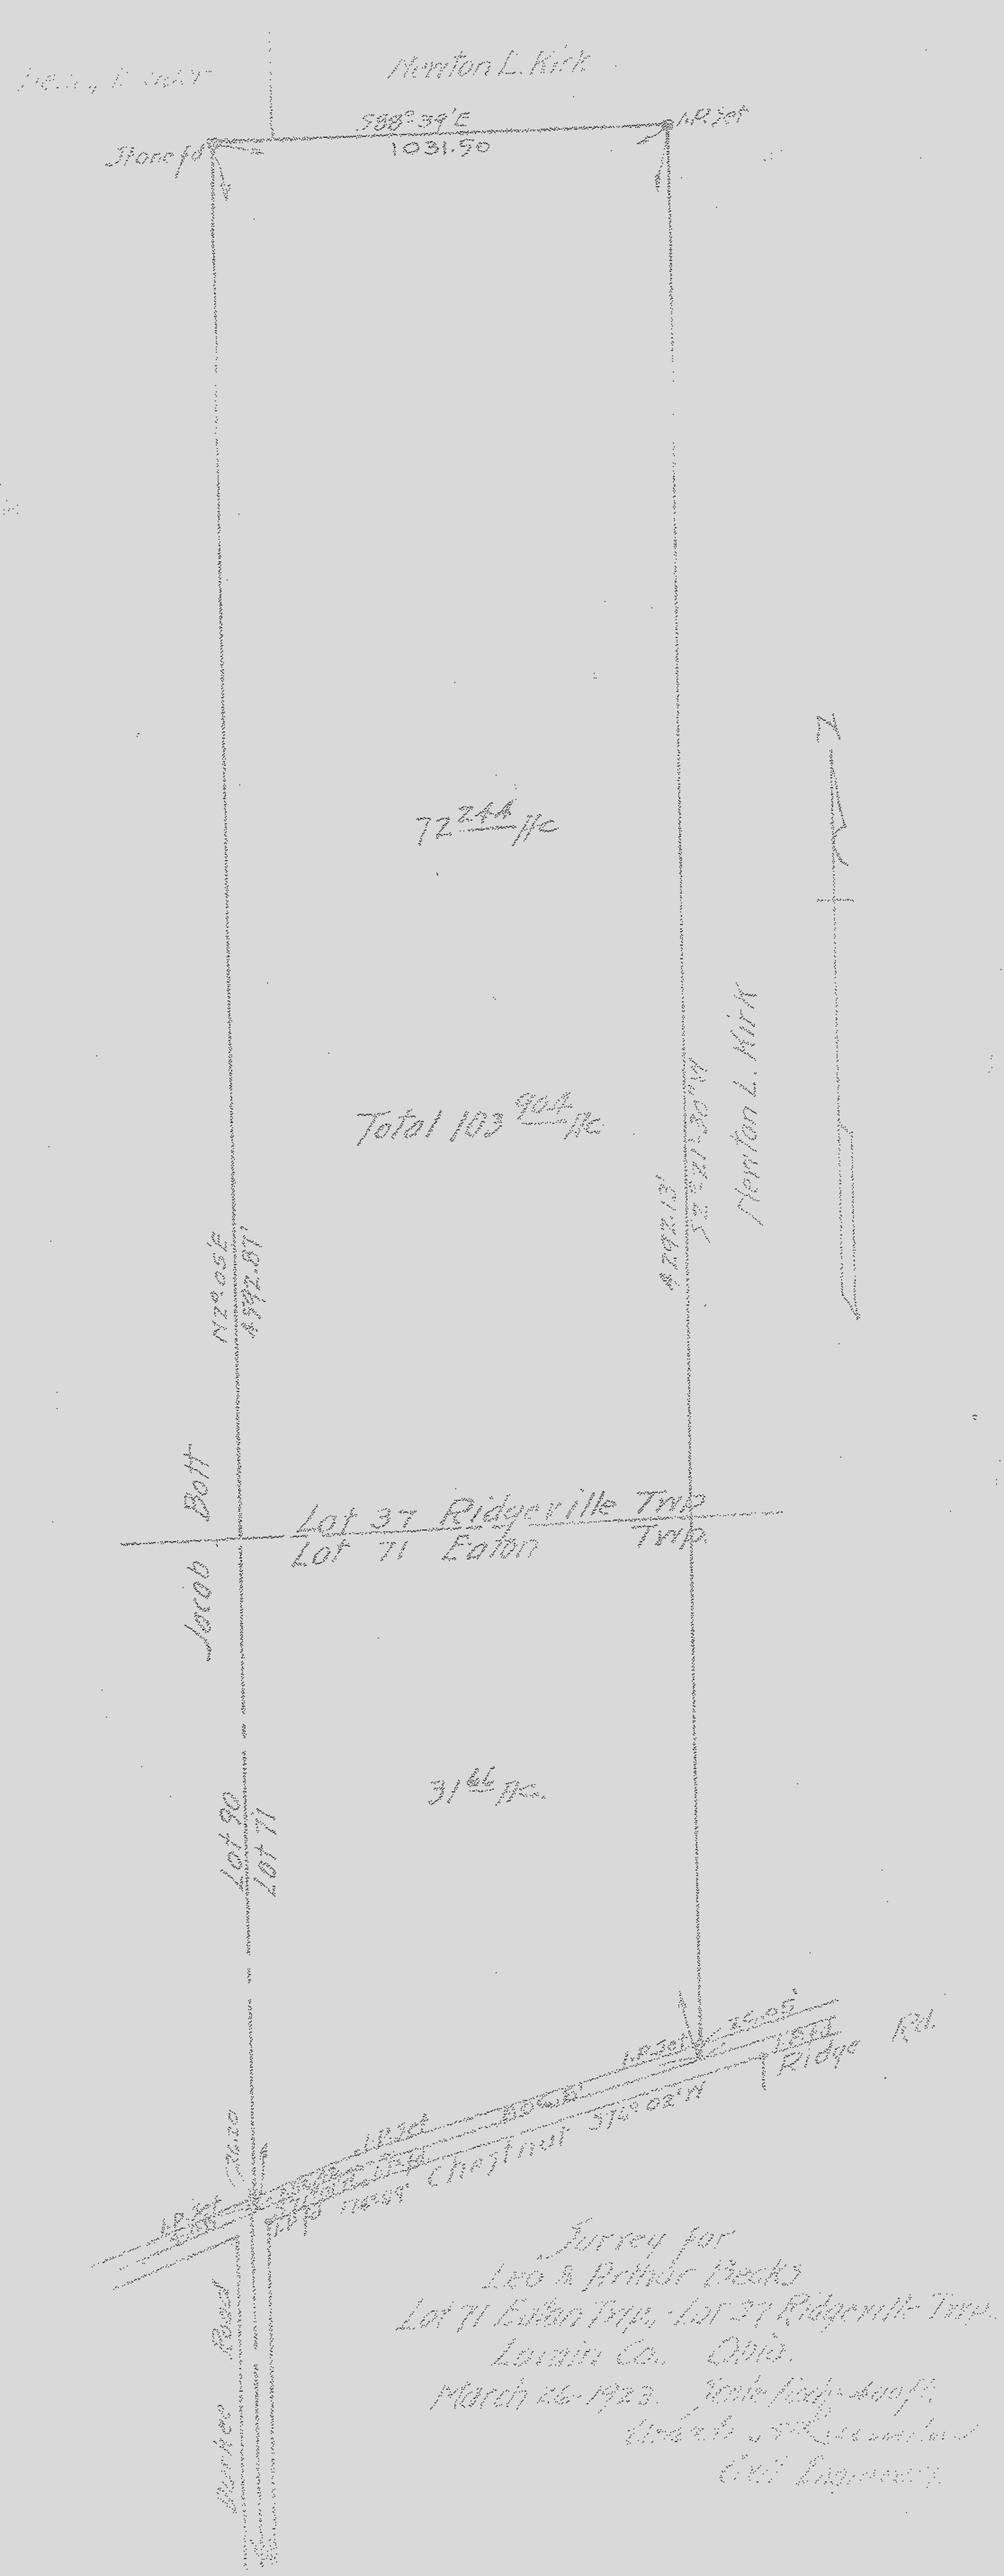

Survey for
Leo & Pribor Beck
Lot 71 Eaton Twp. Lot 37 Ridgeville Twp.
Lorain Co. Ohio.
March 26 1923. Scale 1 inch = 400 ft.
Andrew J. McLaughlin
Civil Engineer.