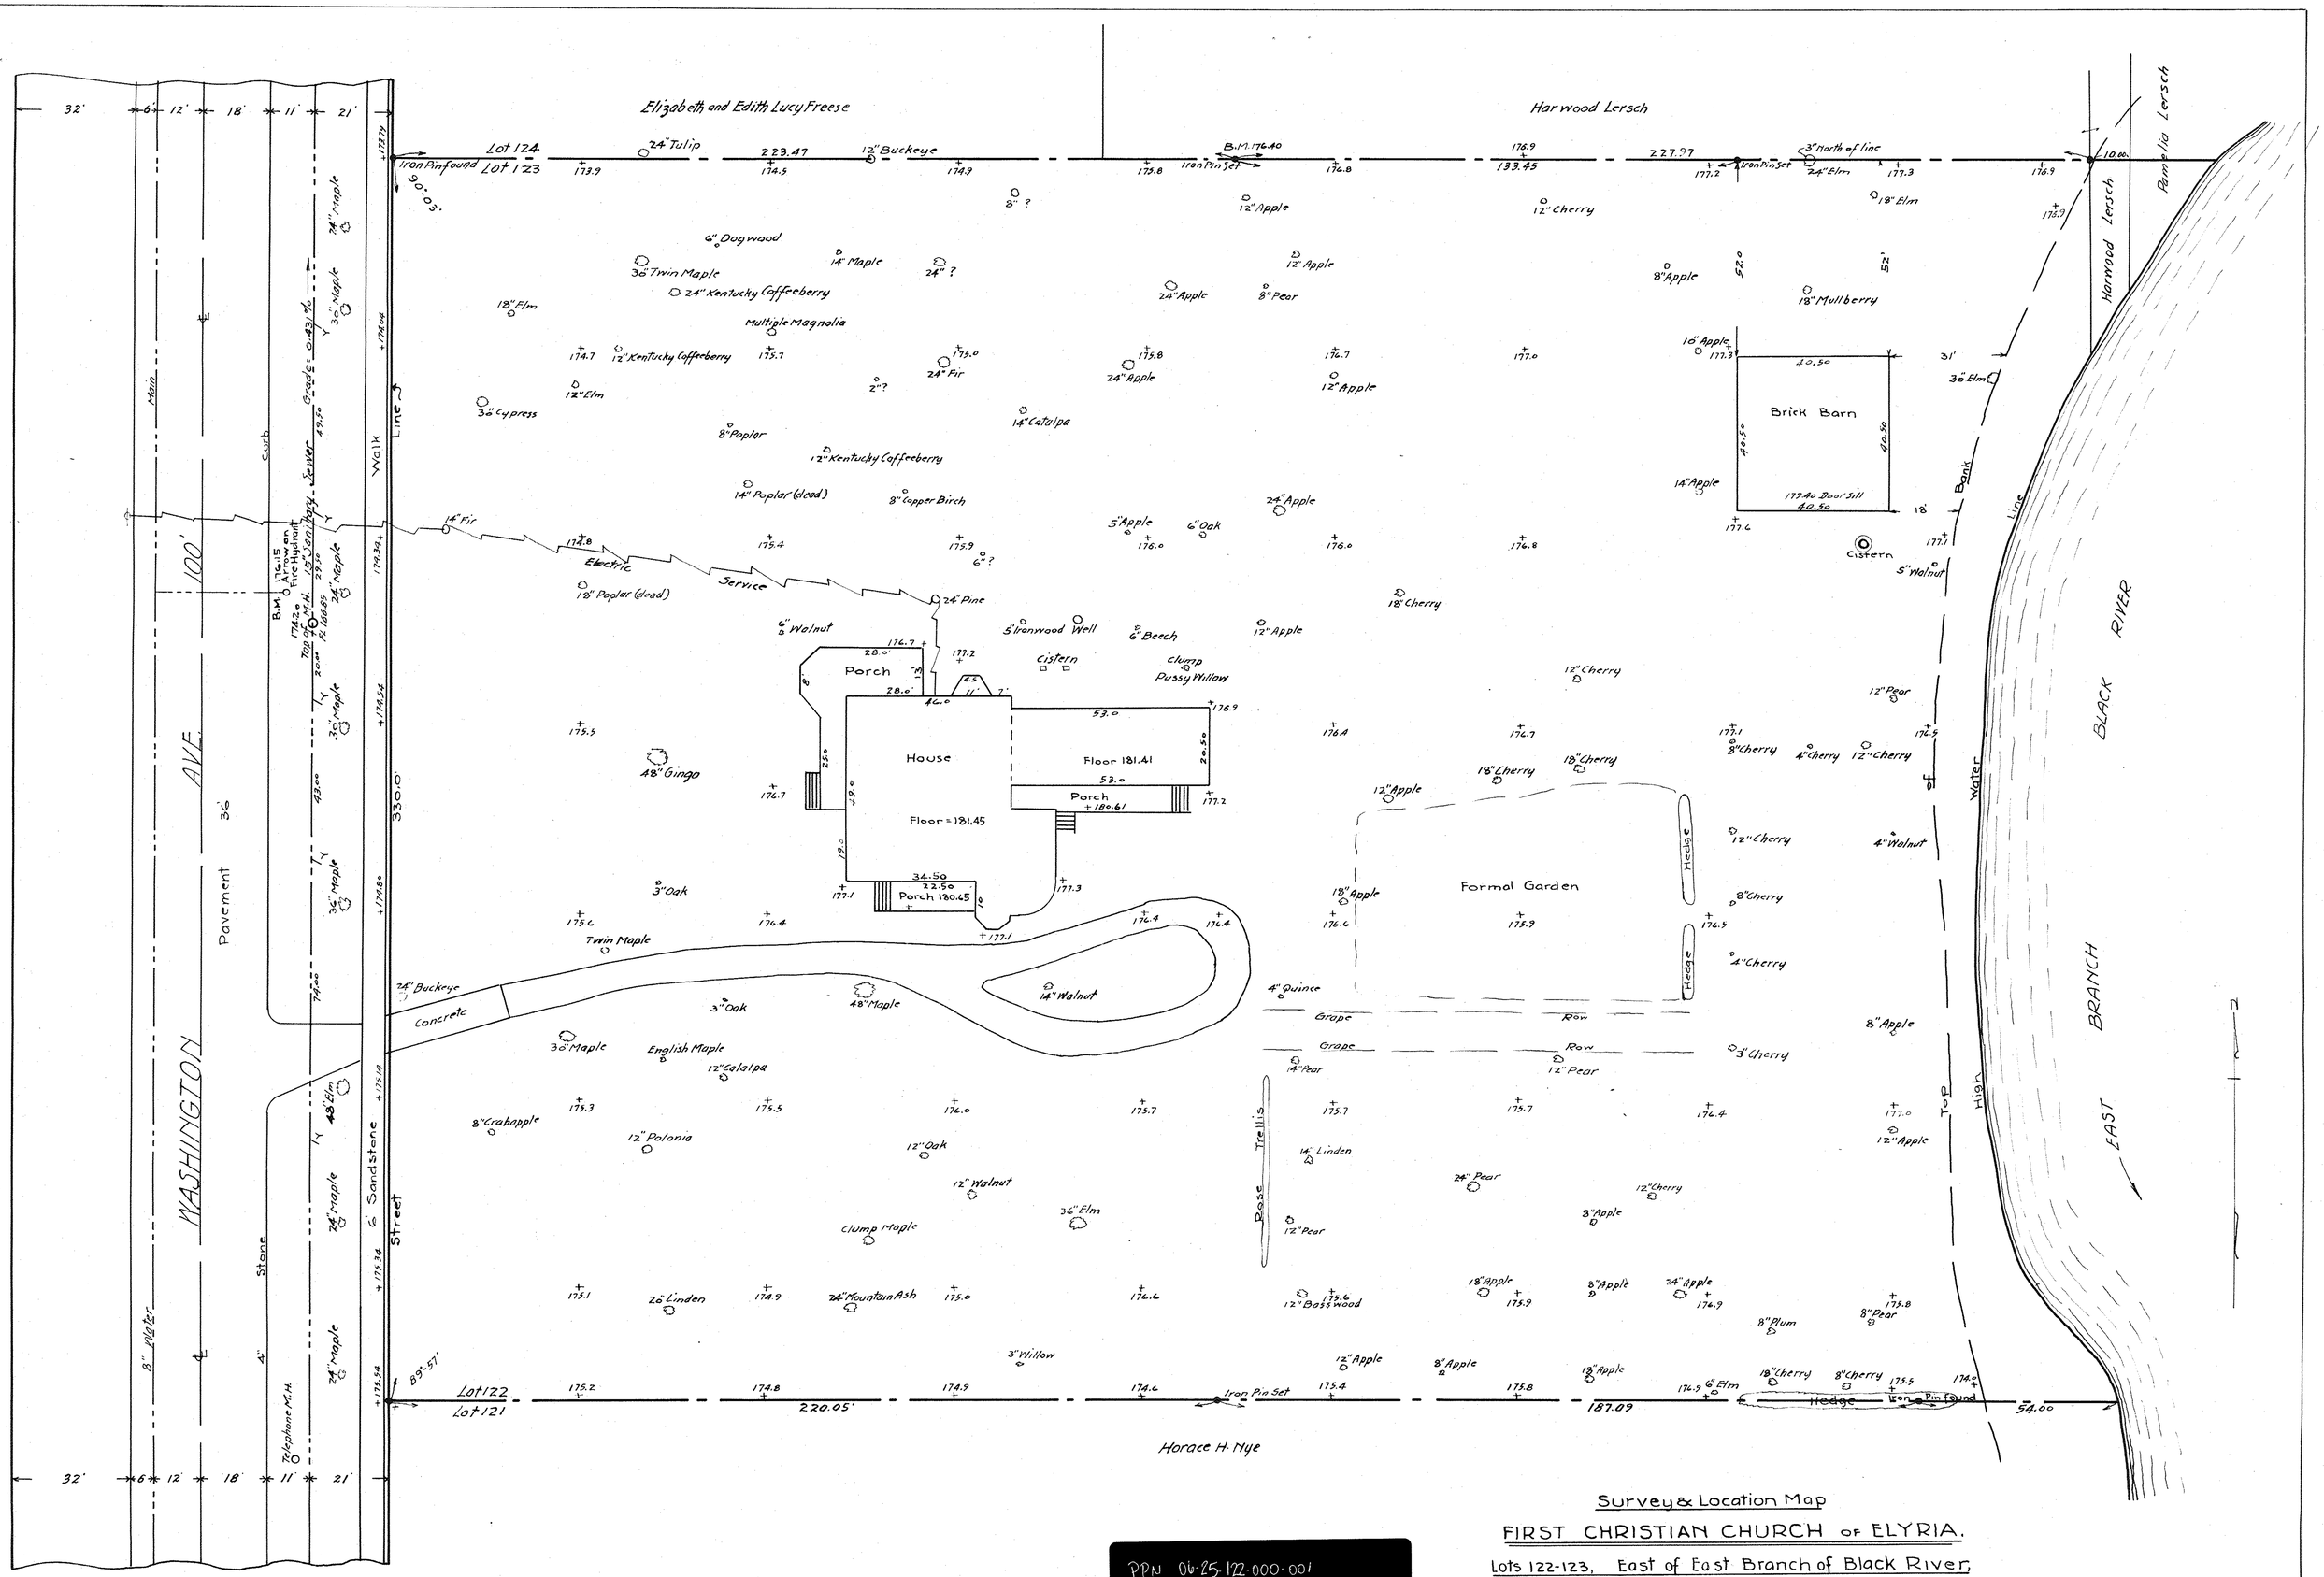

PPN 06-25-122-000-001
06-25-123-000-001

MAP Pg 6-102

Survey & Location Map

FIRST CHRISTIAN CHURCH OF ELYRIA.

Lots 122-123, East of East Branch of Black River,

Elyria - Lorain Co., - Ohio.

June-15-1945. Scale 1" = 20'.

J.W. Warden, Registered Surveyor.