


SURVEY FOR G. M. FERGUSON  
Elyria City Lots 23-24 Day's Addn.  
Scale 1"=30'  
T.L. Gibson Eng.

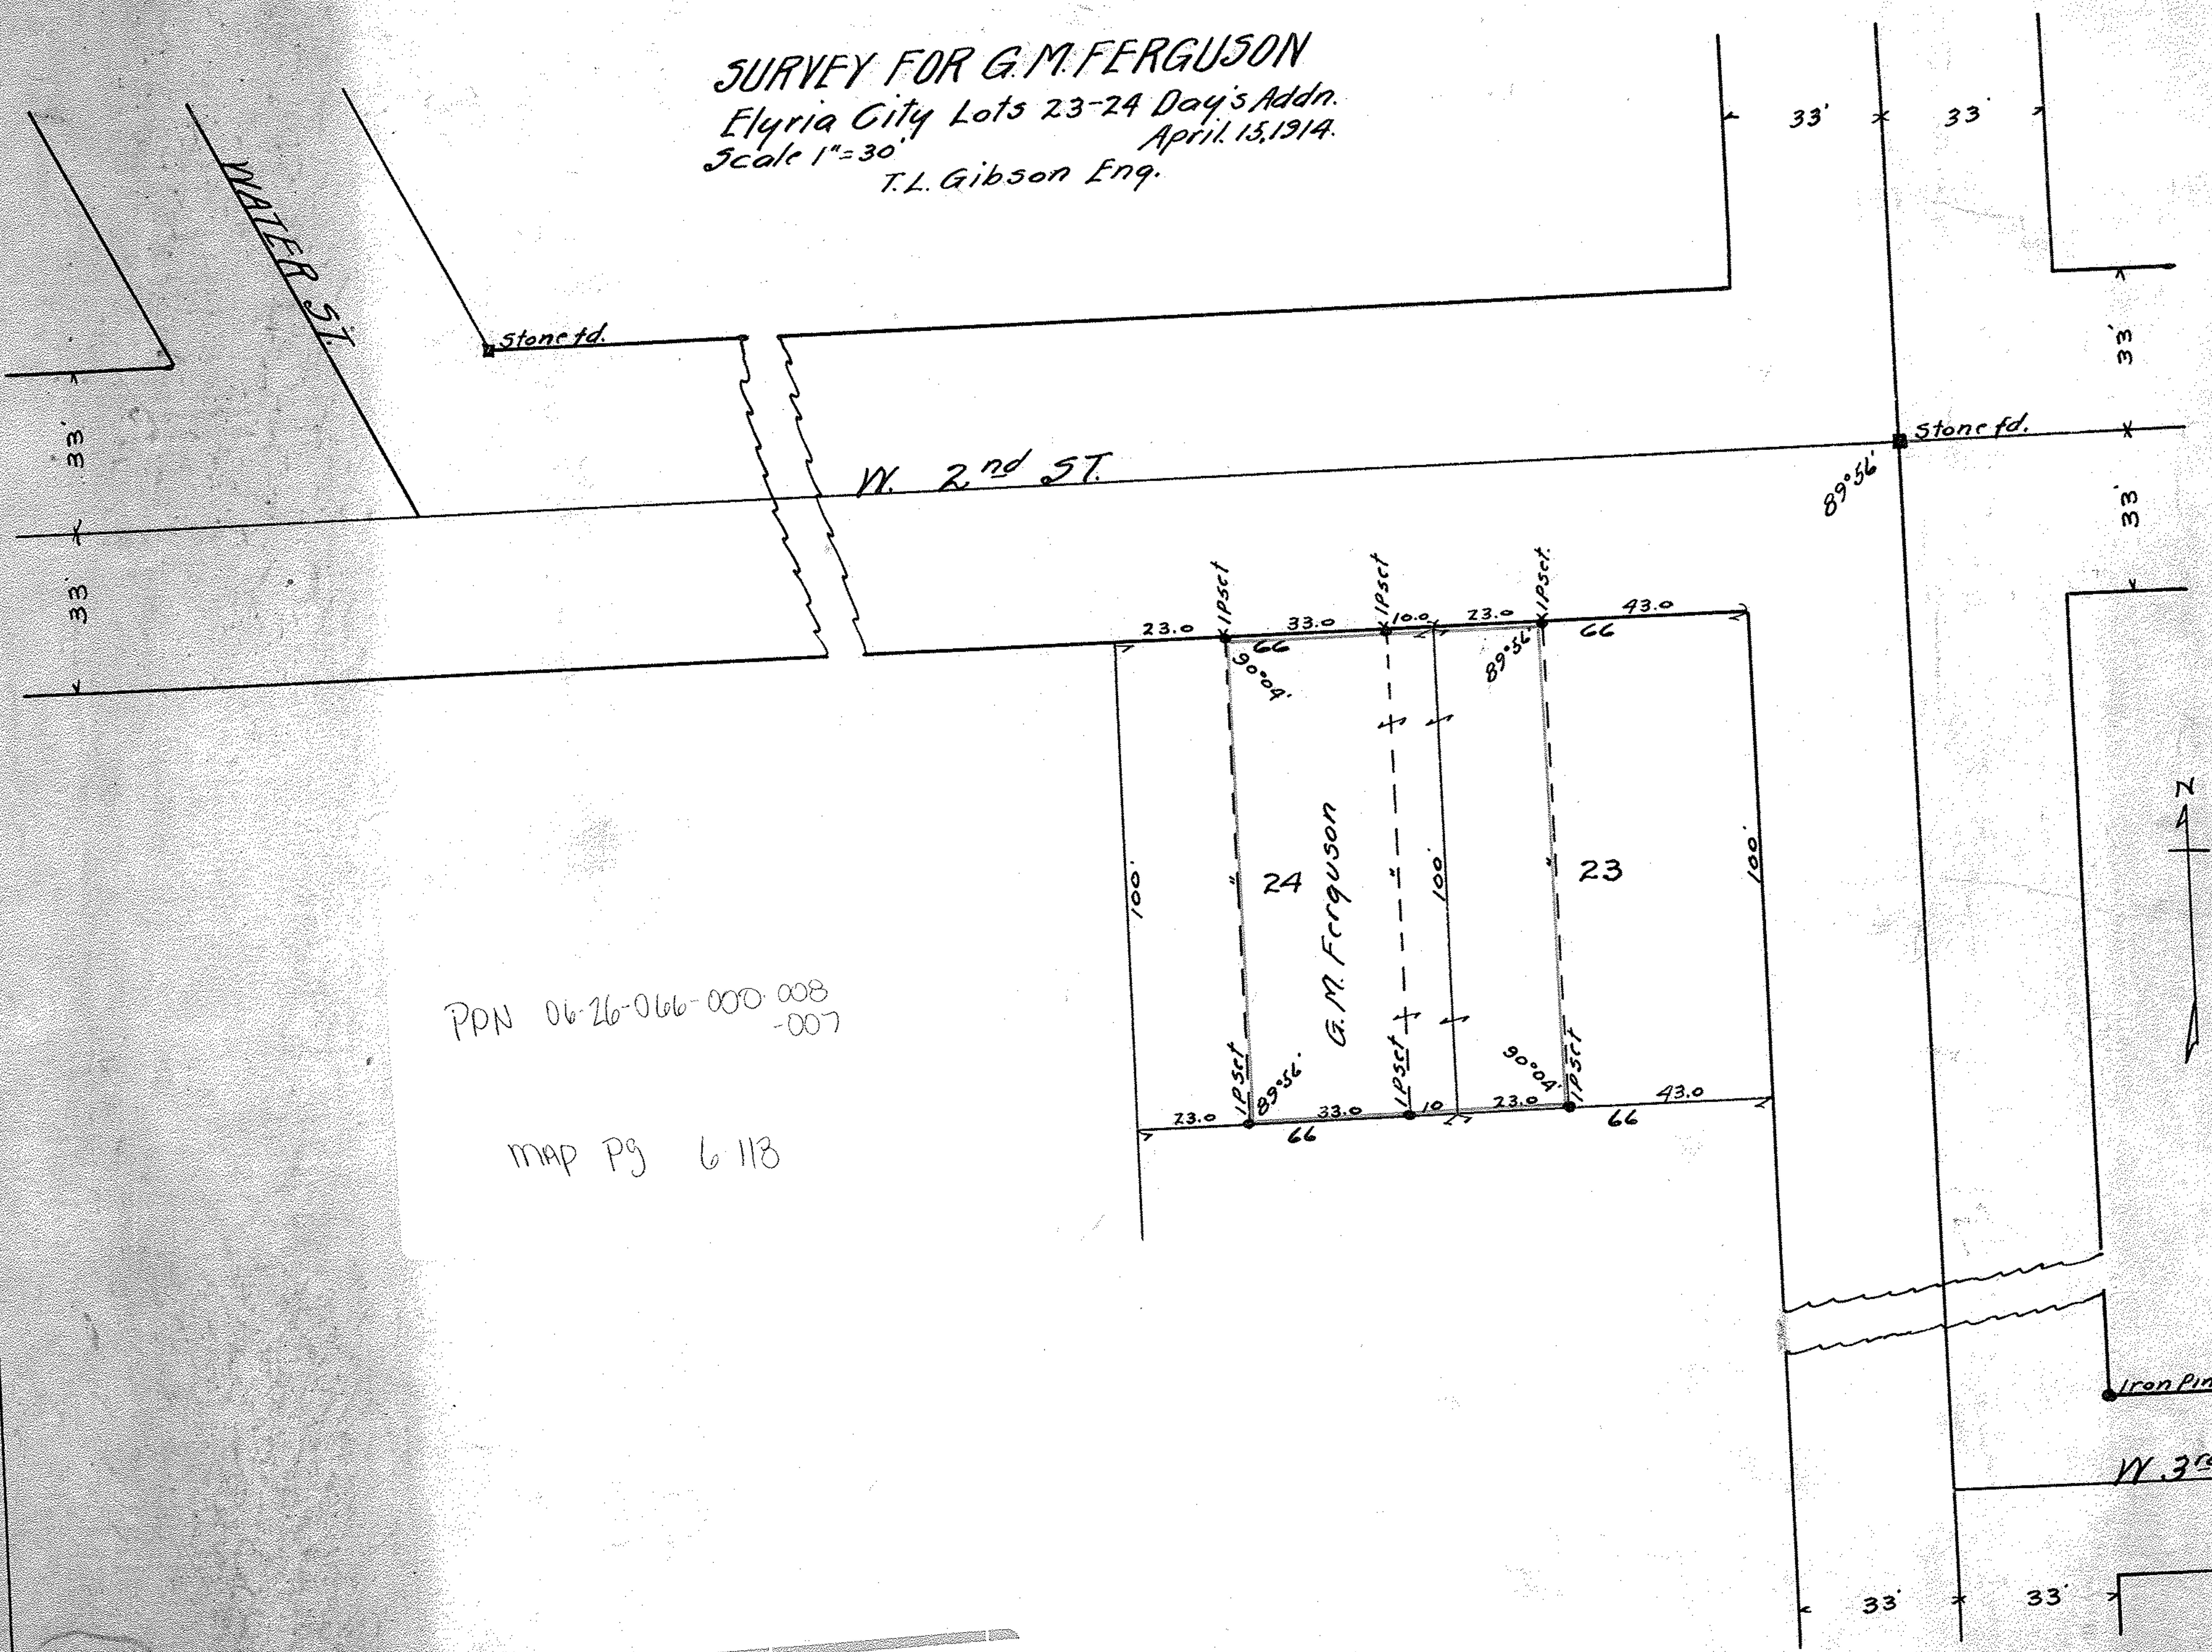

PPN 06-26-066-000-008  
-007

map pg 6113

212

212

400512

D.P.A.