Survey for C.D. Van Hoeson

Lots 14-15-147-148 Block 65 Origonal Plat of Elyria

Elyria Lorain Co. Ohio. March 30, 1918. Scale 1" = 50'

Warden & Laundon - Engineers

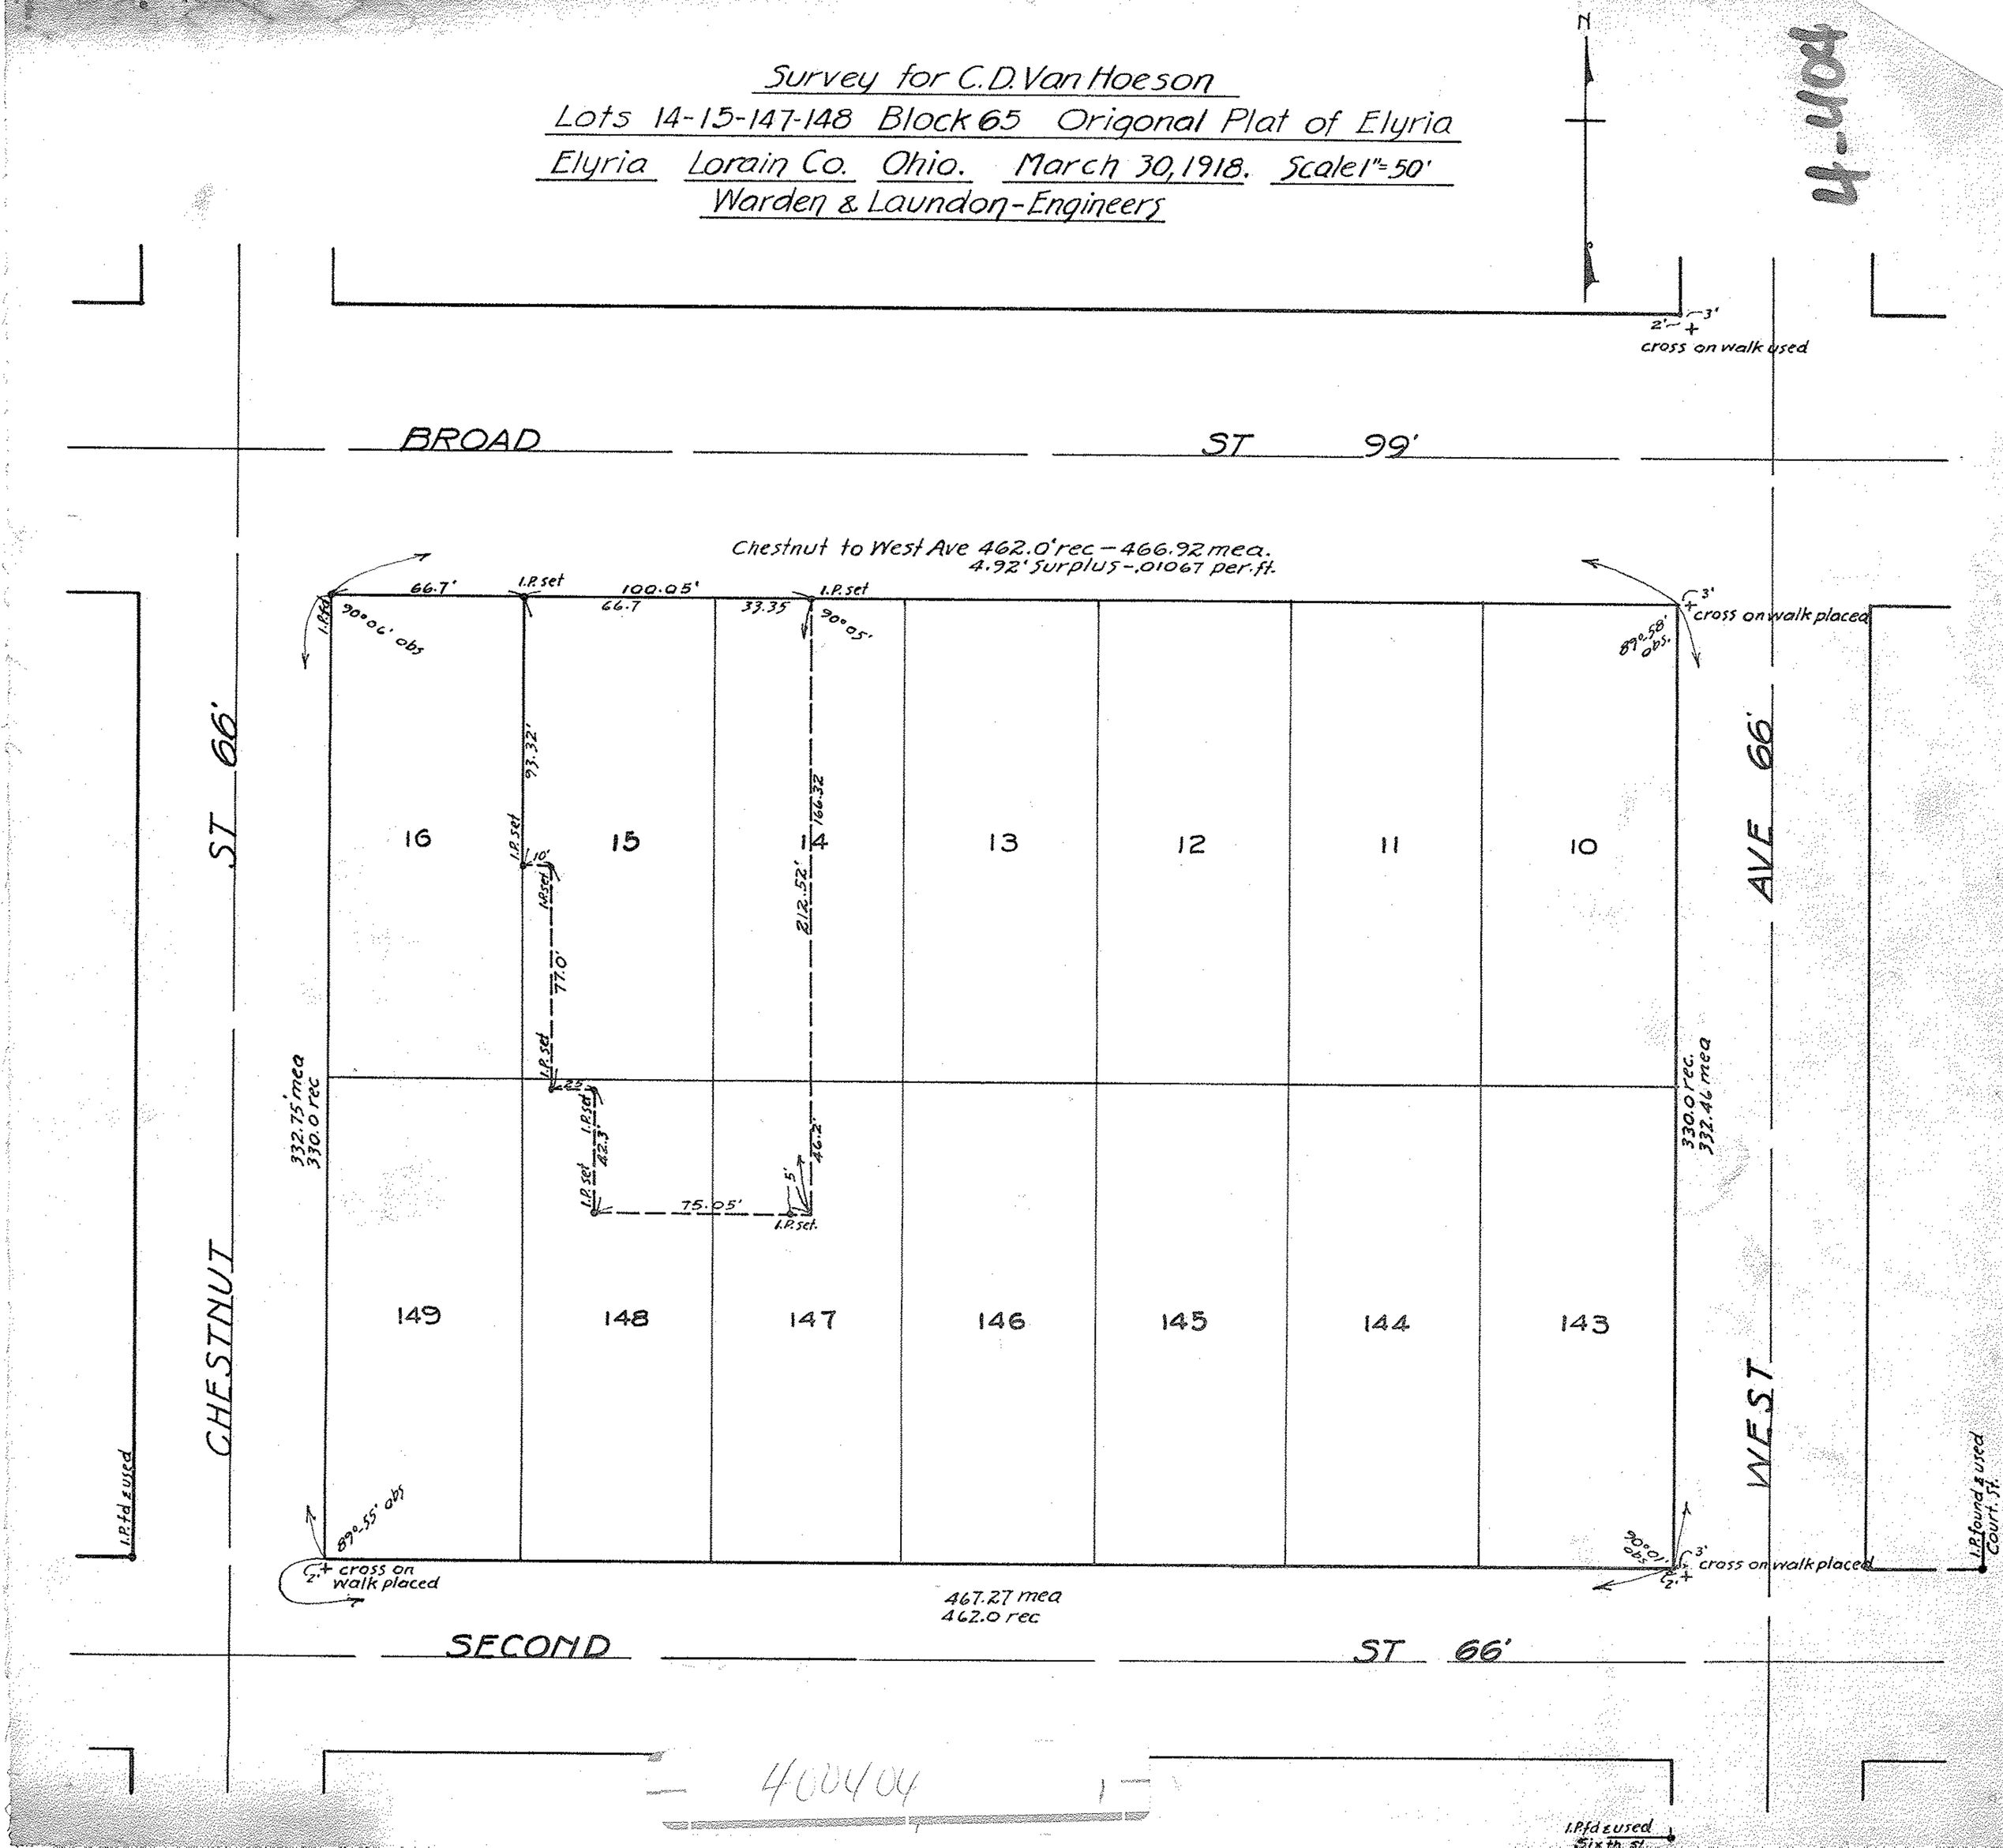

400404