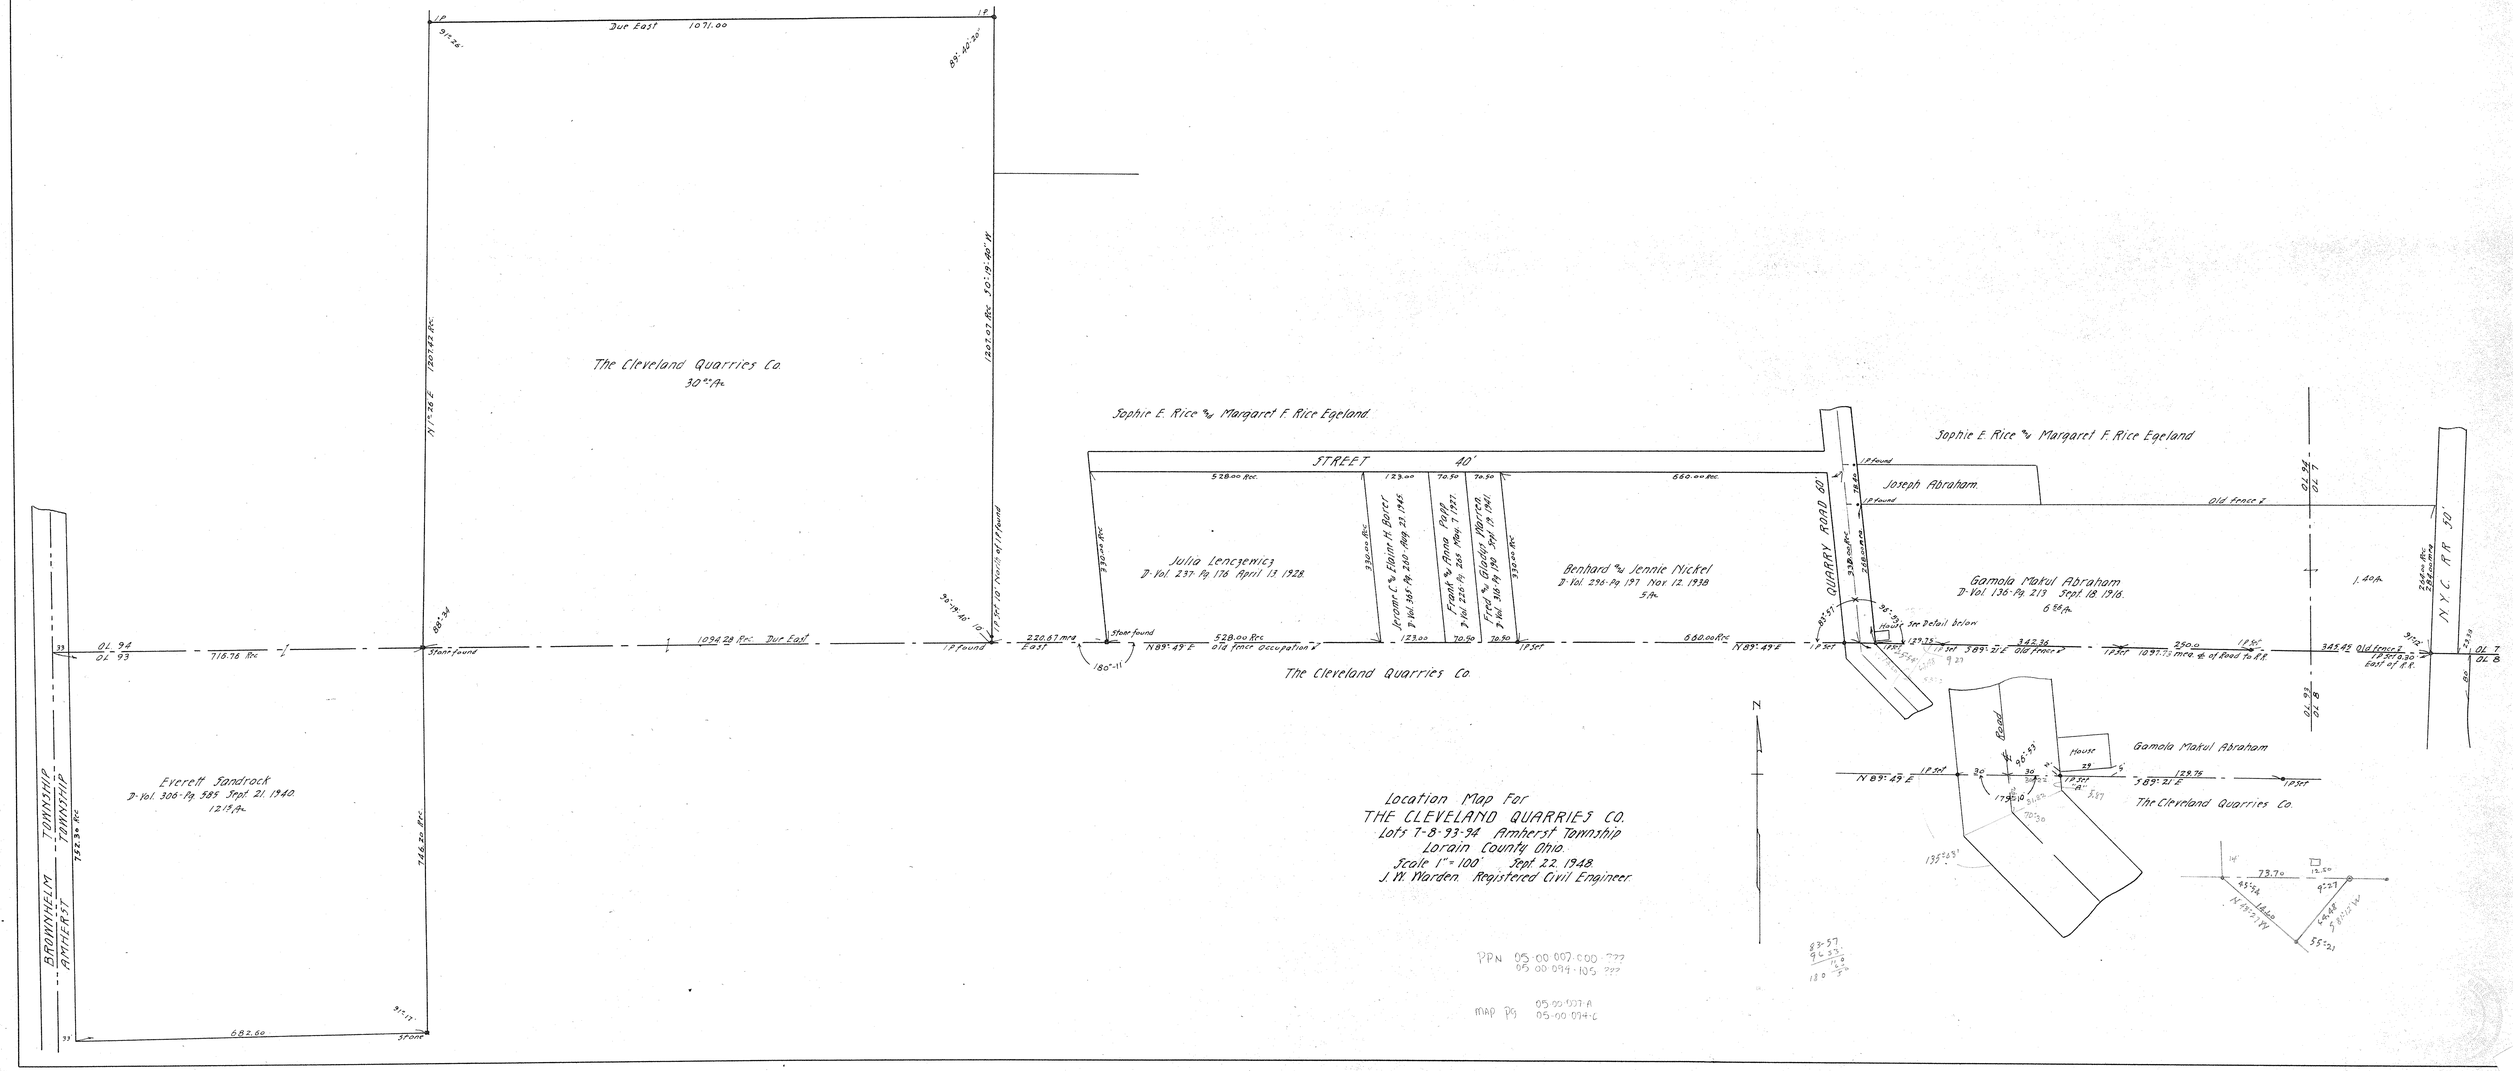
Due East 1071.00
The Cleveland Quarries Co.
30 ac. ±
Sophie E. Rice & Margaret F. Rice Egeland
STREET 40'
Julia Lenczenicz
D-Vol. 237-Pg 176 April 13 1928
Benhard & Jennie Nickel
D-Vol. 296-Pg 197 Nov 12 1938
5 ±a.
QUARRY ROAD 60'
Joseph Abraham
Gamola Matul Abraham
D-Vol. 136-Pg. 213 Sept. 18 1916.
6.88 ±a.
1.40 ±a.
N.Y.C. R.R. 50'
Everett Sandrock
D-Vol. 306-Pg. 585 Sept. 21 1940
12.19 ±a.
AMHERST TOWNSHIP
The Cleveland Quarries Co.
Location Map For
THE CLEVELAND QUARRIES CO.
Lots 7-8-93-94 Amherst Township
Lorain County Ohio
Scale 1" = 100' Sept. 22. 1948
J. W. Warden Registered Civil Engineer
PPN 05-00-007-000 ???
05-00-094-105 ???
map pg 05-00-007-A
05-00-094-C