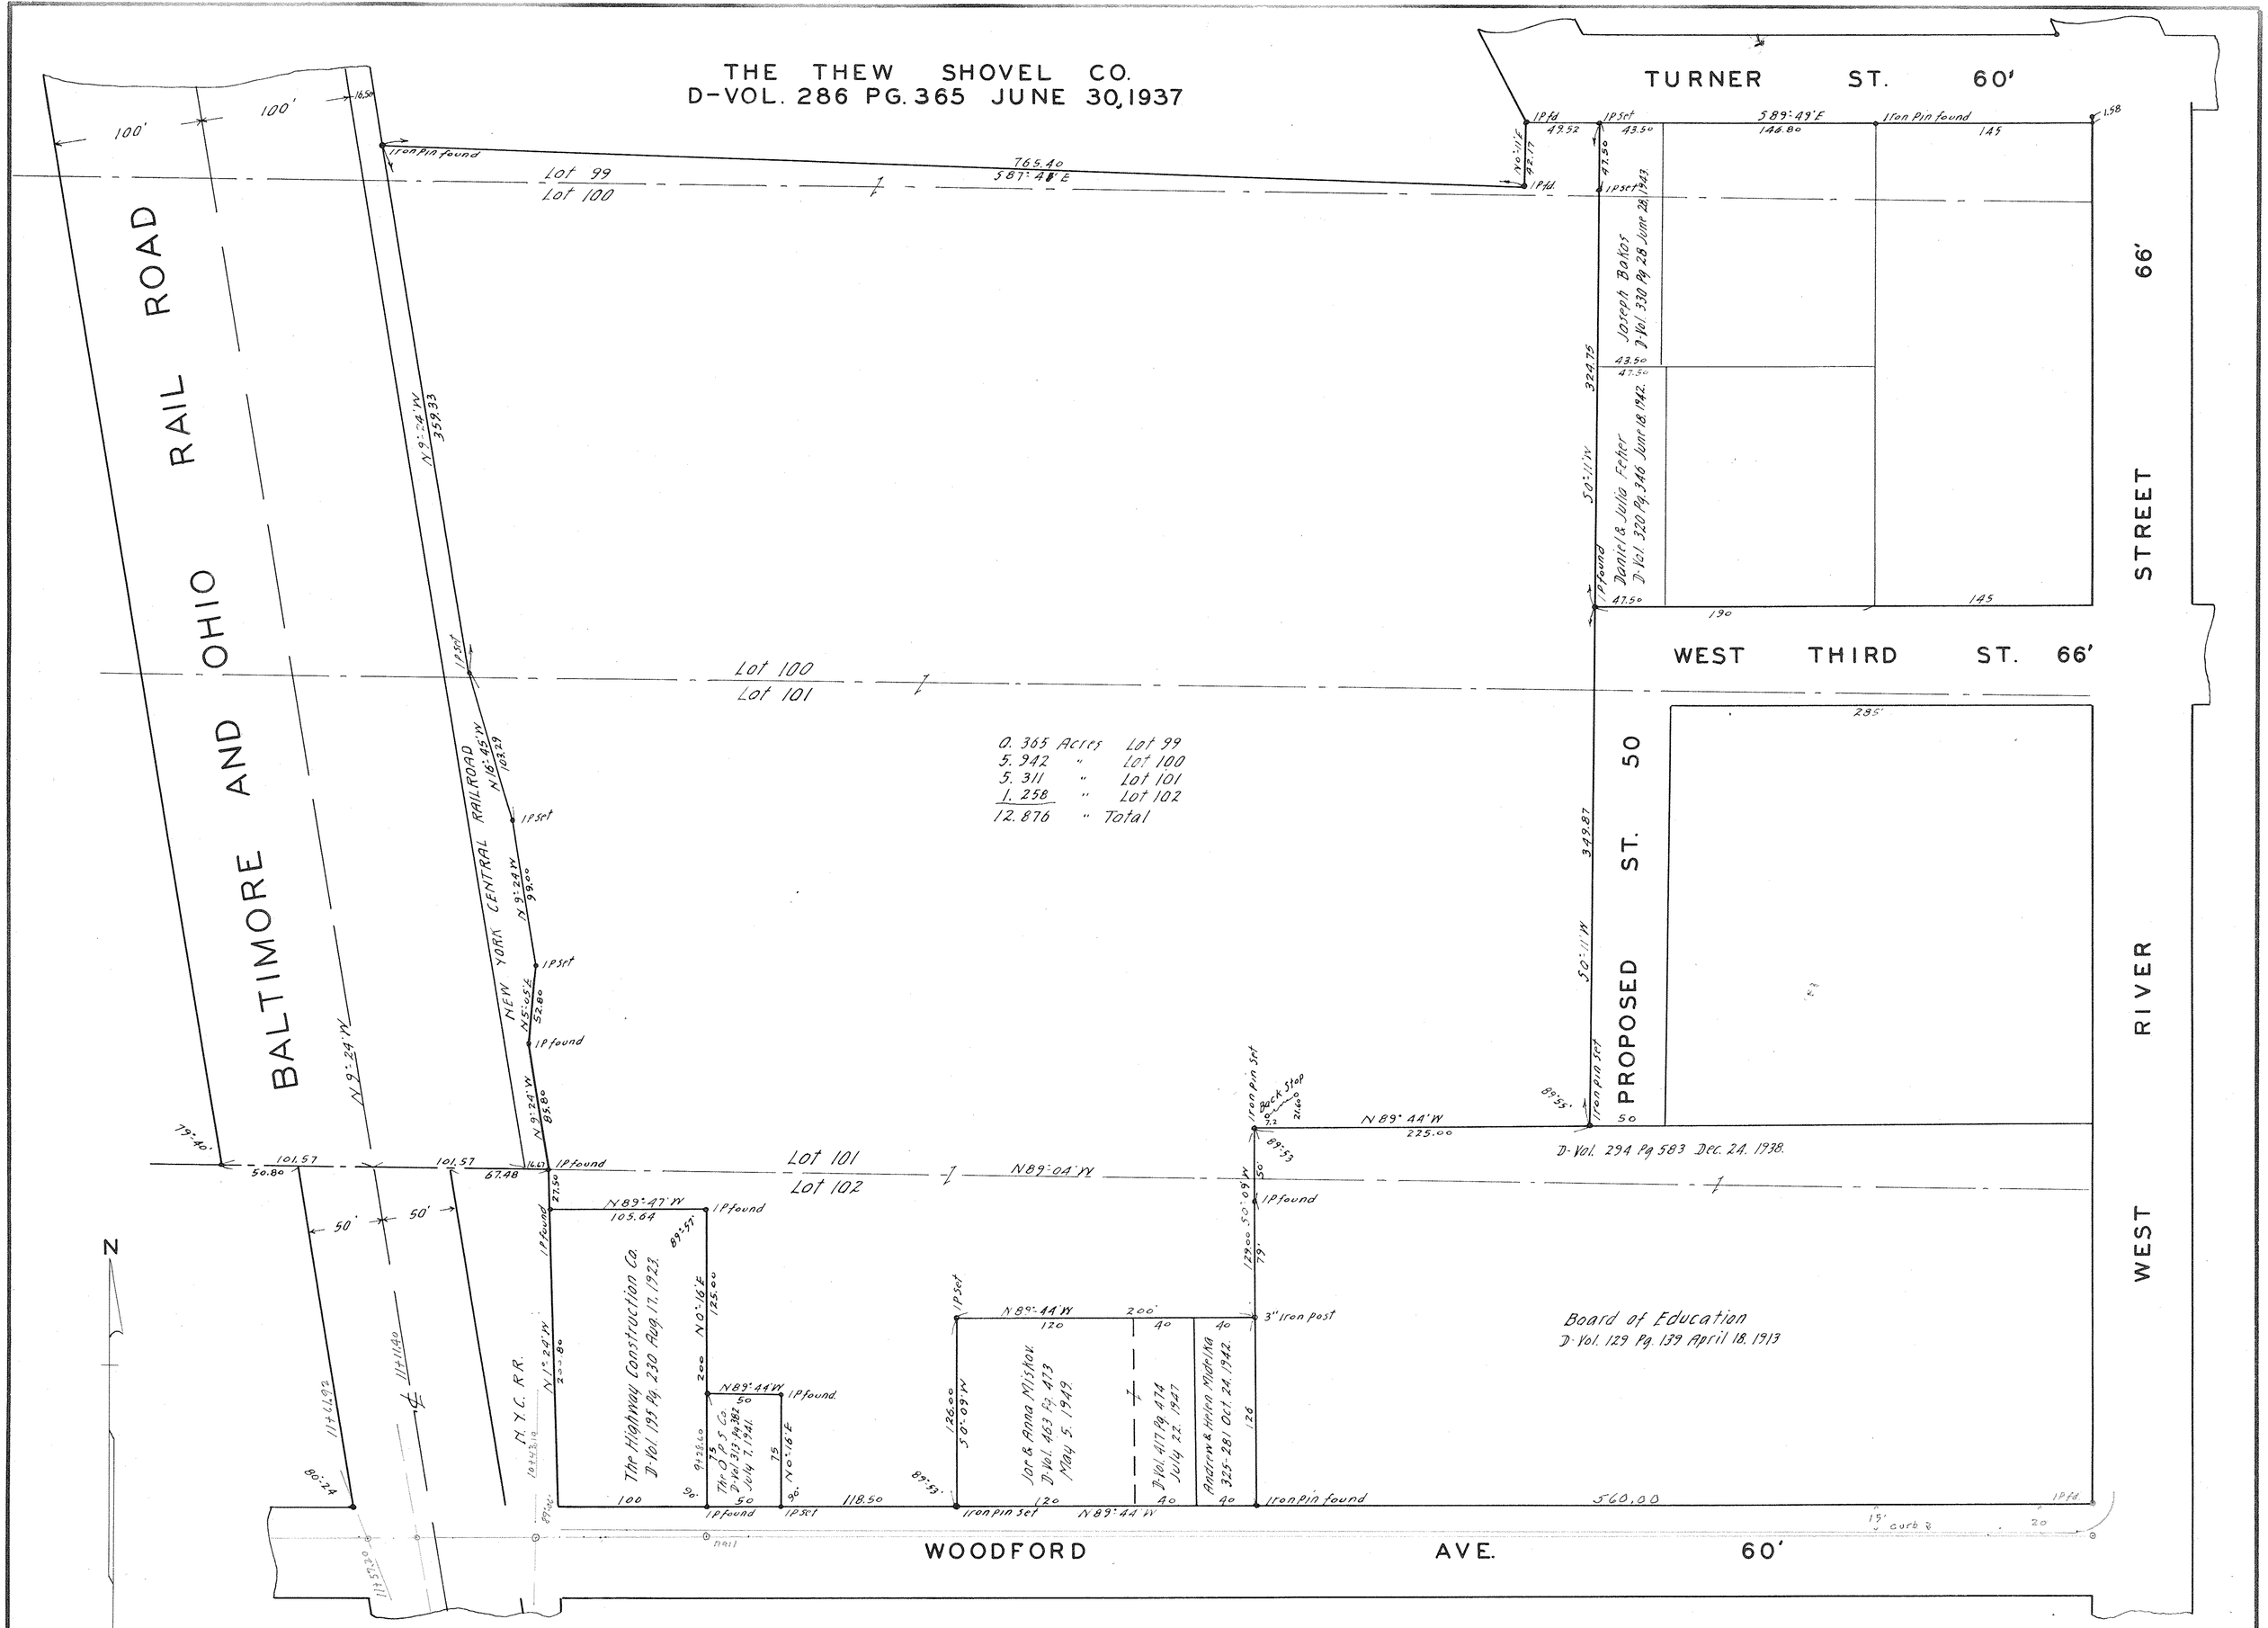

SURVEY FOR

THE LORAIN COUNTY SAVINGS AND TRUST CO.

LOTS 99-100-101-102 WEST OF THE WEST BRANCH OF THE BLACK RIVER

ELYRIA TWP., ELYRIA CITY, LORAIN COUNTY, OHIO

SCALE 1" = 50' FEB. 20, 1952

J. W. WARDEN AND ASSOCIATES REGISTERED SURVEYOR'S