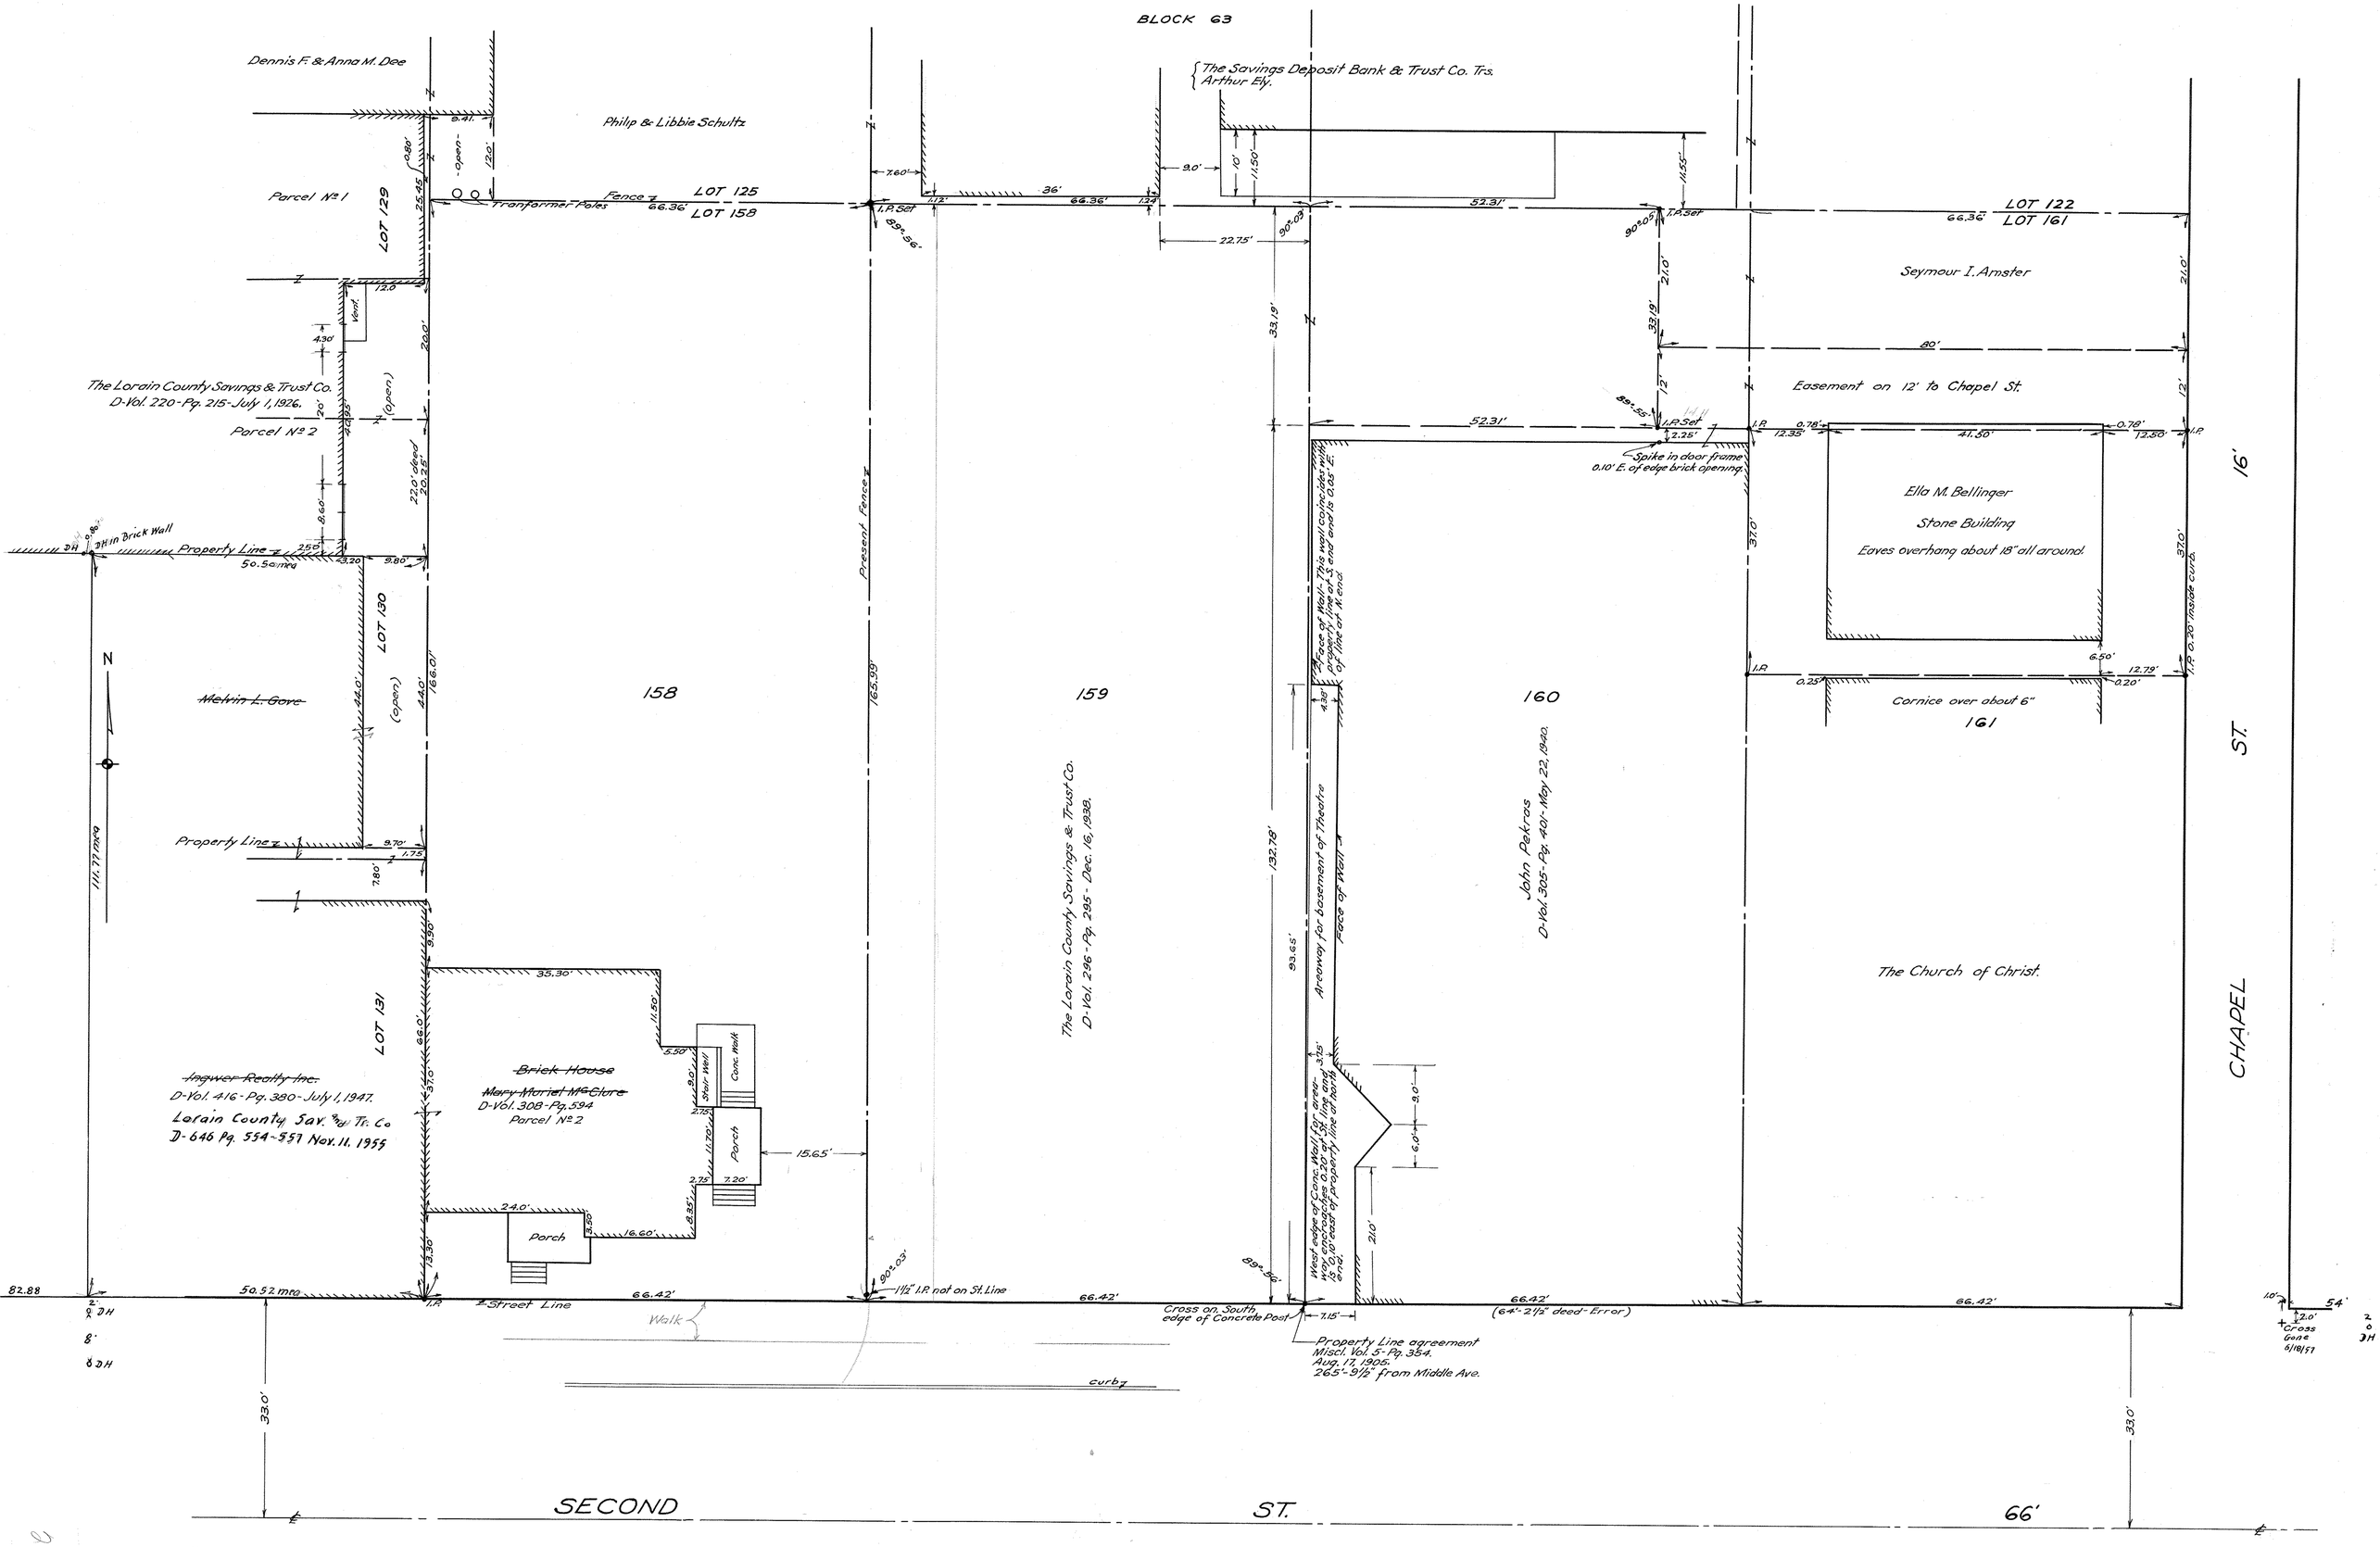

PPN 06-26-063-000-???

MAP Pg 6-120

SURVEY FOR
THE LORAIN COUNTY SAVINGS & TRUST CO.
D-Vol. 220-Pg. 215-July 1, 1926.
D-Vol. 296-Pg. 295-Dec. 16, 1938.
Lots 125-129-130-158-159-160 & 161.
BLOCK 63
Original Village Plat of Elyria.
Map Vol. 3-Pg. 14.
Elyria City, Lorain County, Ohio.
Scale-1"=10' Nov. 10, 1948.
J.W. Warden, Registered Surveyor.
Revised June 18, 1957 D.A.

93-0459

PRN-85