

D. D. ANDRUS & ASSOCIATES

STATE OF OHIO

CIVIL ENGINEERS AND SURVEYORS

REGISTERED } PROFESSIONAL ENG.
SURVEYOR


405 ELYRIA BLOCK

TELEPHONES 322-9828


322-1466

ELYRIA, OHIO 44035

LESTER L. AND MARY L. BOLGERS
D.VOL 389 Page 551 & 553 June 28 1946

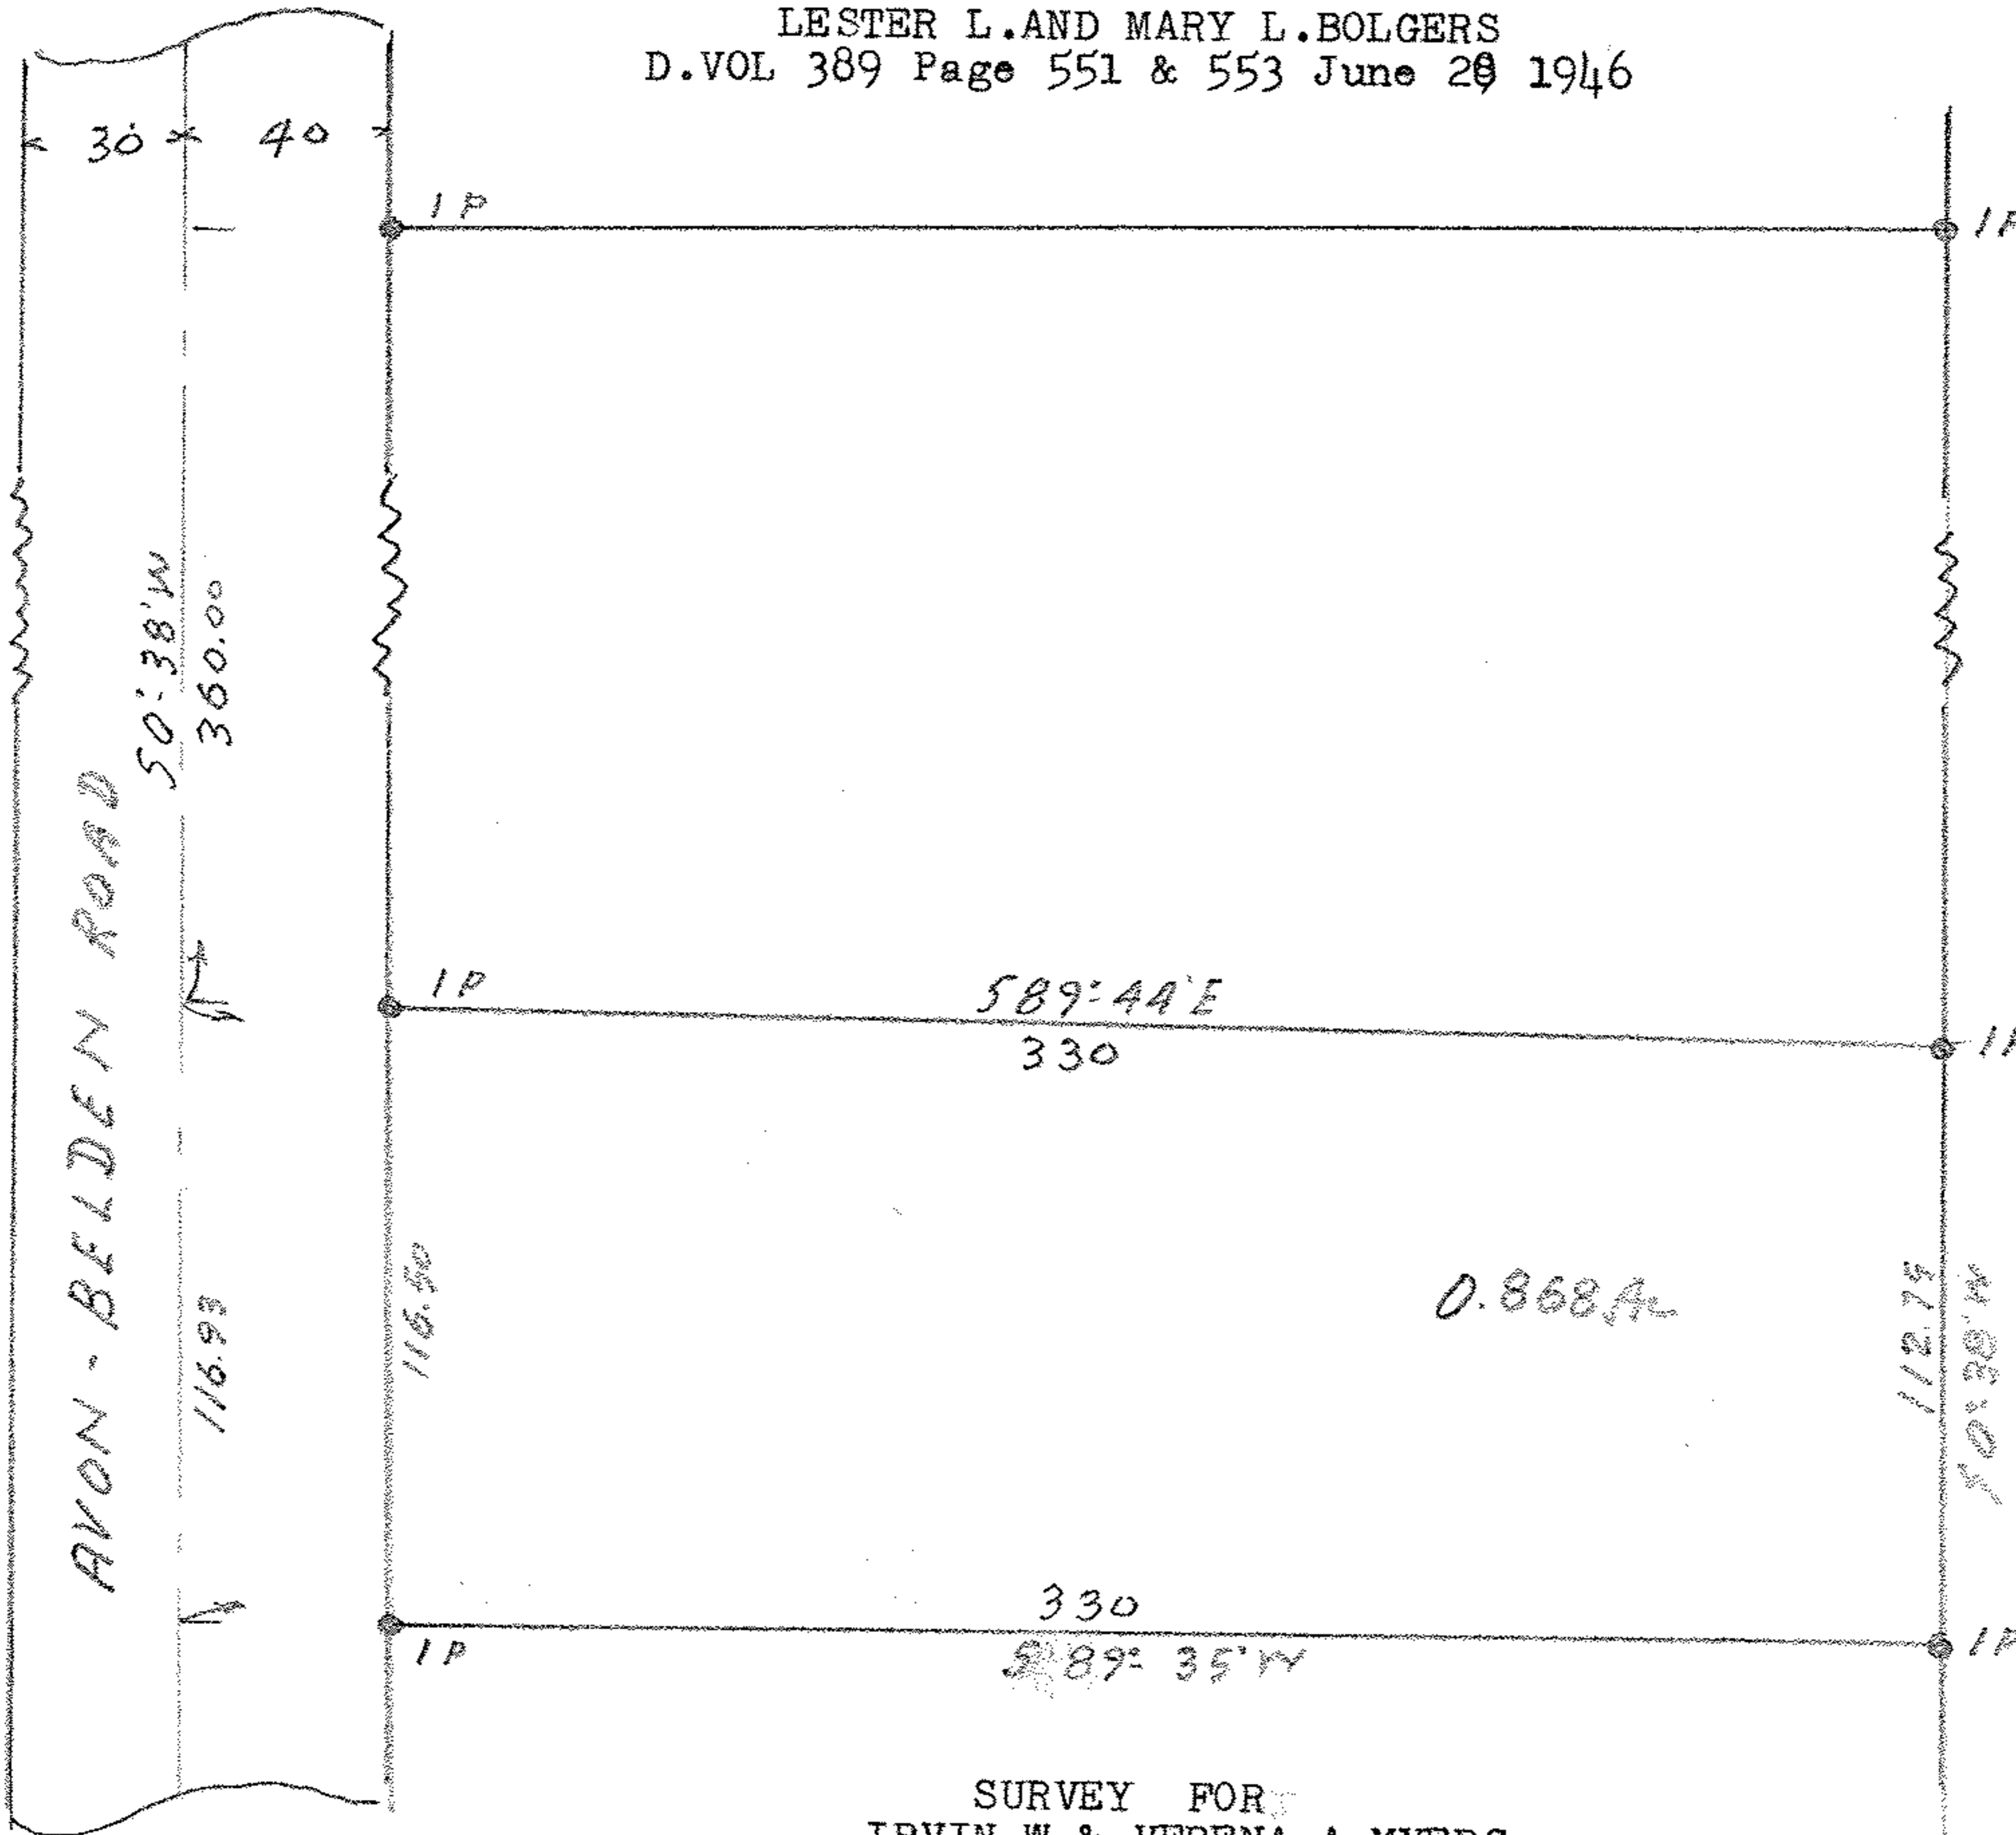

SURVEY FOR
 IRVIN W. & VERENA A. MYERS
 LOT 23 RIDGEVILLE TOWNSHIP
 NORTH RIDGEVILLE CITY LORAIN COUNTY OHIO
 D.VOL.##) 330 Pg. 608 Nov. 7 1943
 Scale 1"=50' July 15 1969

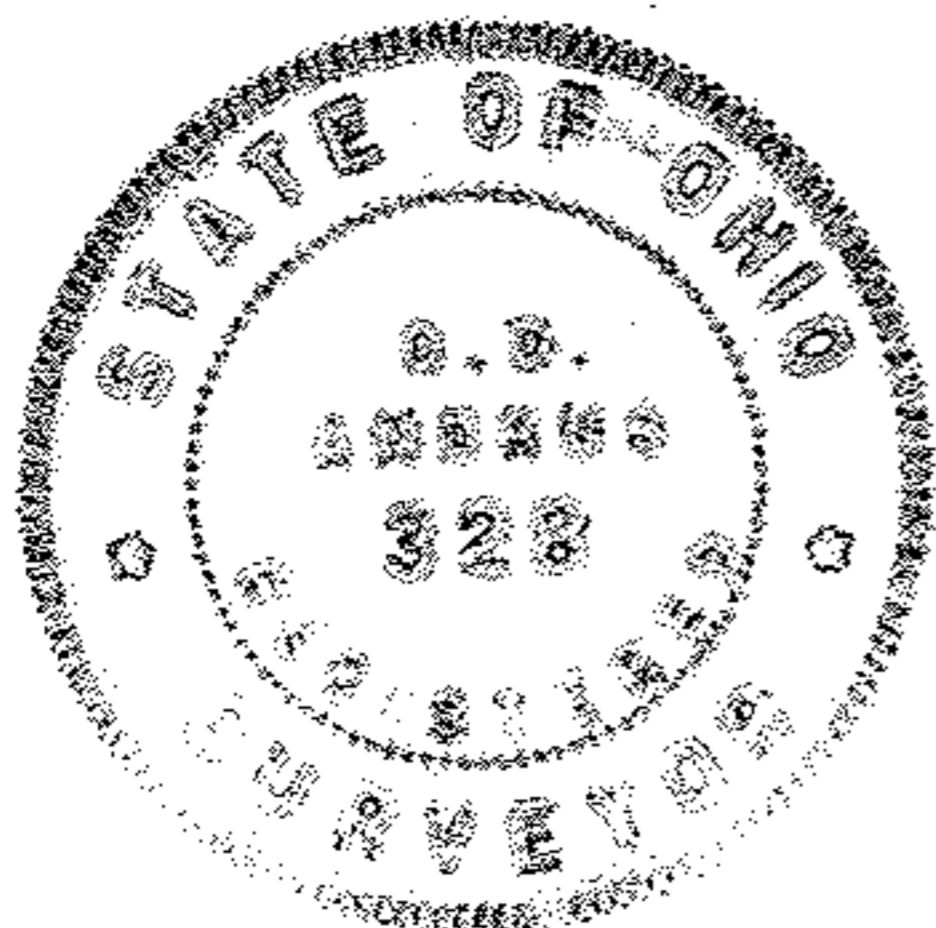

101401