Stella Smith-D.Vol.137-Pg.130. Apr.3, 1915.

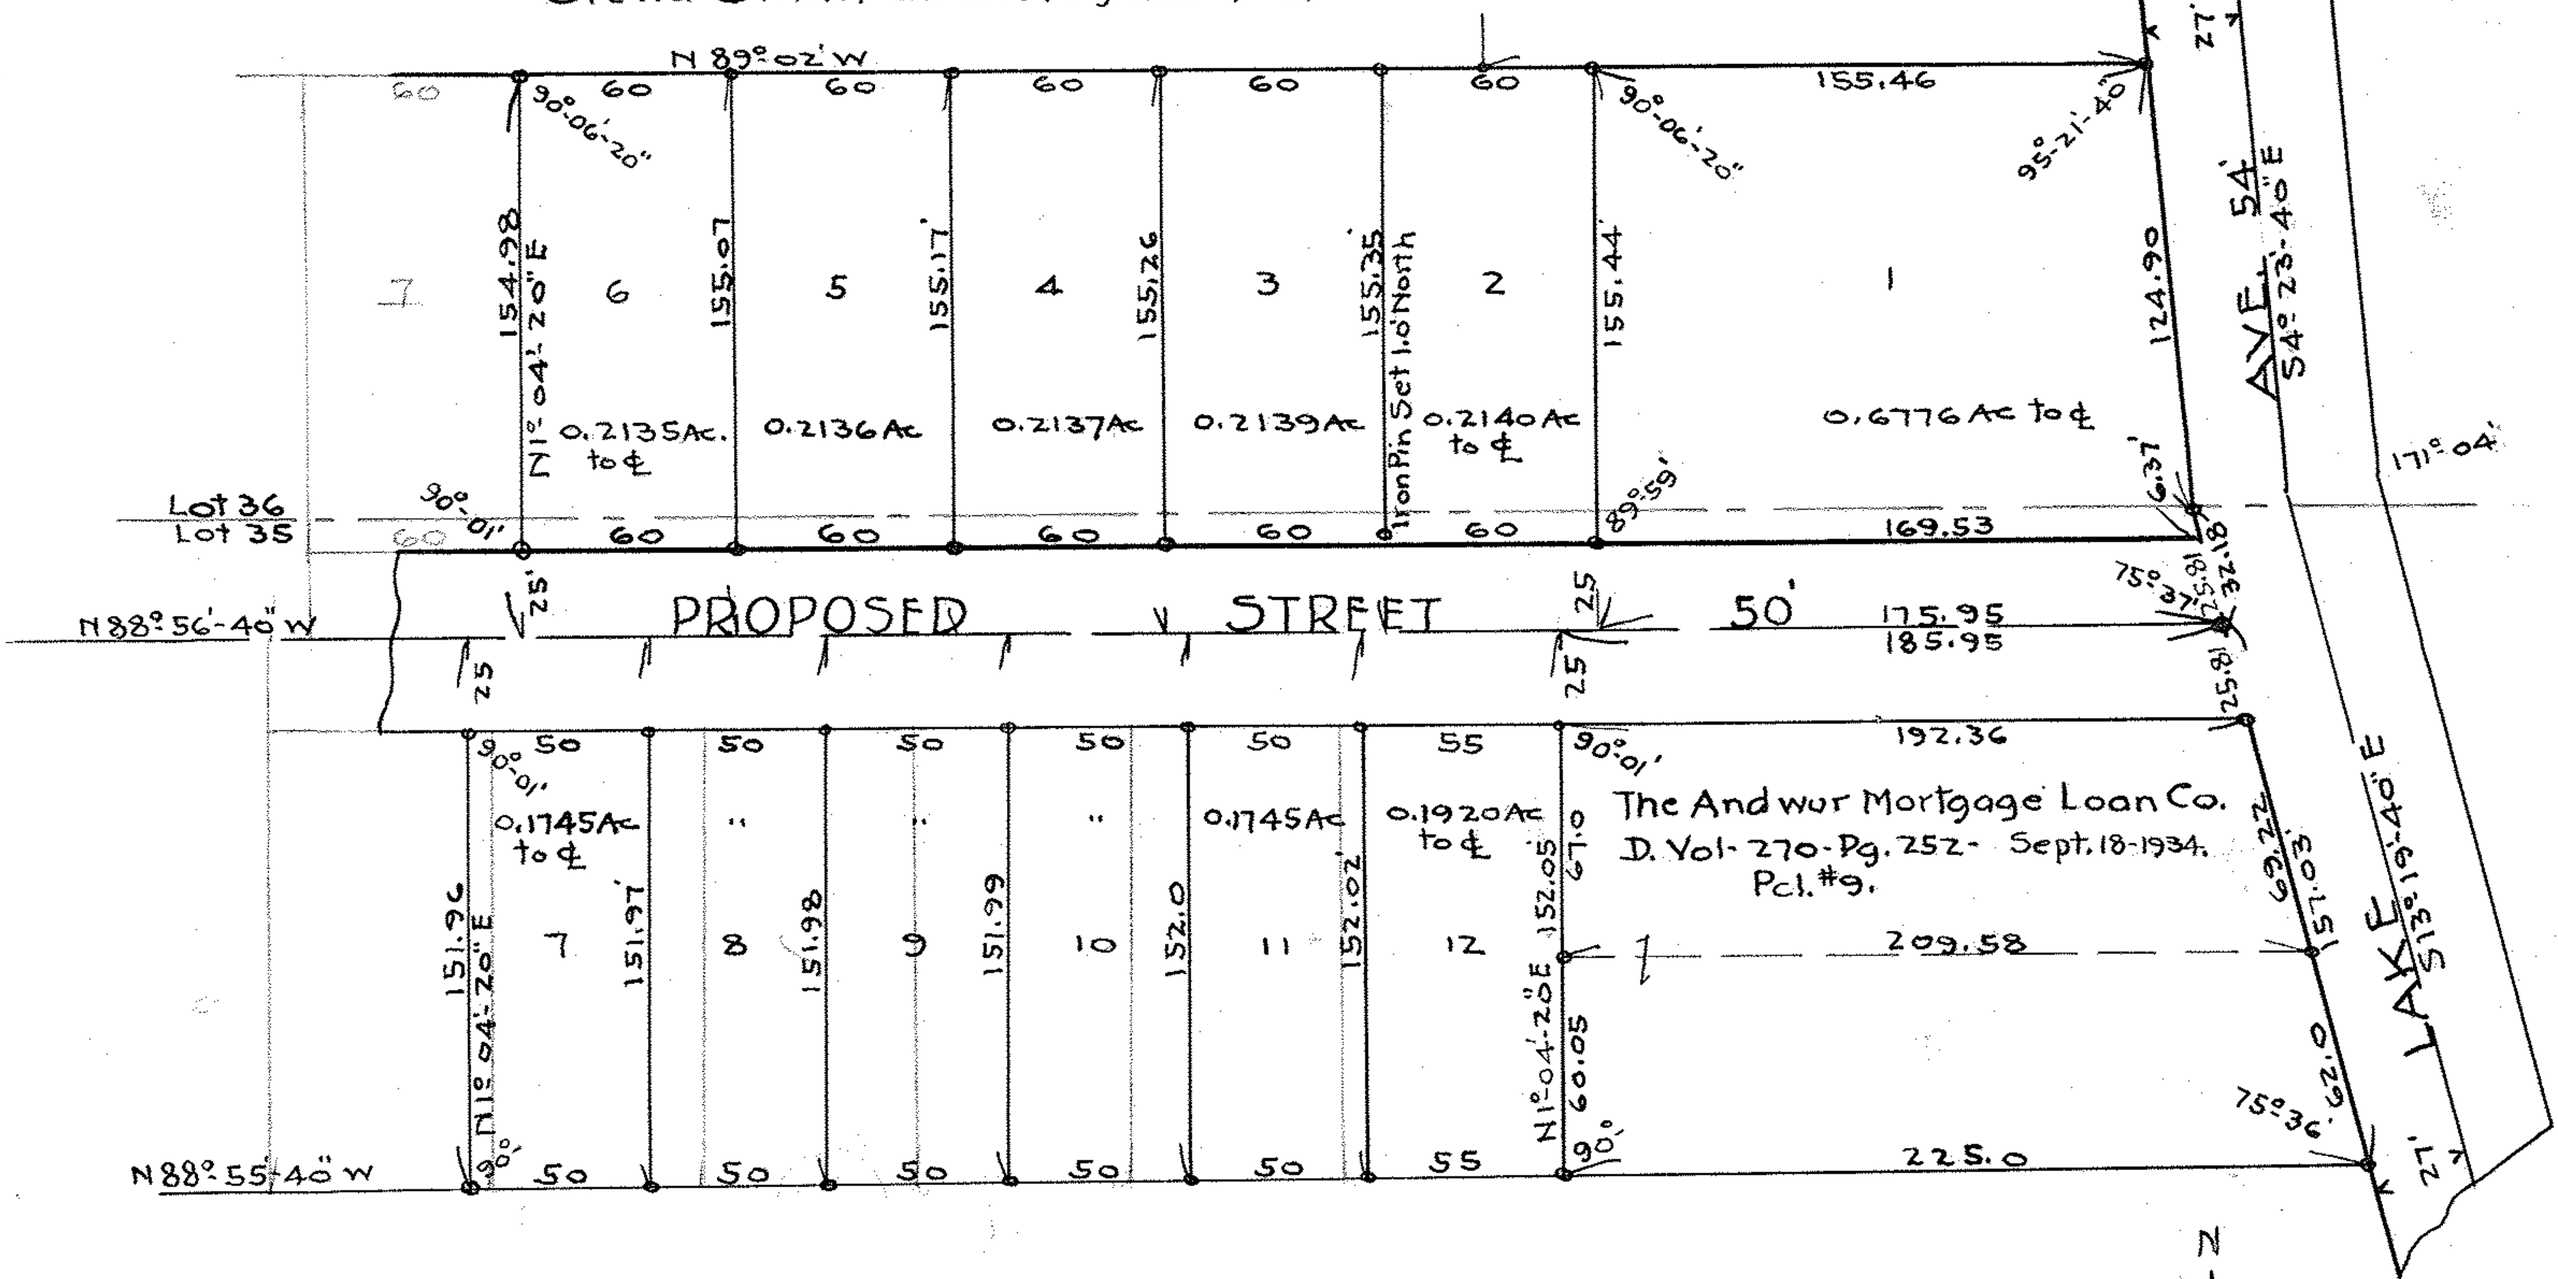

PPN 06-24-035 101-???
06-24-036 101-???

MAP Pg 6-60

Survey for
Ella Baker.
Original Lots 35-36, West of Black River.
Elyria Twp., Lorain Co., Ohio.
Deed Vol.-137-Pg.130. Apr.3, 1915.
Aug. 16, 1939. Scale 1" = 60 feet.
J. W. Warden. Registered Surveyor.

Notes:- Iron Pins were found or set at all points thus o.
Lot distances and acreage on proposed street are to center of Street. Lake Ave. frontage to side line.