1009960C

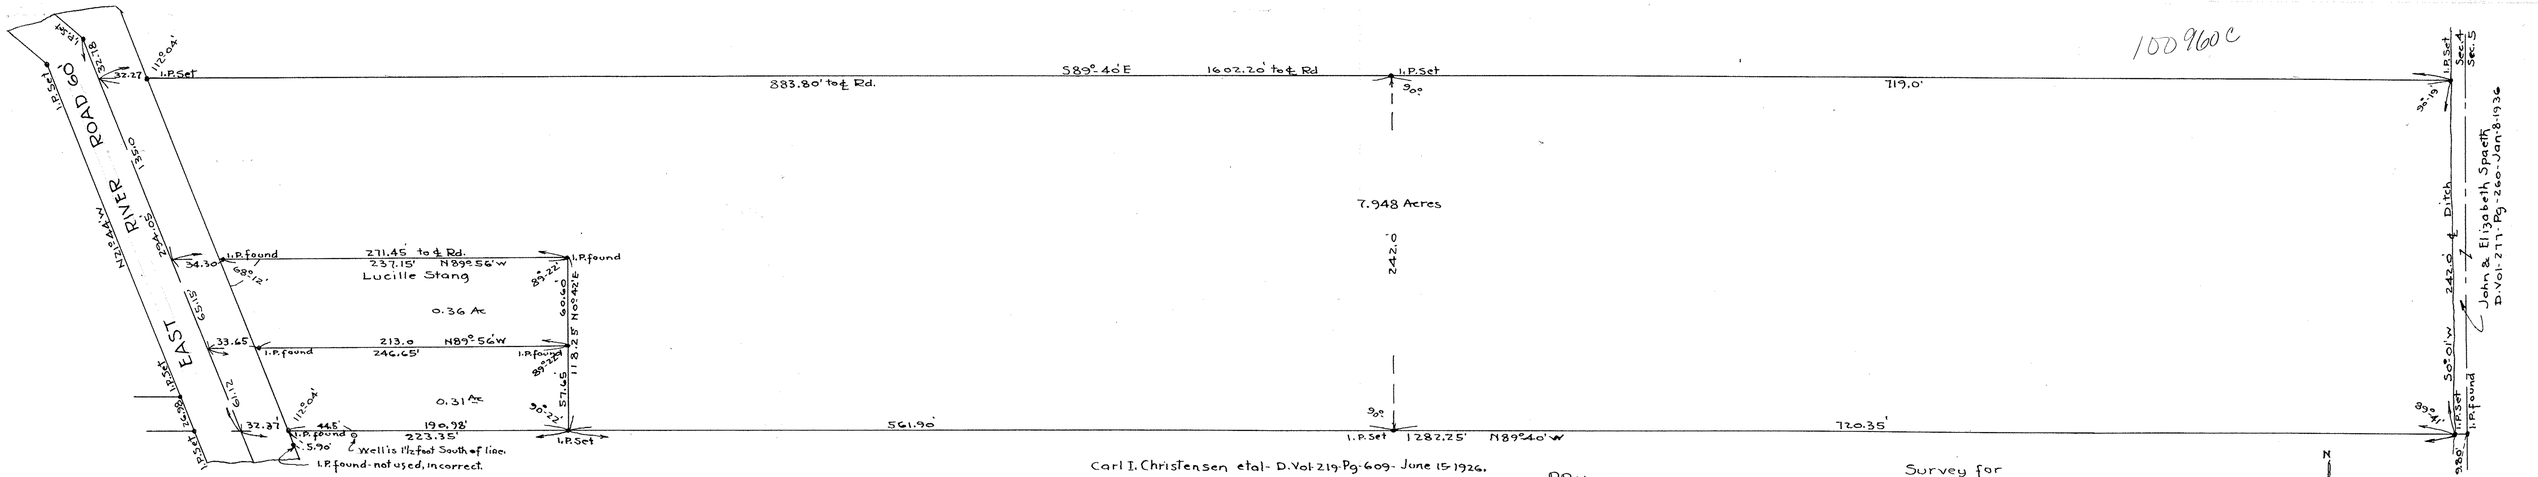

PPN 10-00-004-139.???

MAP Pg 10-00-004-C

Survey for
JOHN H. GRILLS ET AL.
Section-4- Carlisle Twp.,
Lorain Co., Ohio.
Sept. 11, 1946. Scale 1" = 50'.
J.W. Warden, Registered Surveyor.