

PPN 06-24-062-101 ???

MAP PG 699


Survey for  
LELIA M. PRENTISS

Lots #5-6-7-8. Geo. E. Nicholls Addn-Map, Vol. 3, Pg. 7.

Original Lot #62 - West of Black River - City of Elyria.

Sept. 15, 1913. Scale 1" = 50ft. T. L. Gibson, C.E.

North Line of Original Lot #62

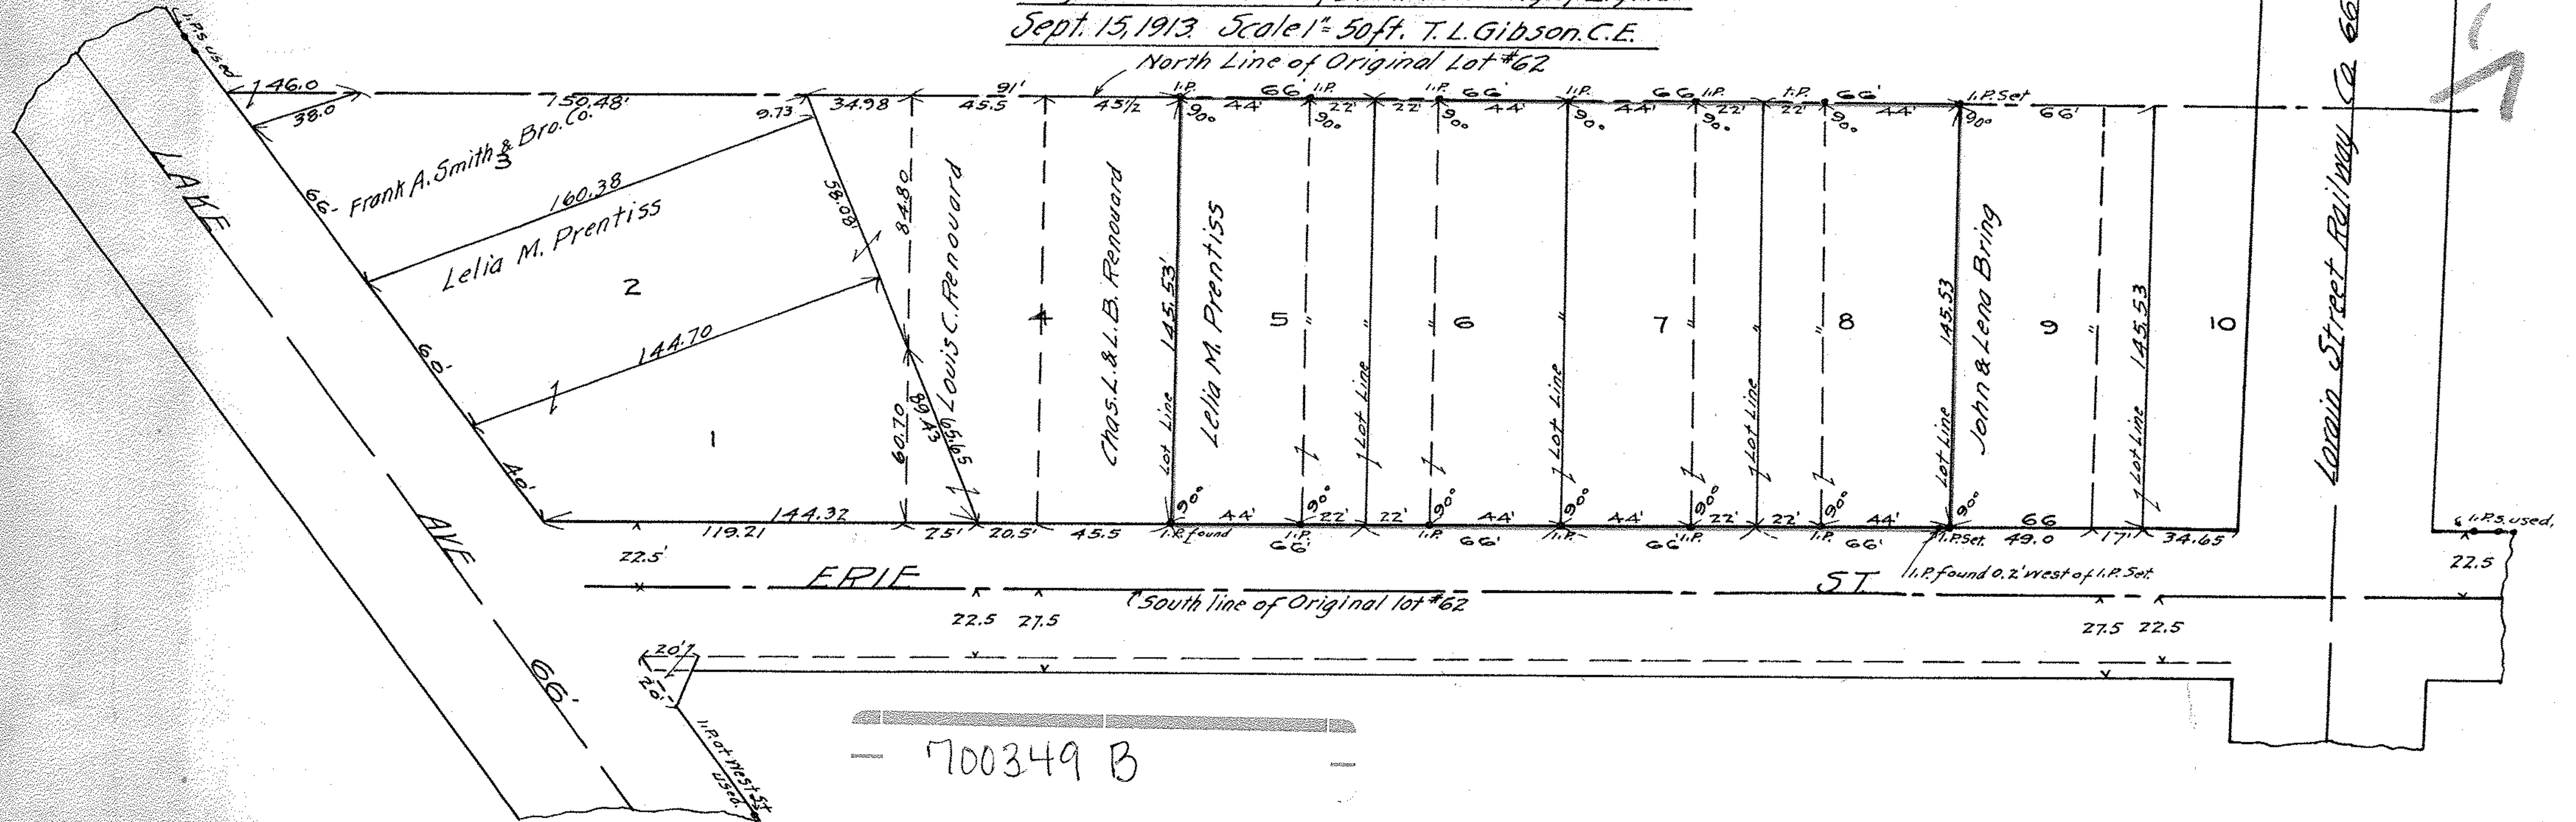

700349 B

700349 B