Meredith O. Barnes - D. Vol - 340 - Pg - 404 - January - 25 - 1945

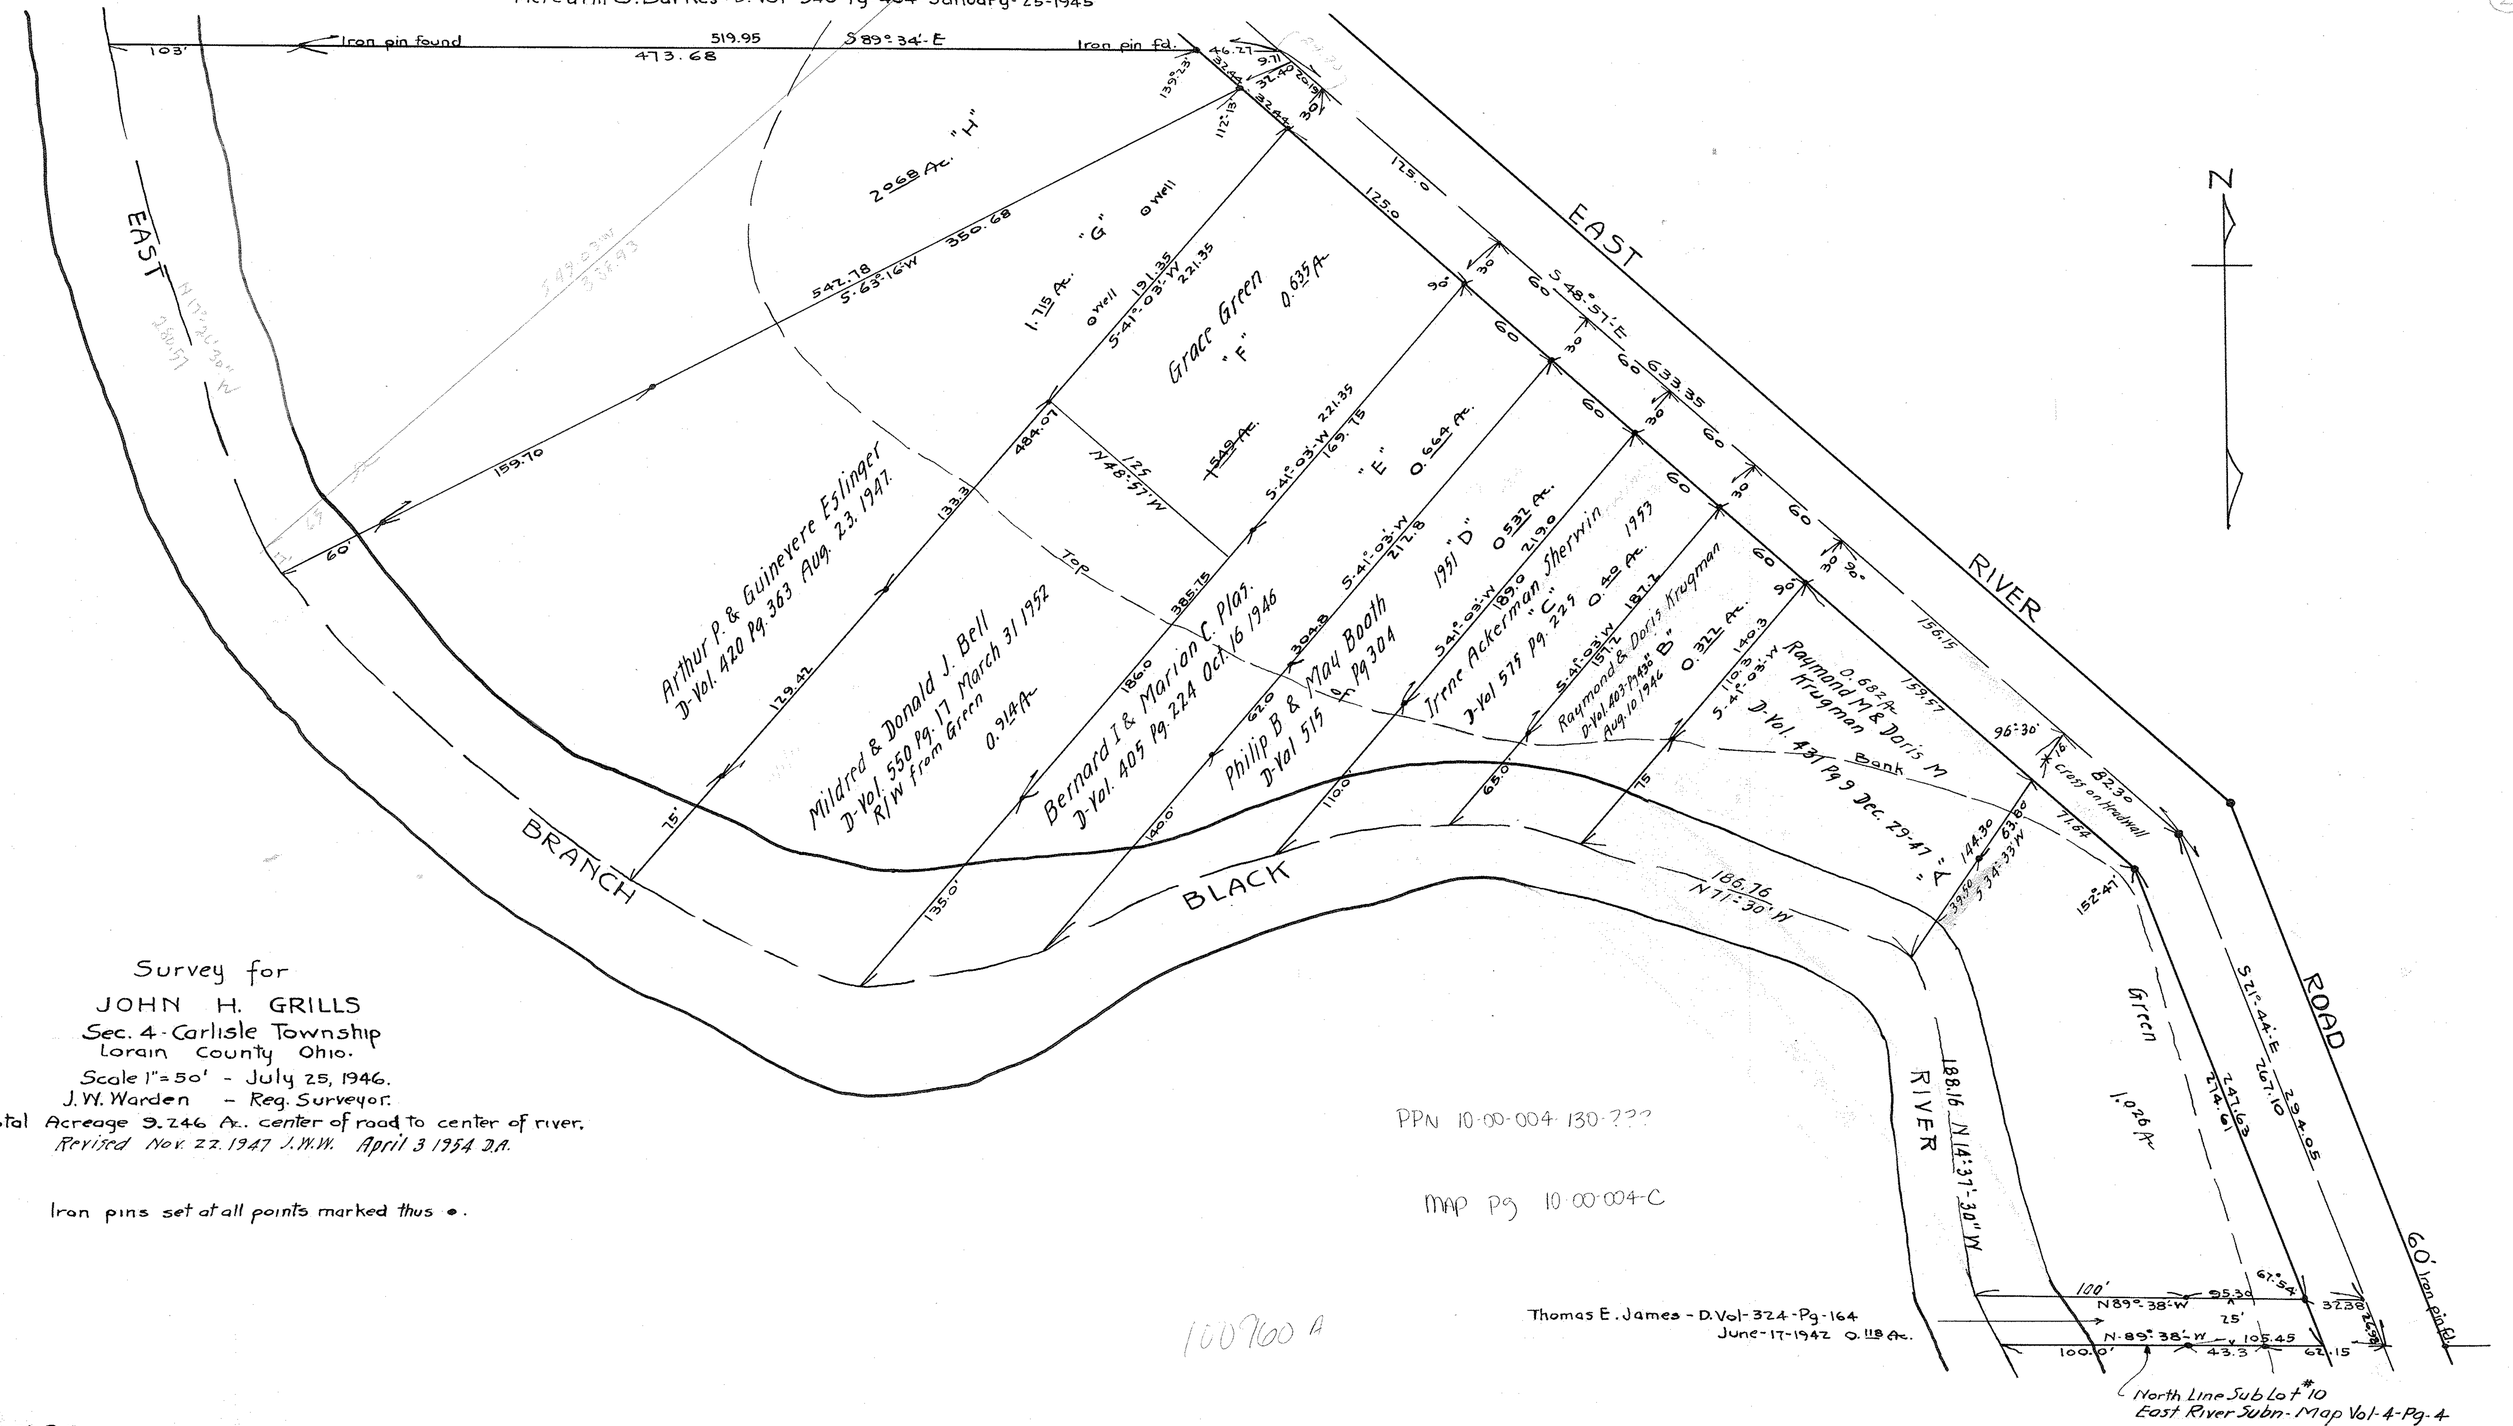

Survey for
JOHN H. GRILLS
Sec. 4 - Carlisle Township
Lorain County Ohio.
Scale 1" = 50' - July 25, 1946.
J. W. Warden - Reg. Surveyor.
Total Acreage 9.246 Ac.. center of road to center of river.
Revised Nov. 22. 1947 J.W.W. April 3 1954 D.A.

Iron pins set at all points marked thus •.

PPN 10-00-004-130-???

Map pg 10-00-004-C

100760 A

F.B.-54-Pg-7