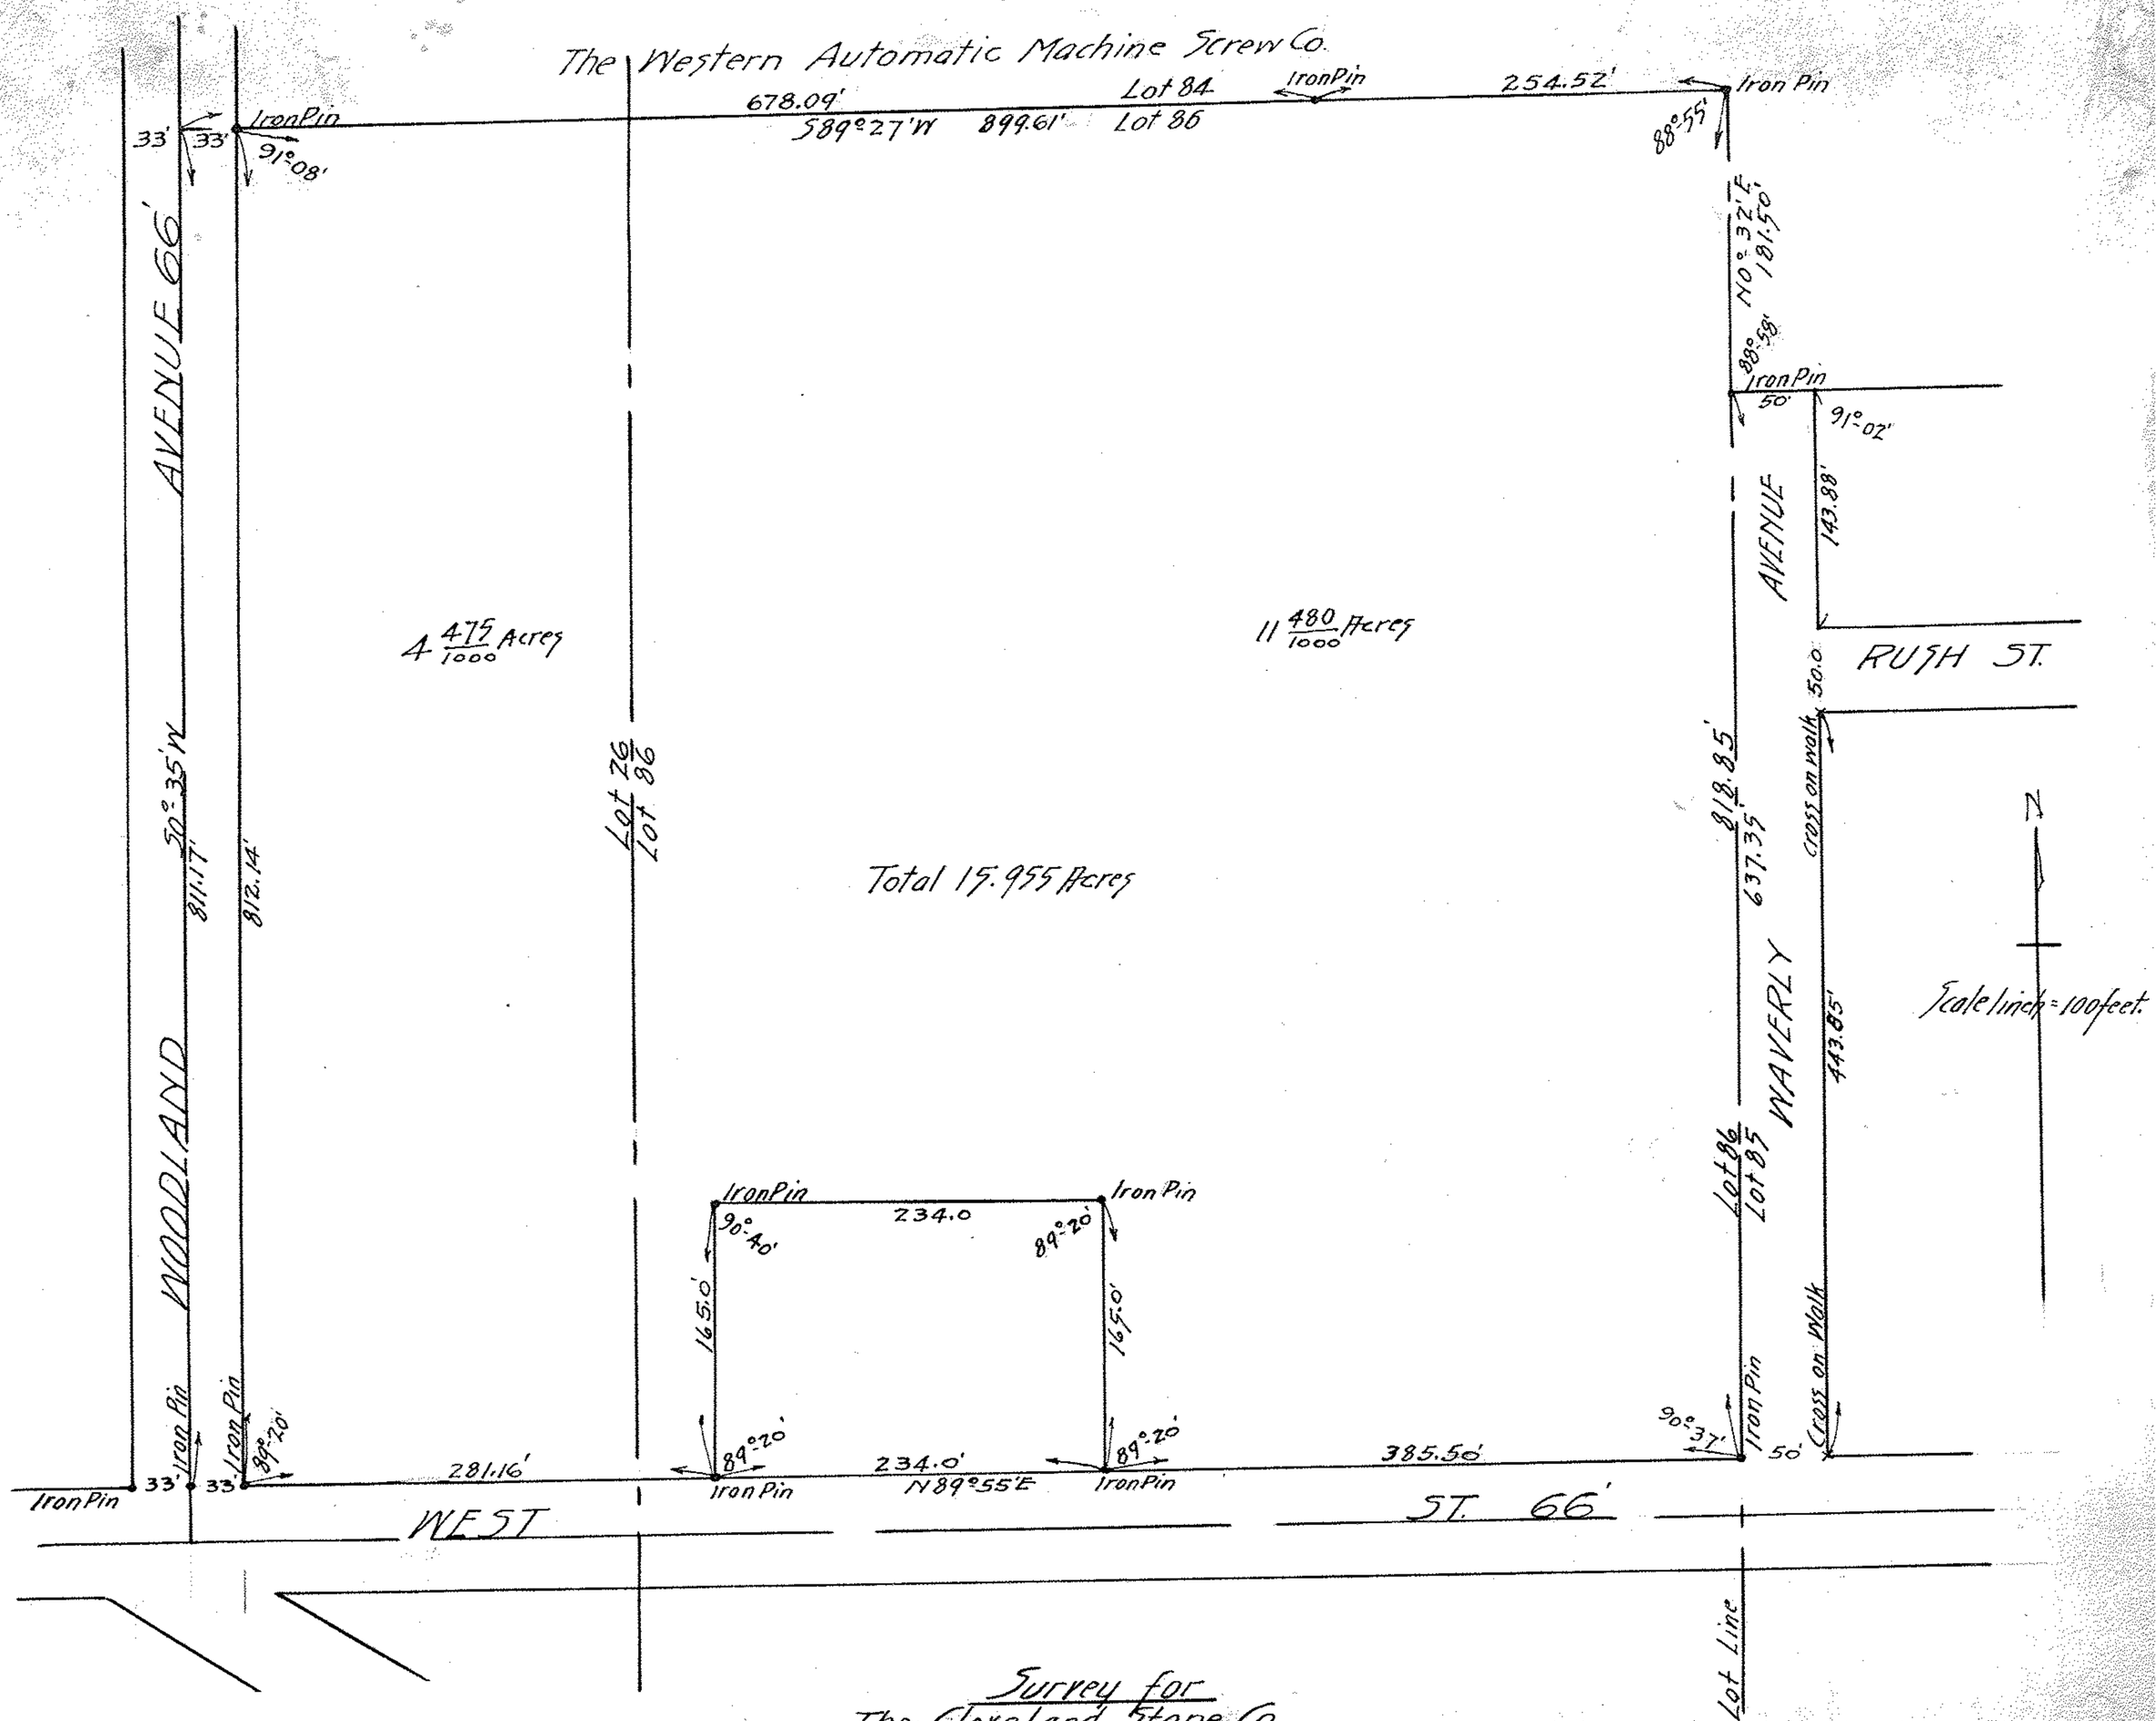

Survey for
The Cleveland Stone Co.,
Lots 26-86. West of Black River,
Elyria - Lorain Co., Ohio.
Sept. 22-1919. Warden & Saundow
Surveyors.

PPN 06-24-026-124-8??

MAP PG 6-79

700132

J-135