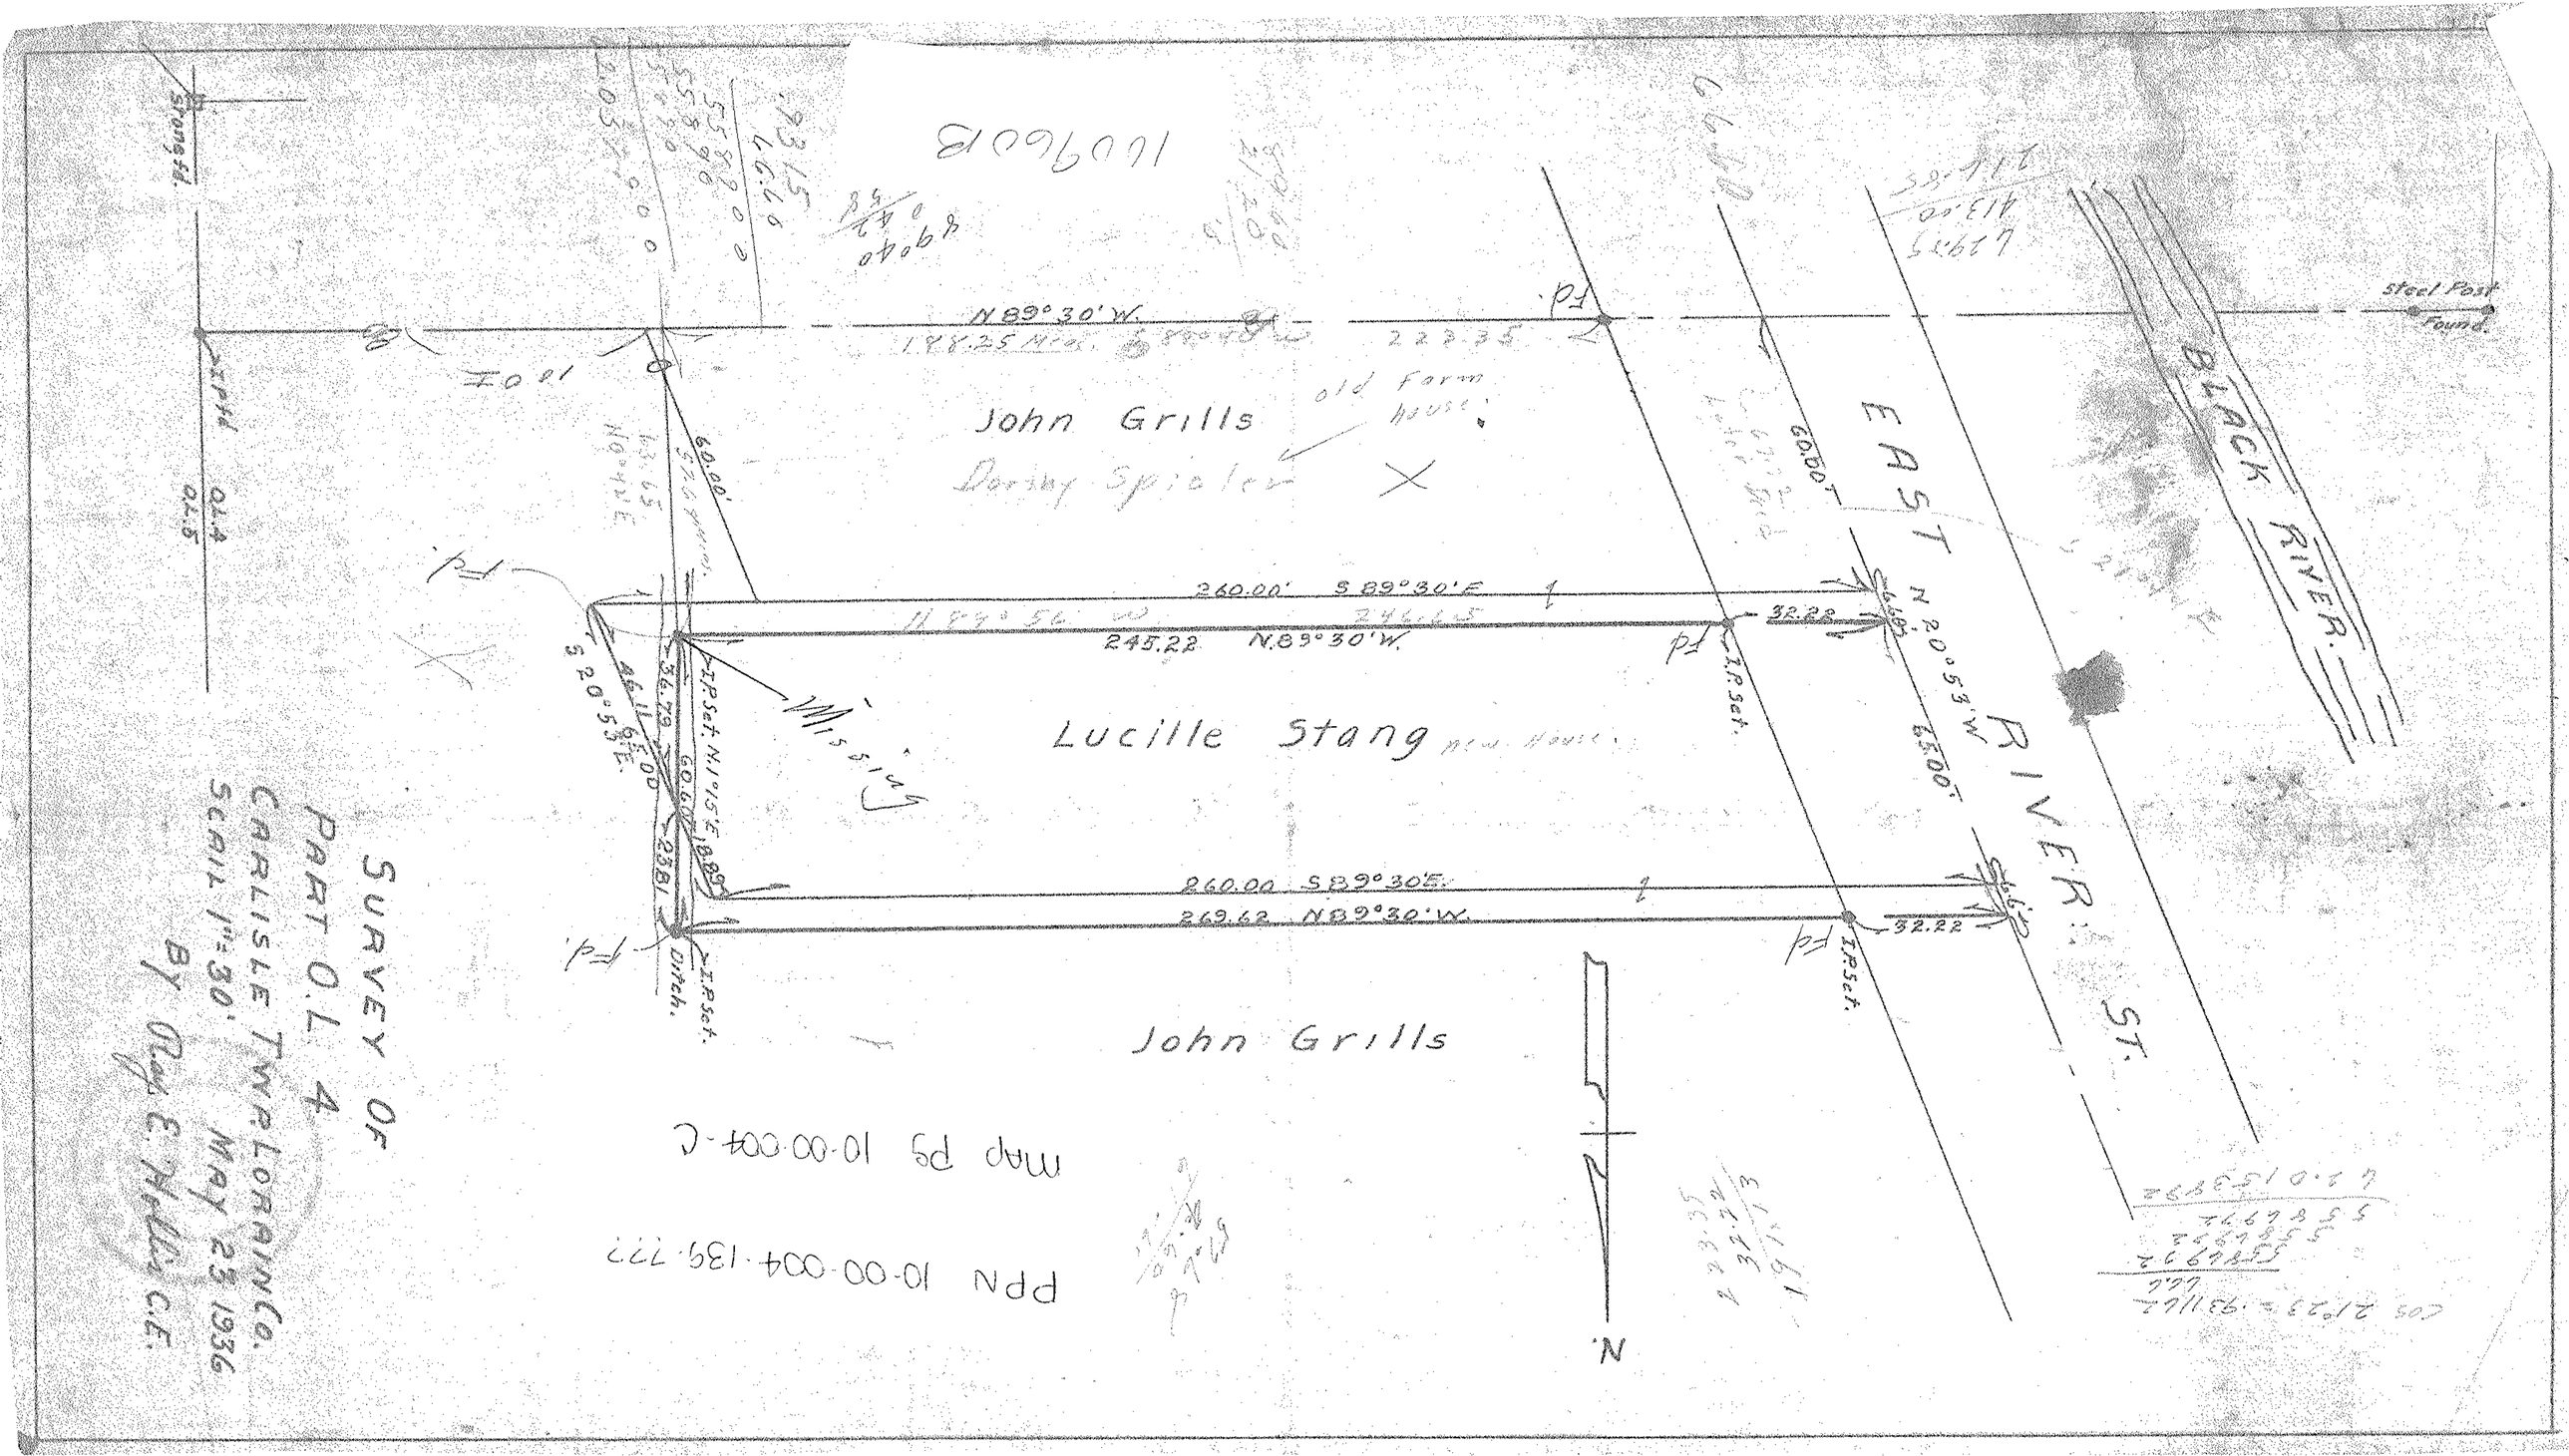

SURVEY OF
PART O.L. 4
CARLISLE TWP. LORAIN CO.
SCALE 1"=30' MAY 23 1936
BY Ray E. Phillips C.E.

PPN 10-00-004-139.777

Map PG 10-00-004-C