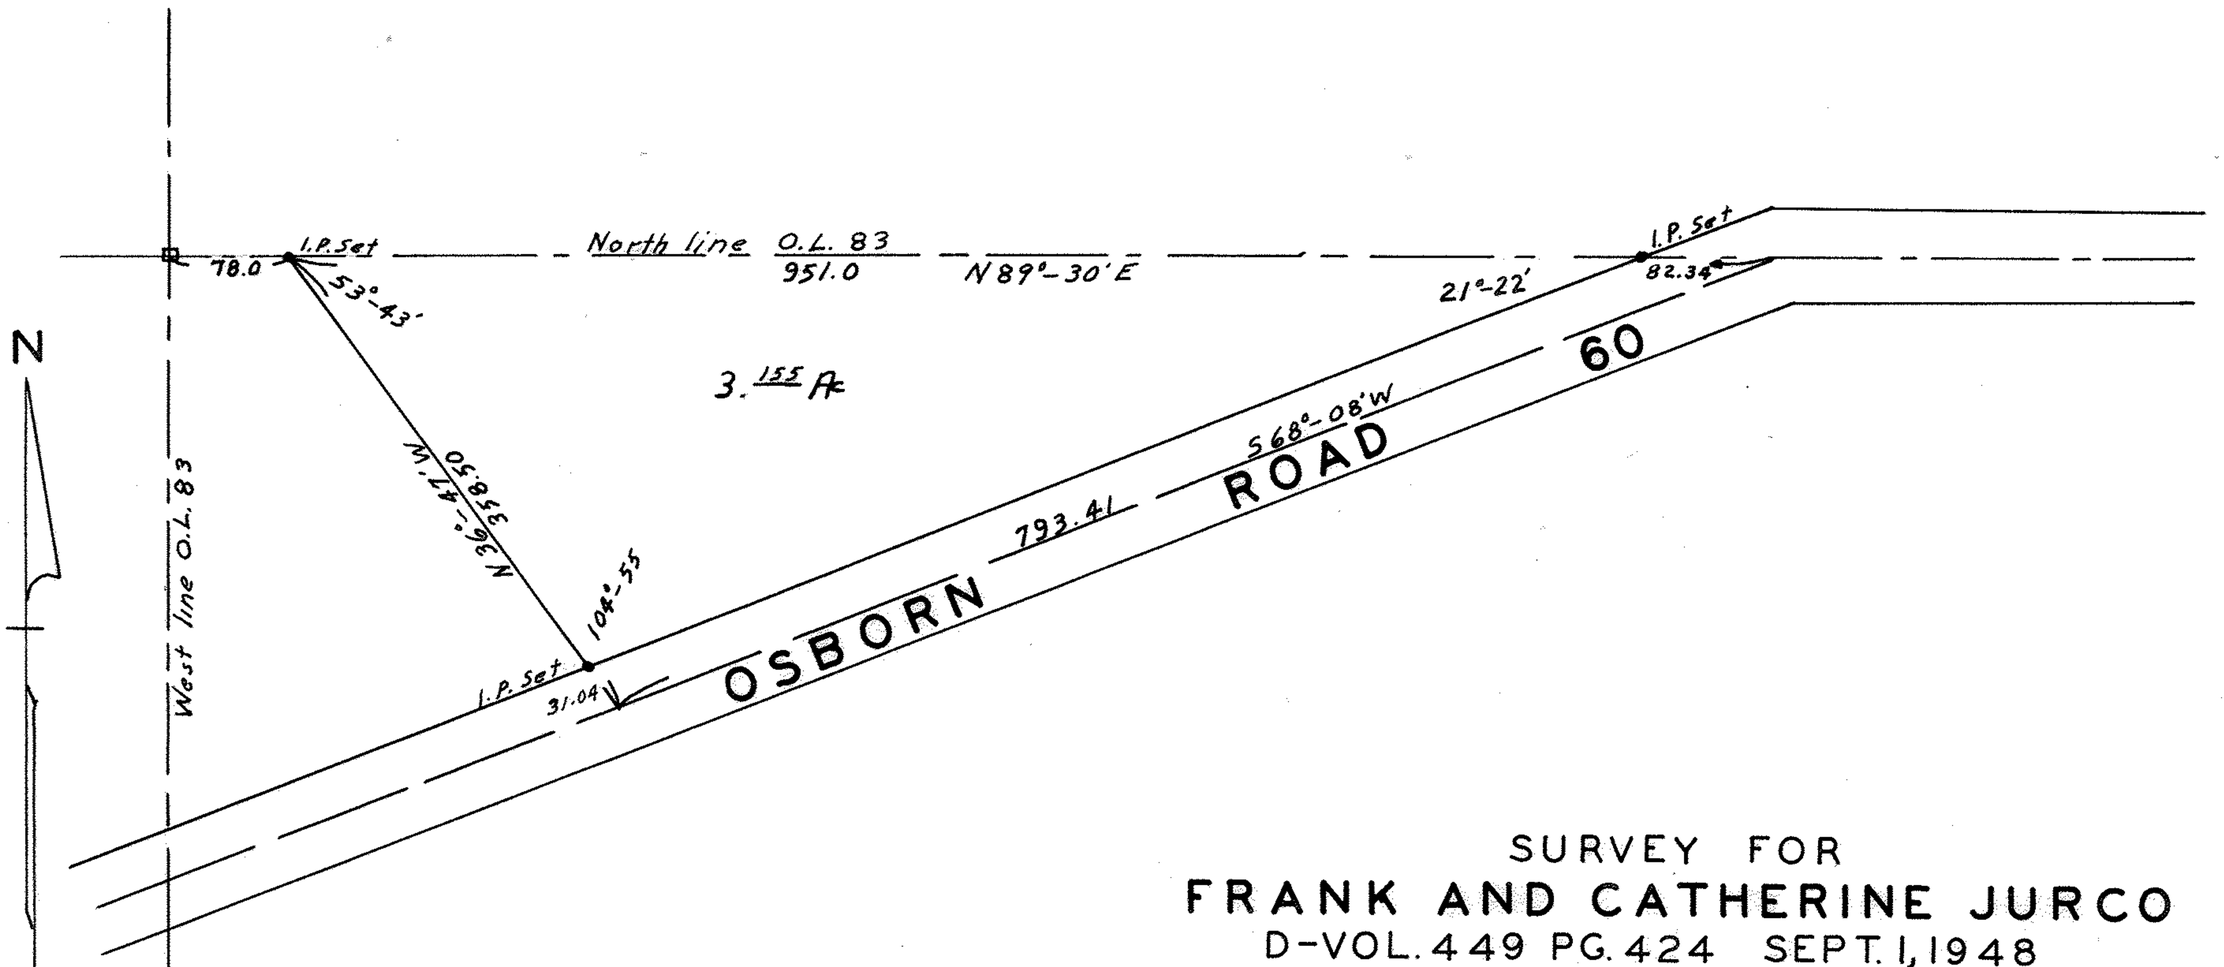

PPN 12-00-083-000-???

MAP PG 12-00-083-A

SURVEY FOR

FRANK AND CATHERINE JURCO

D-VOL. 449 PG. 424 SEPT. 1, 1948

ORIGINAL LOT 83 COLUMBIA TWP.

LORAIN COUNTY, OHIO

SCALE 1" = 100' MAY 28, 1954

J. W. WARDEN AND ASSOCIATES REG. SURVEYORS

14-1195A

7-30