SURVEY—TOPO AND LOCATION MAP
FOR
EVA MAE CROSBY
SUB LOTS 273-274-275 PART OF 272
HOLLYWOOD ADDITION
O.L. 74 RUSSIA TOWNSHIP
OBERLIN CITY LORAIN COUNTY OHIO
SCALE 1" = 10' MAY 20, 1964
J.W. WARDEN AND ASSOCIATES REG. SURVEYORS

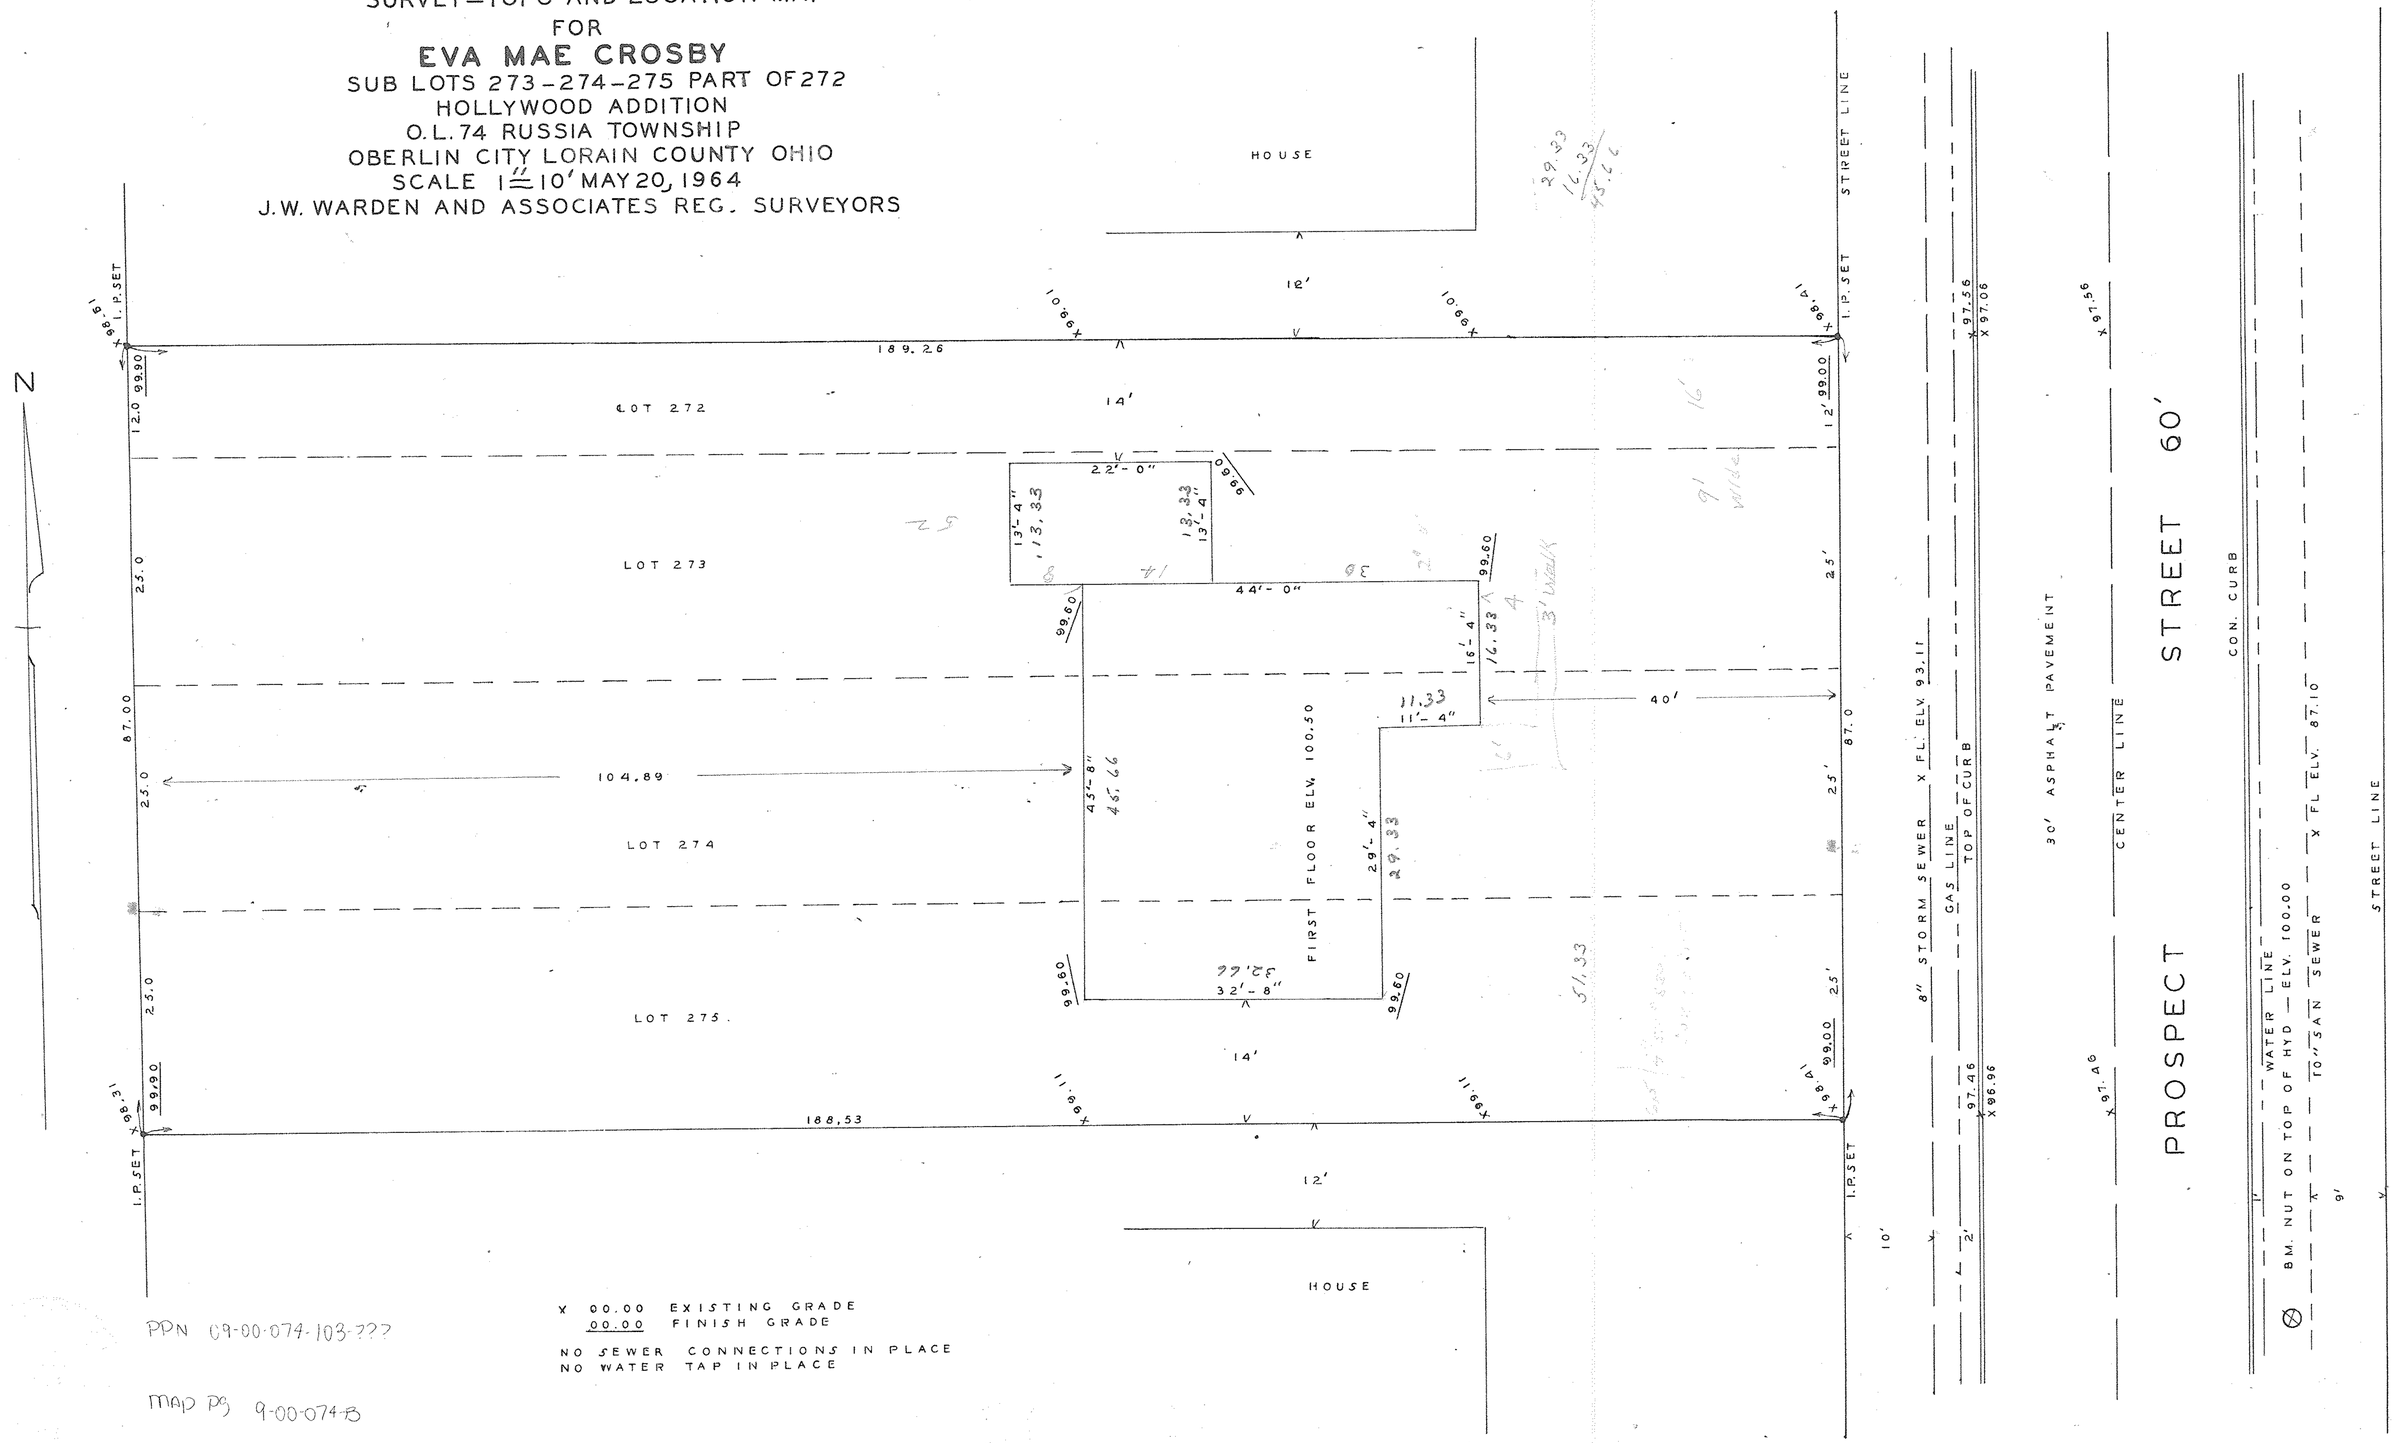

X 00.00 EXISTING GRADE
00.00 FINISH GRADE

NO SEWER CONNECTIONS IN PLACE
NO WATER TAP IN PLACE

PPN 09-00-074-103-???

MAP PG 9-00-074-B