


Mary T<sup>nd</sup> Elsie J. Bayne  
 D-Vol 326 Pg. 594 April 9 1943

Elmer Johnson Post N: 118  
 American Legion of Ohio.  
 D-Vol. 342 Pg. 141 Aug. 24 1944

ROYCE J & MARGUERITE L HUTCHINSON  
 D-Vol 327 Pg 148 Feb. 27 1943

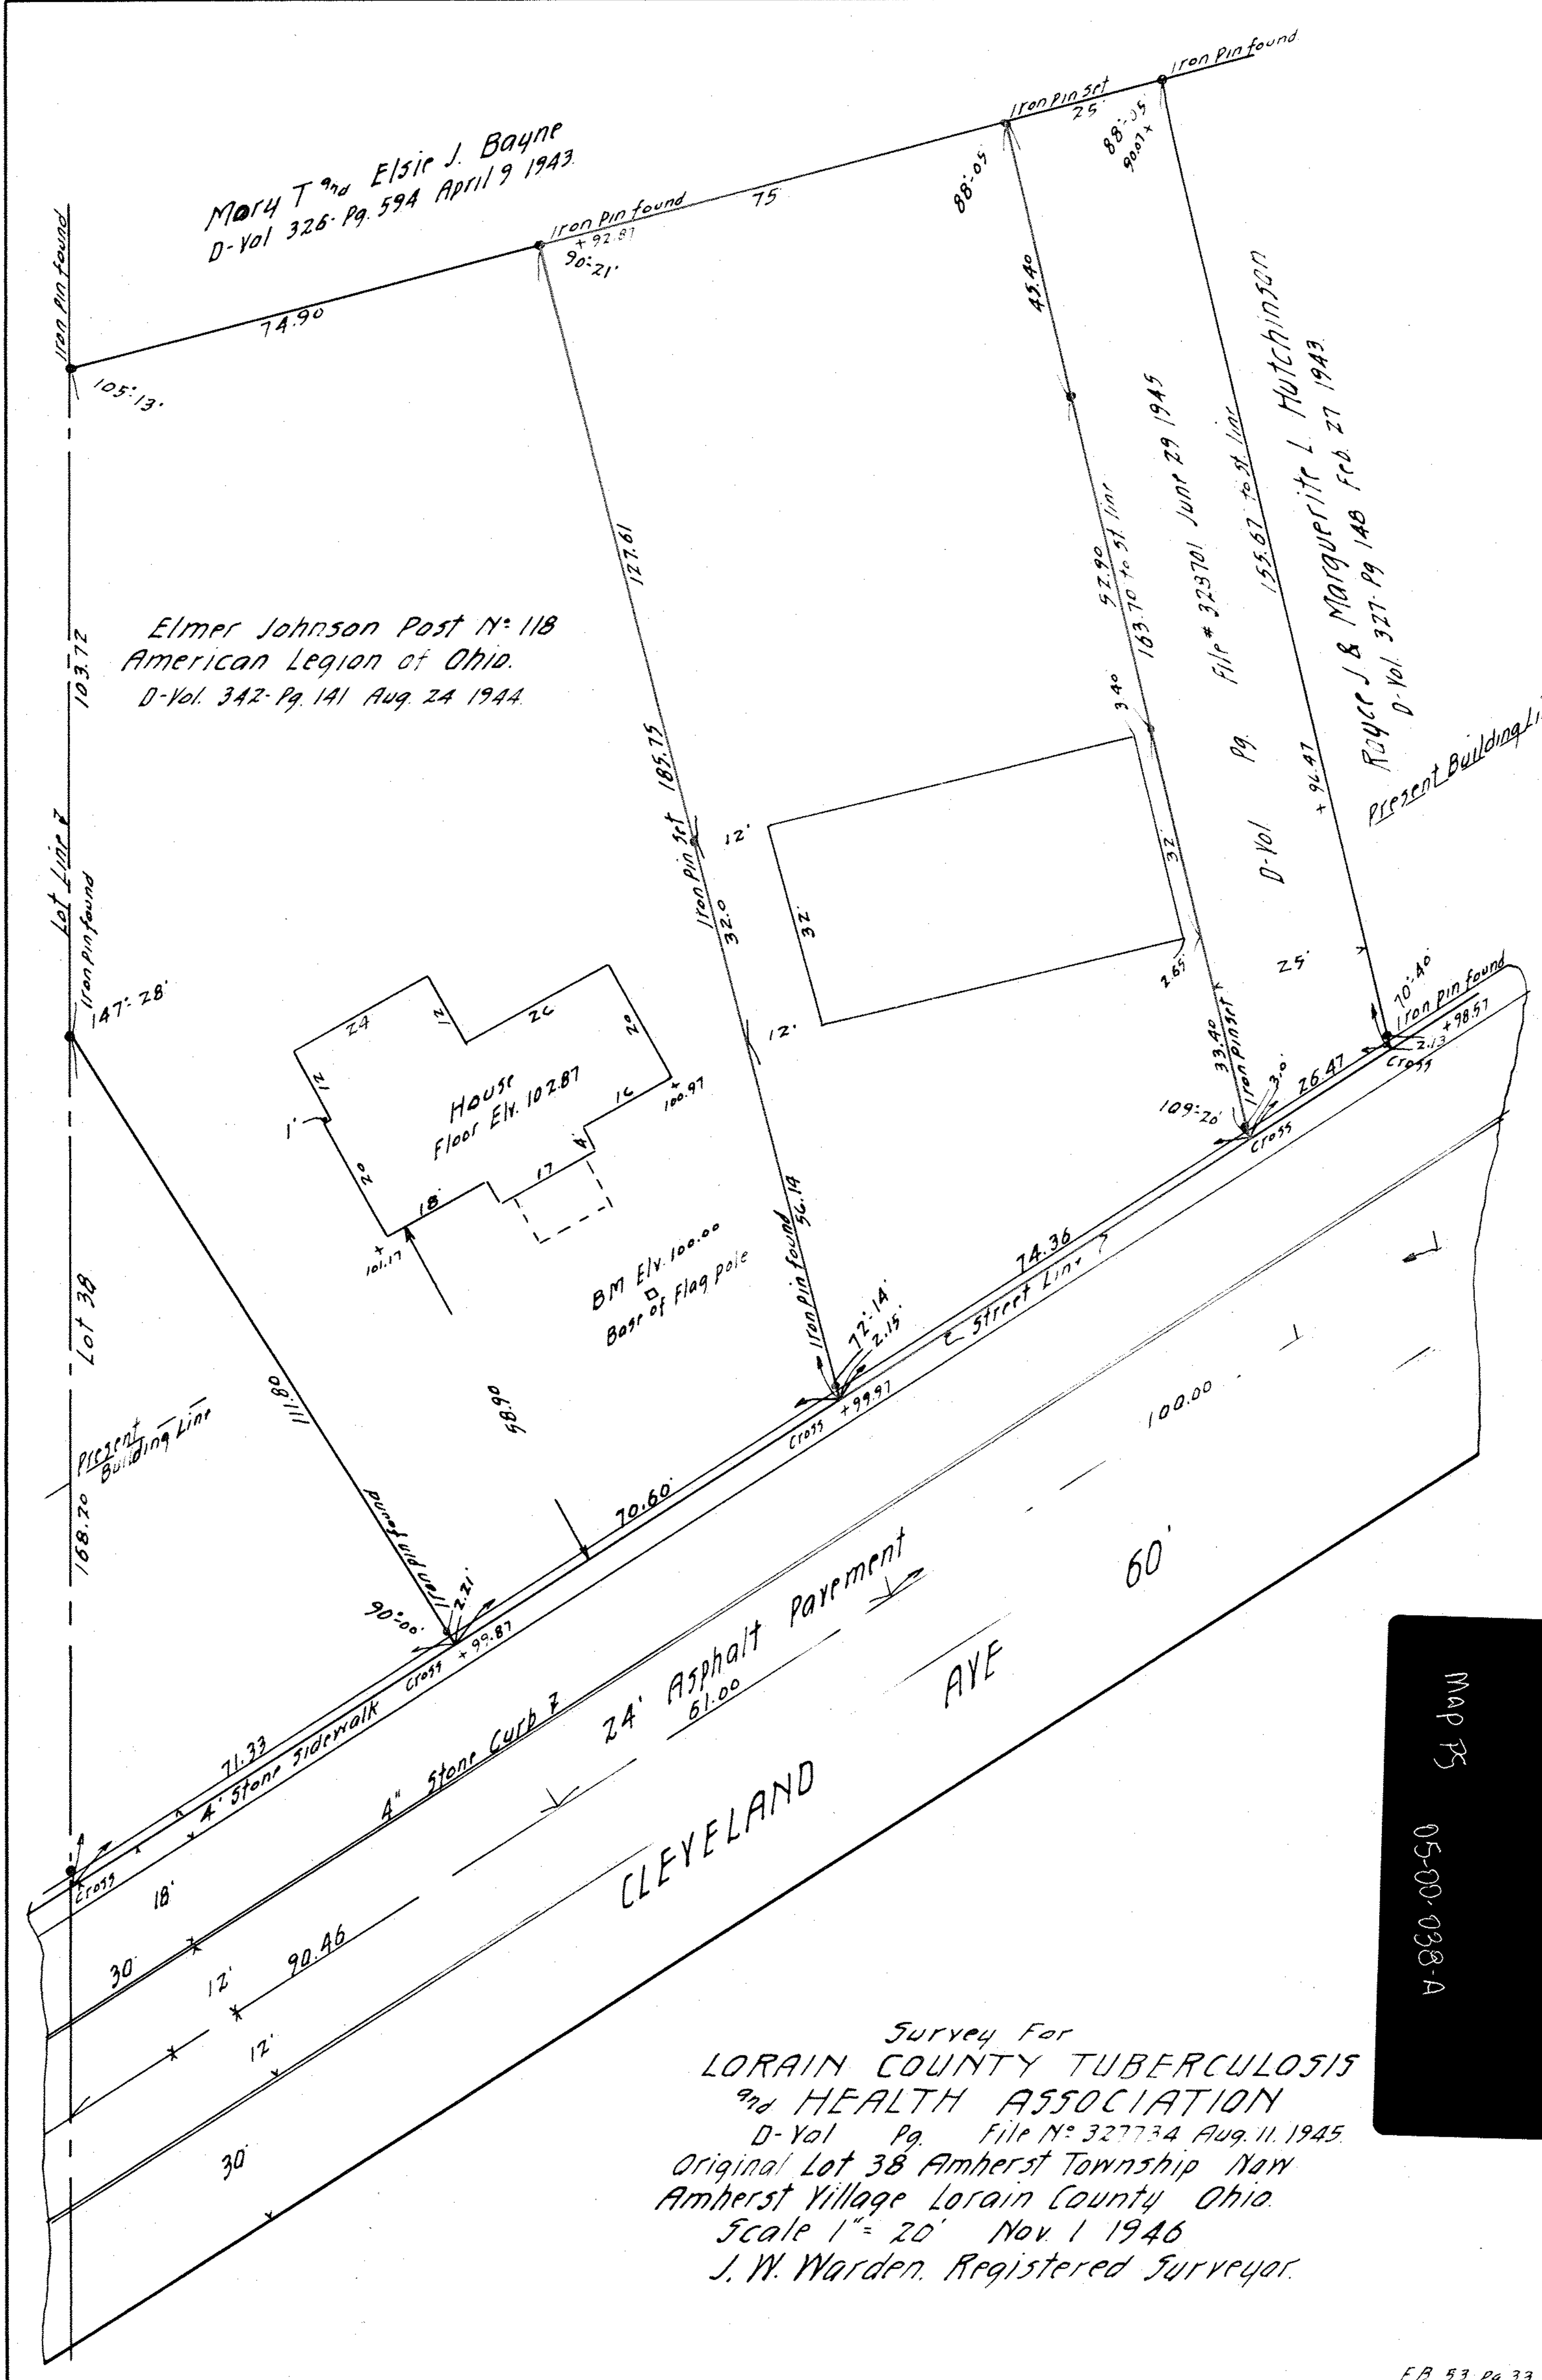

Survey For  
 LORAIN COUNTY TUBERCULOSIS  
 and HEALTH ASSOCIATION  
 D-Vol Pg. File N: 327734 Aug. 11, 1945.  
 Original Lot 38 Amherst Township New  
 Amherst Village Lorain County Ohio.  
 Scale 1" = 20' Nov 1 1946  
 J. W. Warden, Registered Surveyor.

PPN 05-00-038.101-012  
 MAP 75  
 05-00-038-A