
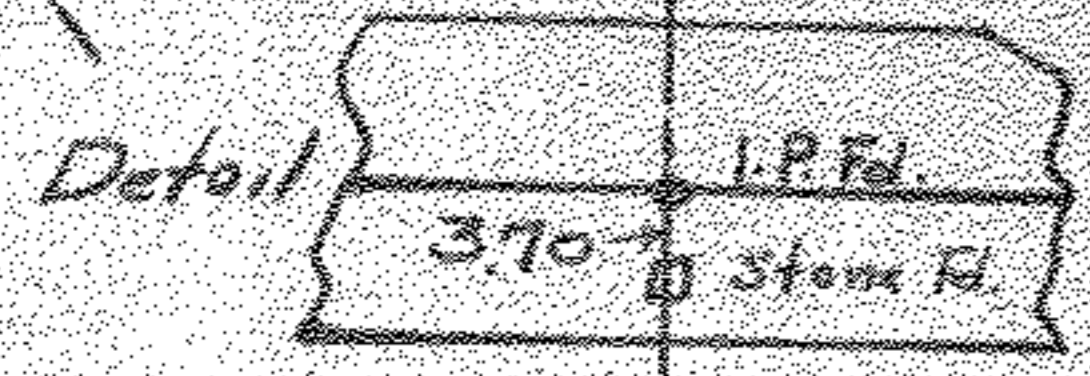


Elyria Twp.

Rd. Rec. Vol 1 Pg 347  
" " " " 3 " 505

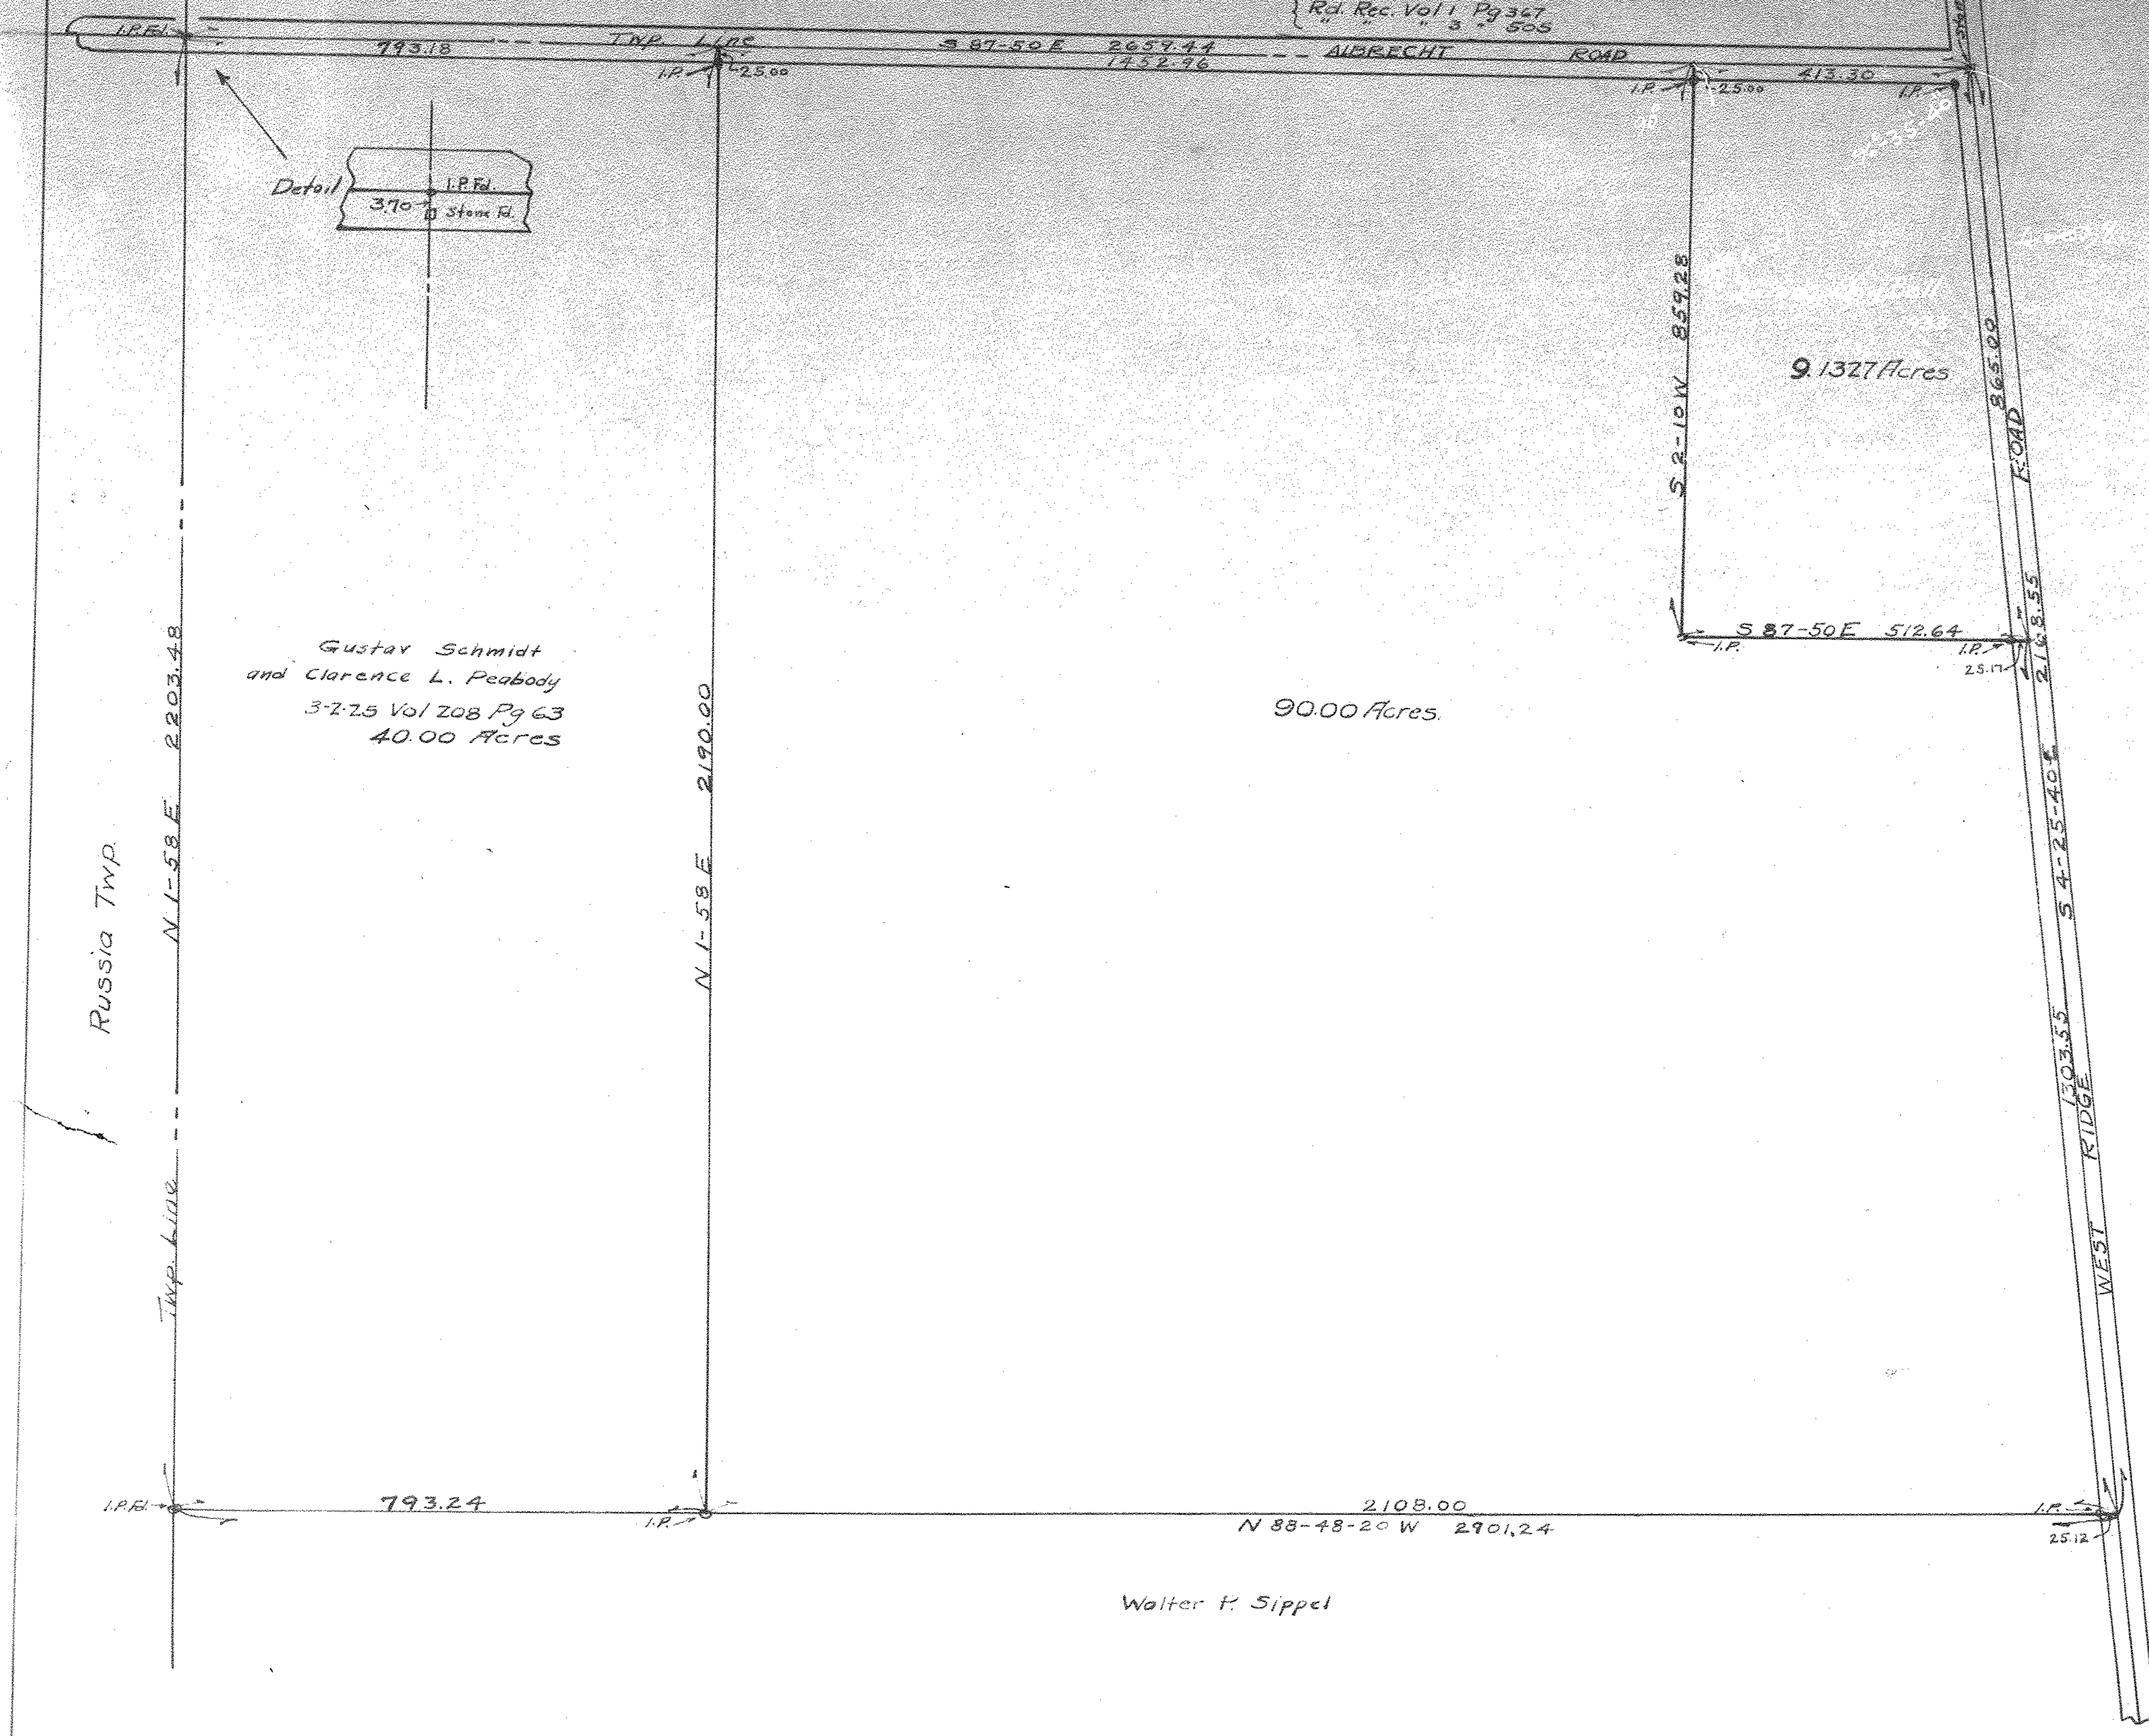

Gustav Schmidt  
and Clarence L. Peabody  
3-2-25 Vol 208 Pg 63  
40.00 Acres

90.00 Acres.

9.1327 Acres

857.28  
262.77  
594.51

N

SURVEY FOR  
Wm. BELL

Section 1 Carlisle Twp.  
Scale: 1" = 200' August 1926  
Warden and Haundon Engr's

Russia Twp.

N 1-58 E 2203.48

N 1-58 E 2190.00

793.24

2108.00  
N 88-48-20 W 2901.24

25.12

Walter F. Sippel

PPN 10-00-001-101-043  
MAP P9 10-00-001-B