JOHN & LAURA ROSE.

Sections 4 and 5, Carlisle Twp.,
Lorain Co., Ohio.

Scale 1 inch = 100 ft. January 18, 1932.

Warden and Launder.
Civil Engineers, Elyria, Ohio.
Revised March 31, 1941.
J. W. Warden.
Revised Dec. 11, 1943.

Total Acreage = 70.606 Acres
44.211 Acres = Section #5.
26.395 Acres = " #4.

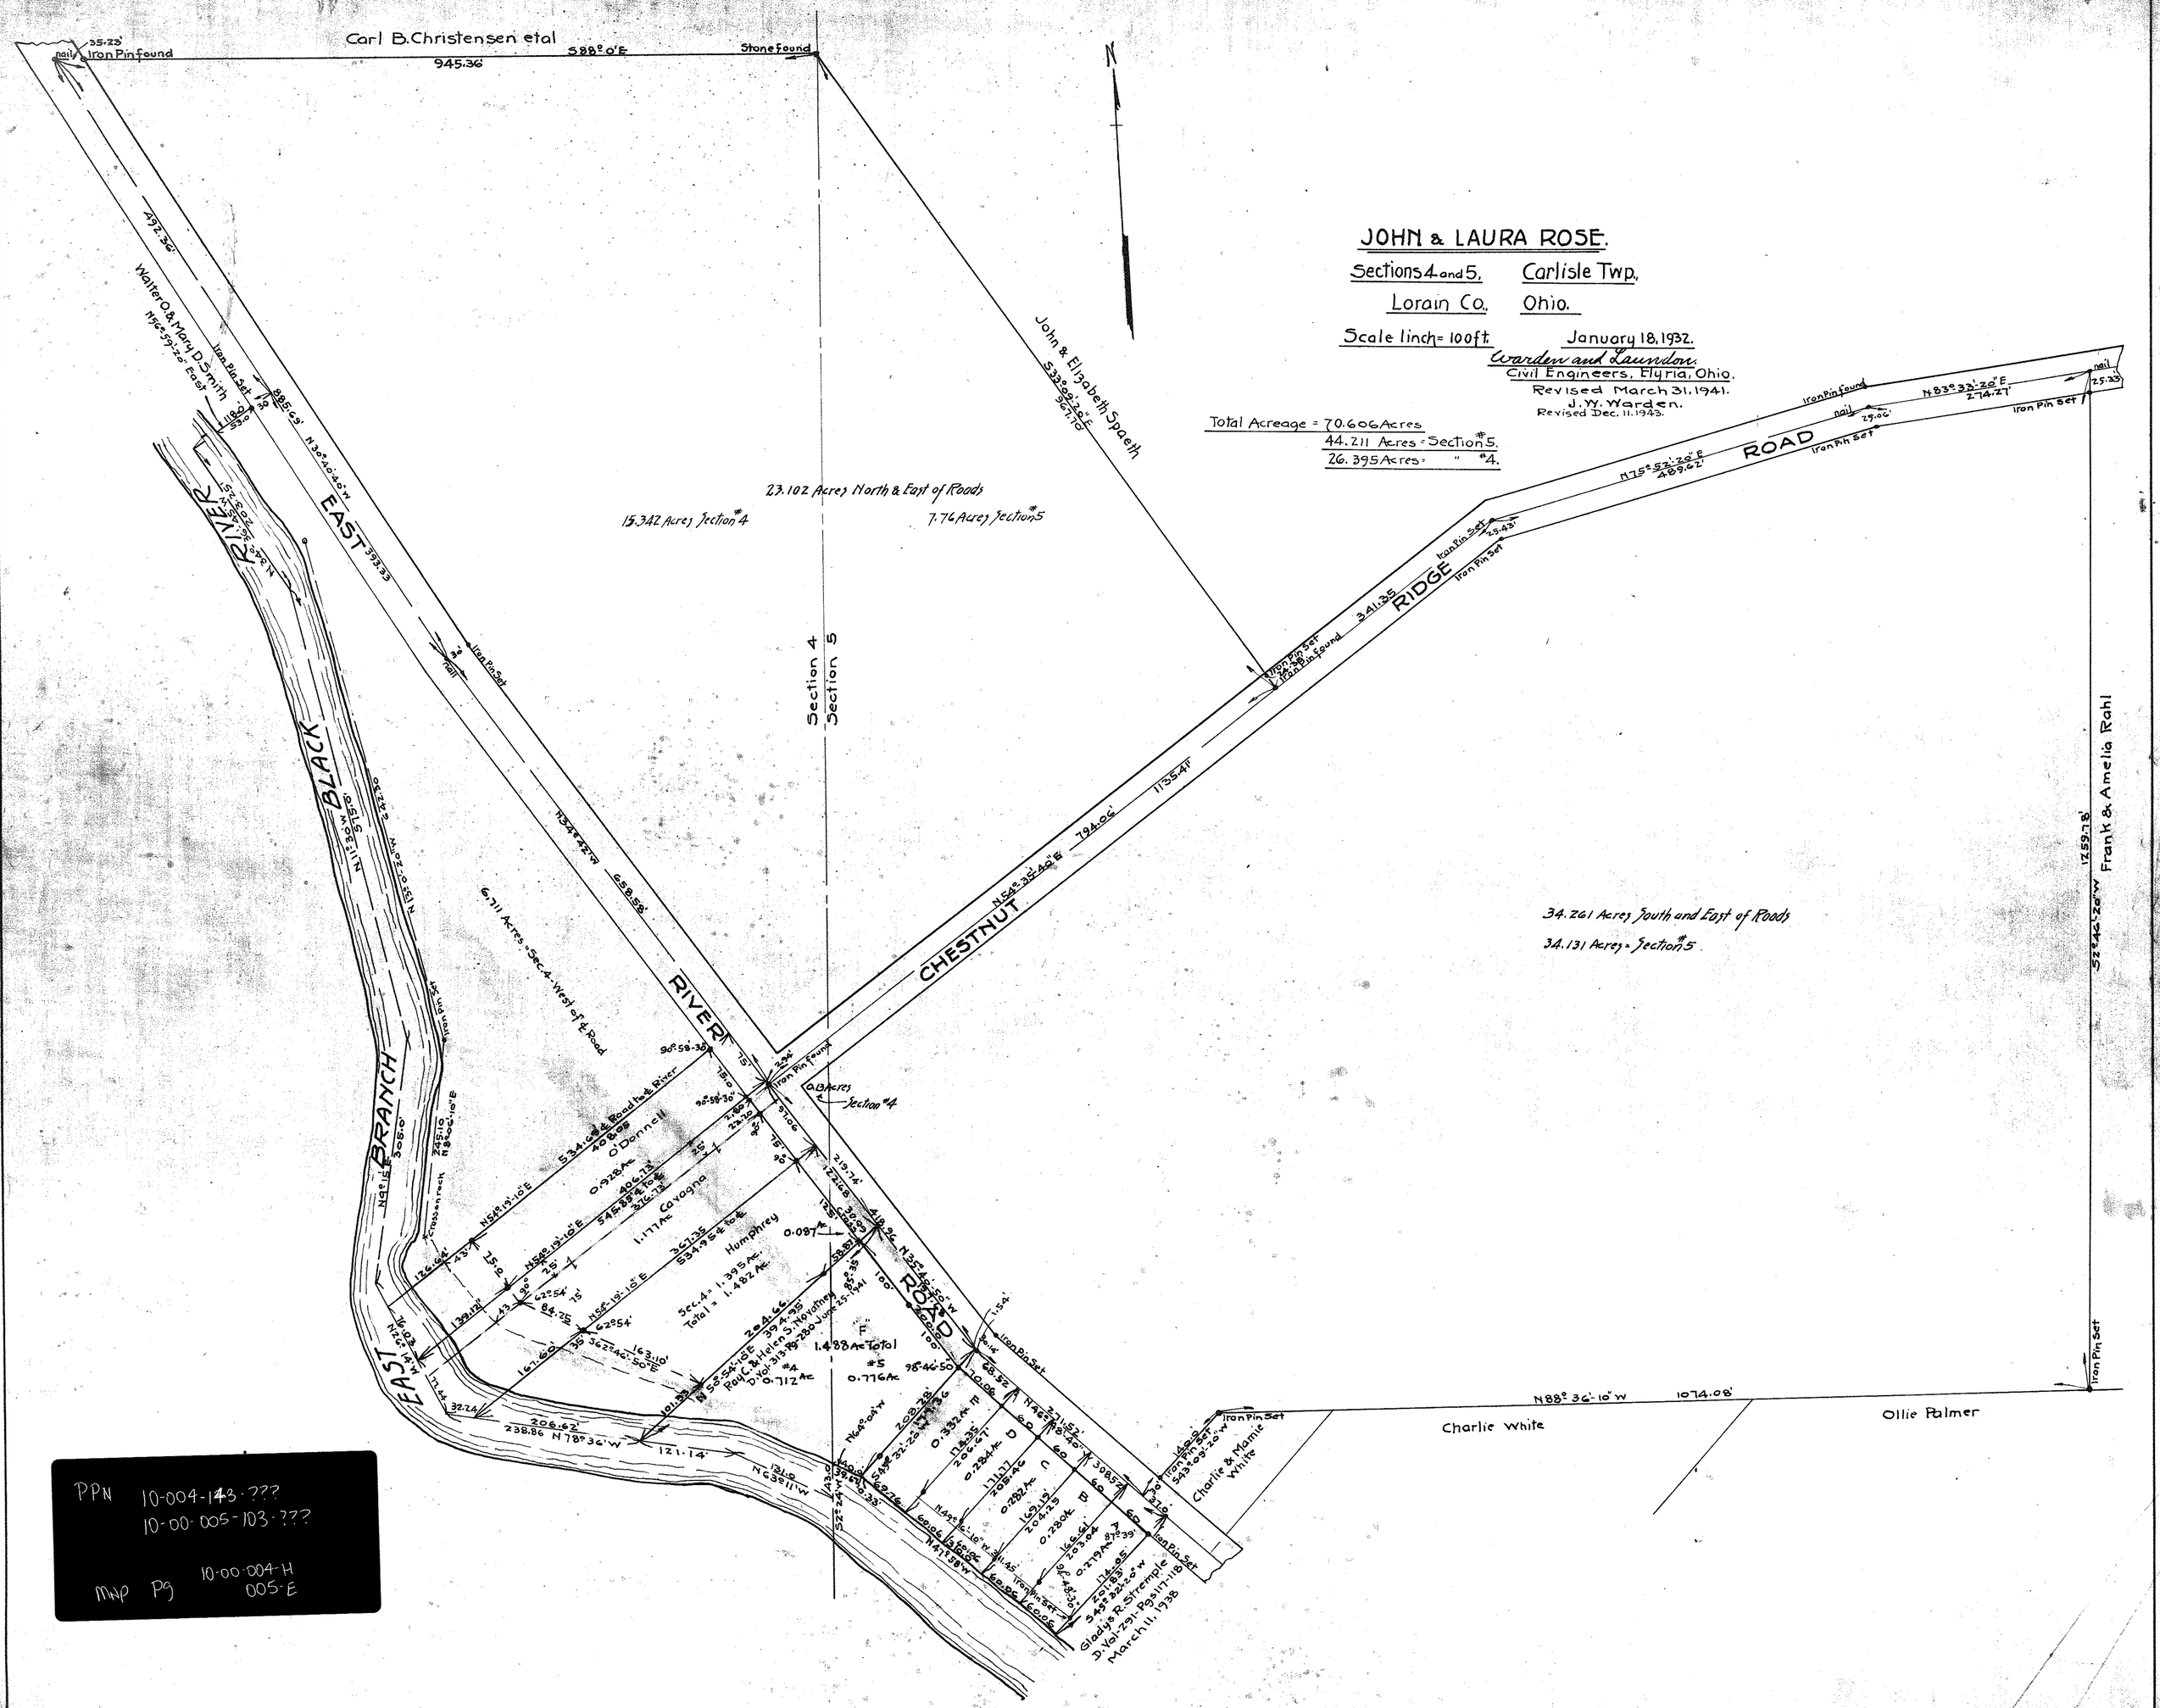

PPN 10-004-143.???
10-00-005-103.???

MAP Pg 10-00-004-H
005-E