


North Line Section 25

SURVEY FOR
ARNOLD FRASCA
 PREMISES OF PATSICK AND LANIE V. COUNIHAN
 D-VOL. 415 PG. 462
 SEC. 25 AVON VILLAGE, LORAIN COUNTY, OHIO
 SCALE 1"=200' OCT. 20, 1955
 J. W. WARDEN & ASSOCIATES REG. SURVEYORS

PPN
 04-00-025000-???

04-00-025-A.

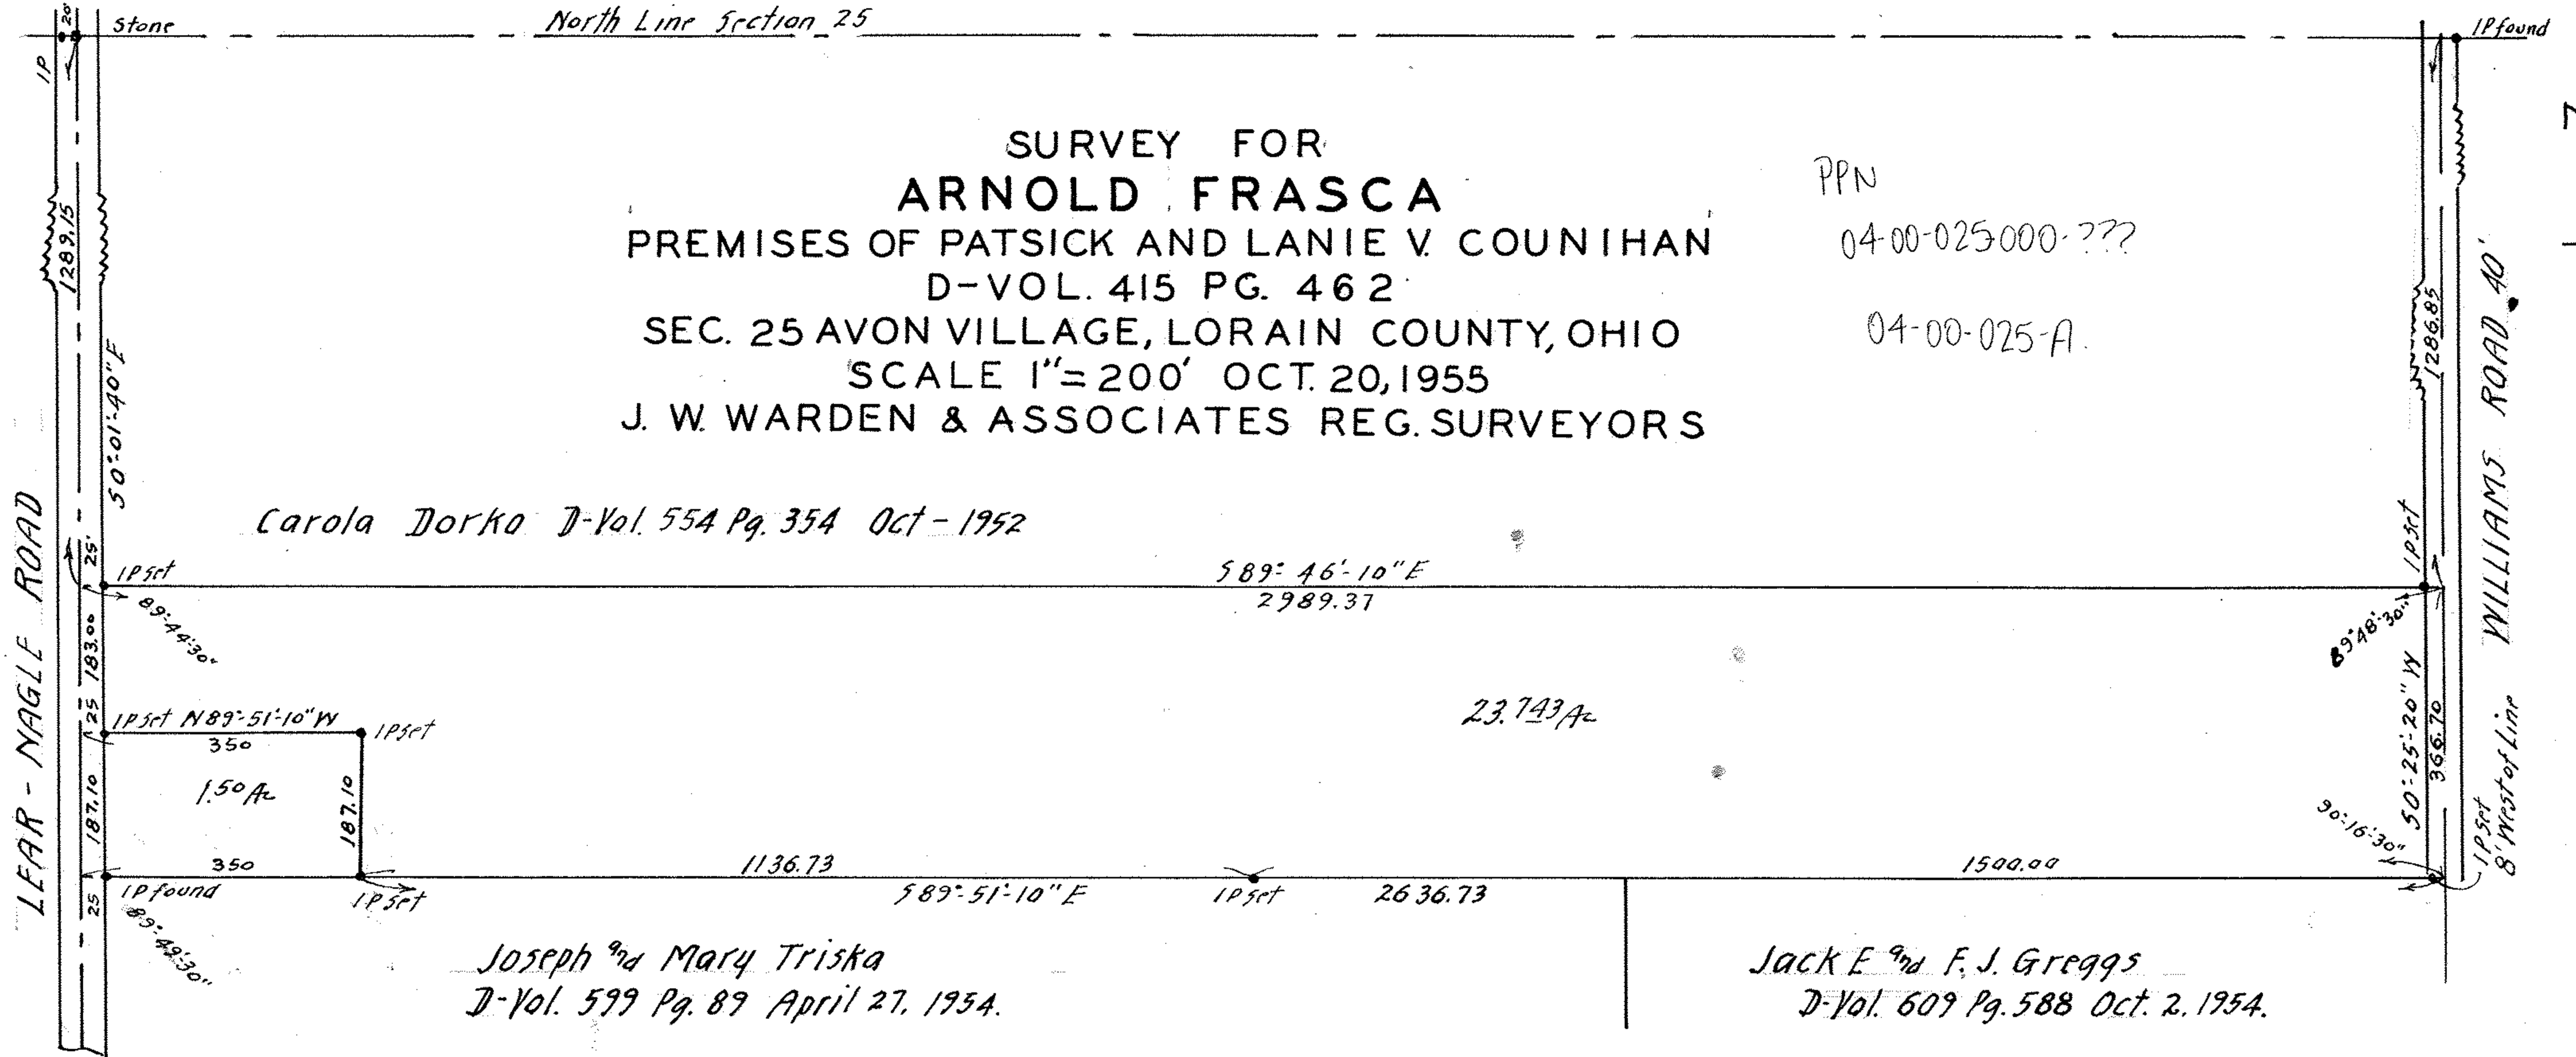

Carola Dorko D-Vol. 554 Pg. 354 Oct-1952

589° 46' 10" E
 2989.37

23.743 Ac

1136.73

589° 51' 10" E

IP set

2636.73

1500.00

Joseph & Mary Triska
 D-Vol. 599 Pg. 89 April 27, 1954.

Jack E. & F. J. Greggs
 D-Vol. 609 Pg. 588 Oct. 2, 1954.

12-0457-G