PPN
02-02-003-102-016
MAP Pg 02-02-003

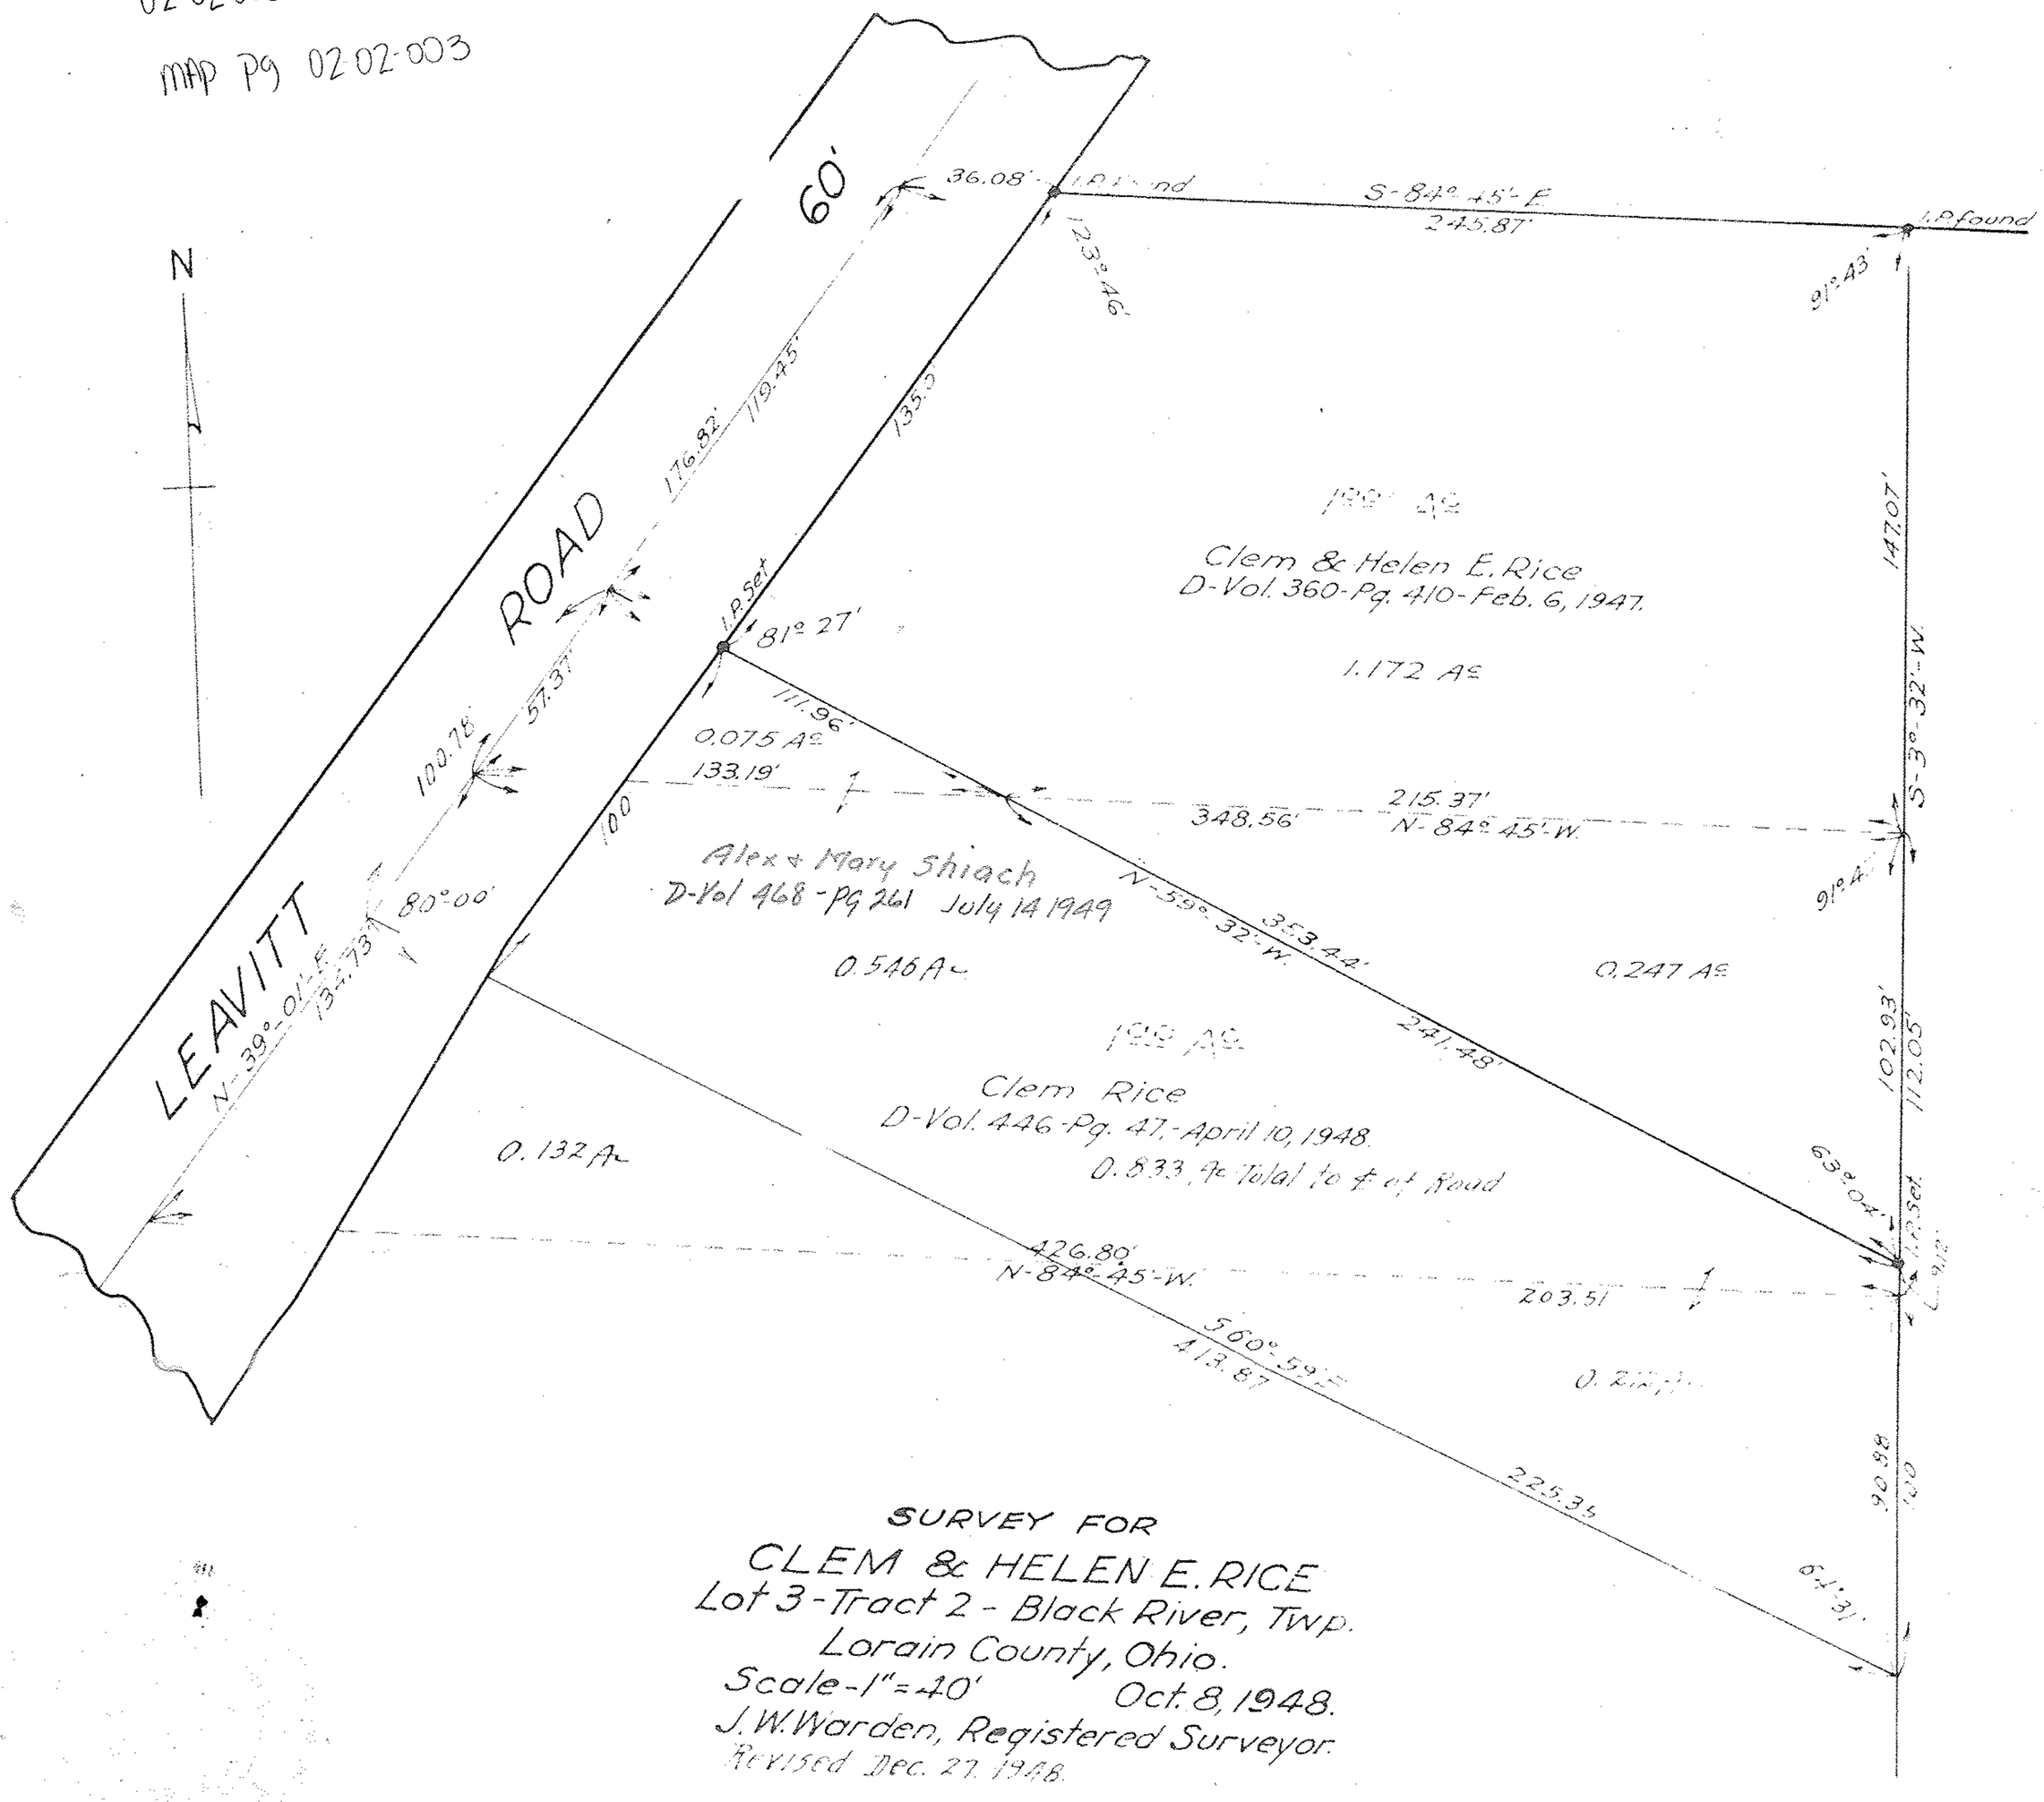

SURVEY FOR
CLEM & HELEN E. RICE
Lot 3-Tract 2 - Black River, Twp.
Lorain County, Ohio.
Scale-1"=40' Oct. 8, 1948.
J. W. Warden, Registered Surveyor.
Revised Dec. 27, 1948.