SURVEY FOR

A.J. NAGEL - ESTATE

D-VOL. 309 PG. 109 AUG. 24, 1940

SECTION 27 AVON VILLAGE

LORAIN COUNTY OHIO

SCALE 1"=100' JUNE 20, 1960

J.W. WARDEN AND ASSOCIATES REG. SURVEYORS

12 - 0457-B
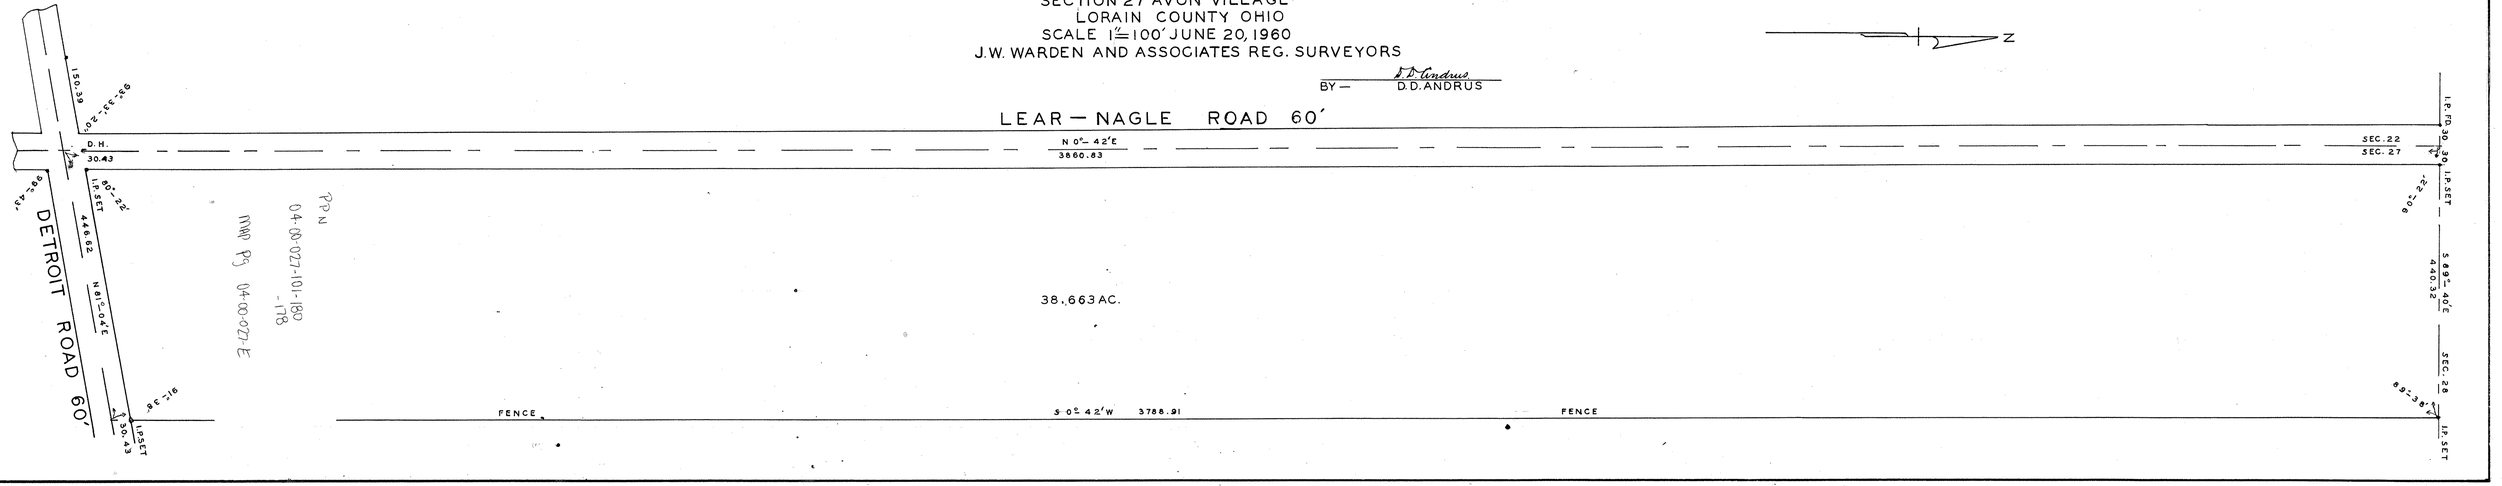
BY — D.D. Andrus
D.D. ANDRUS