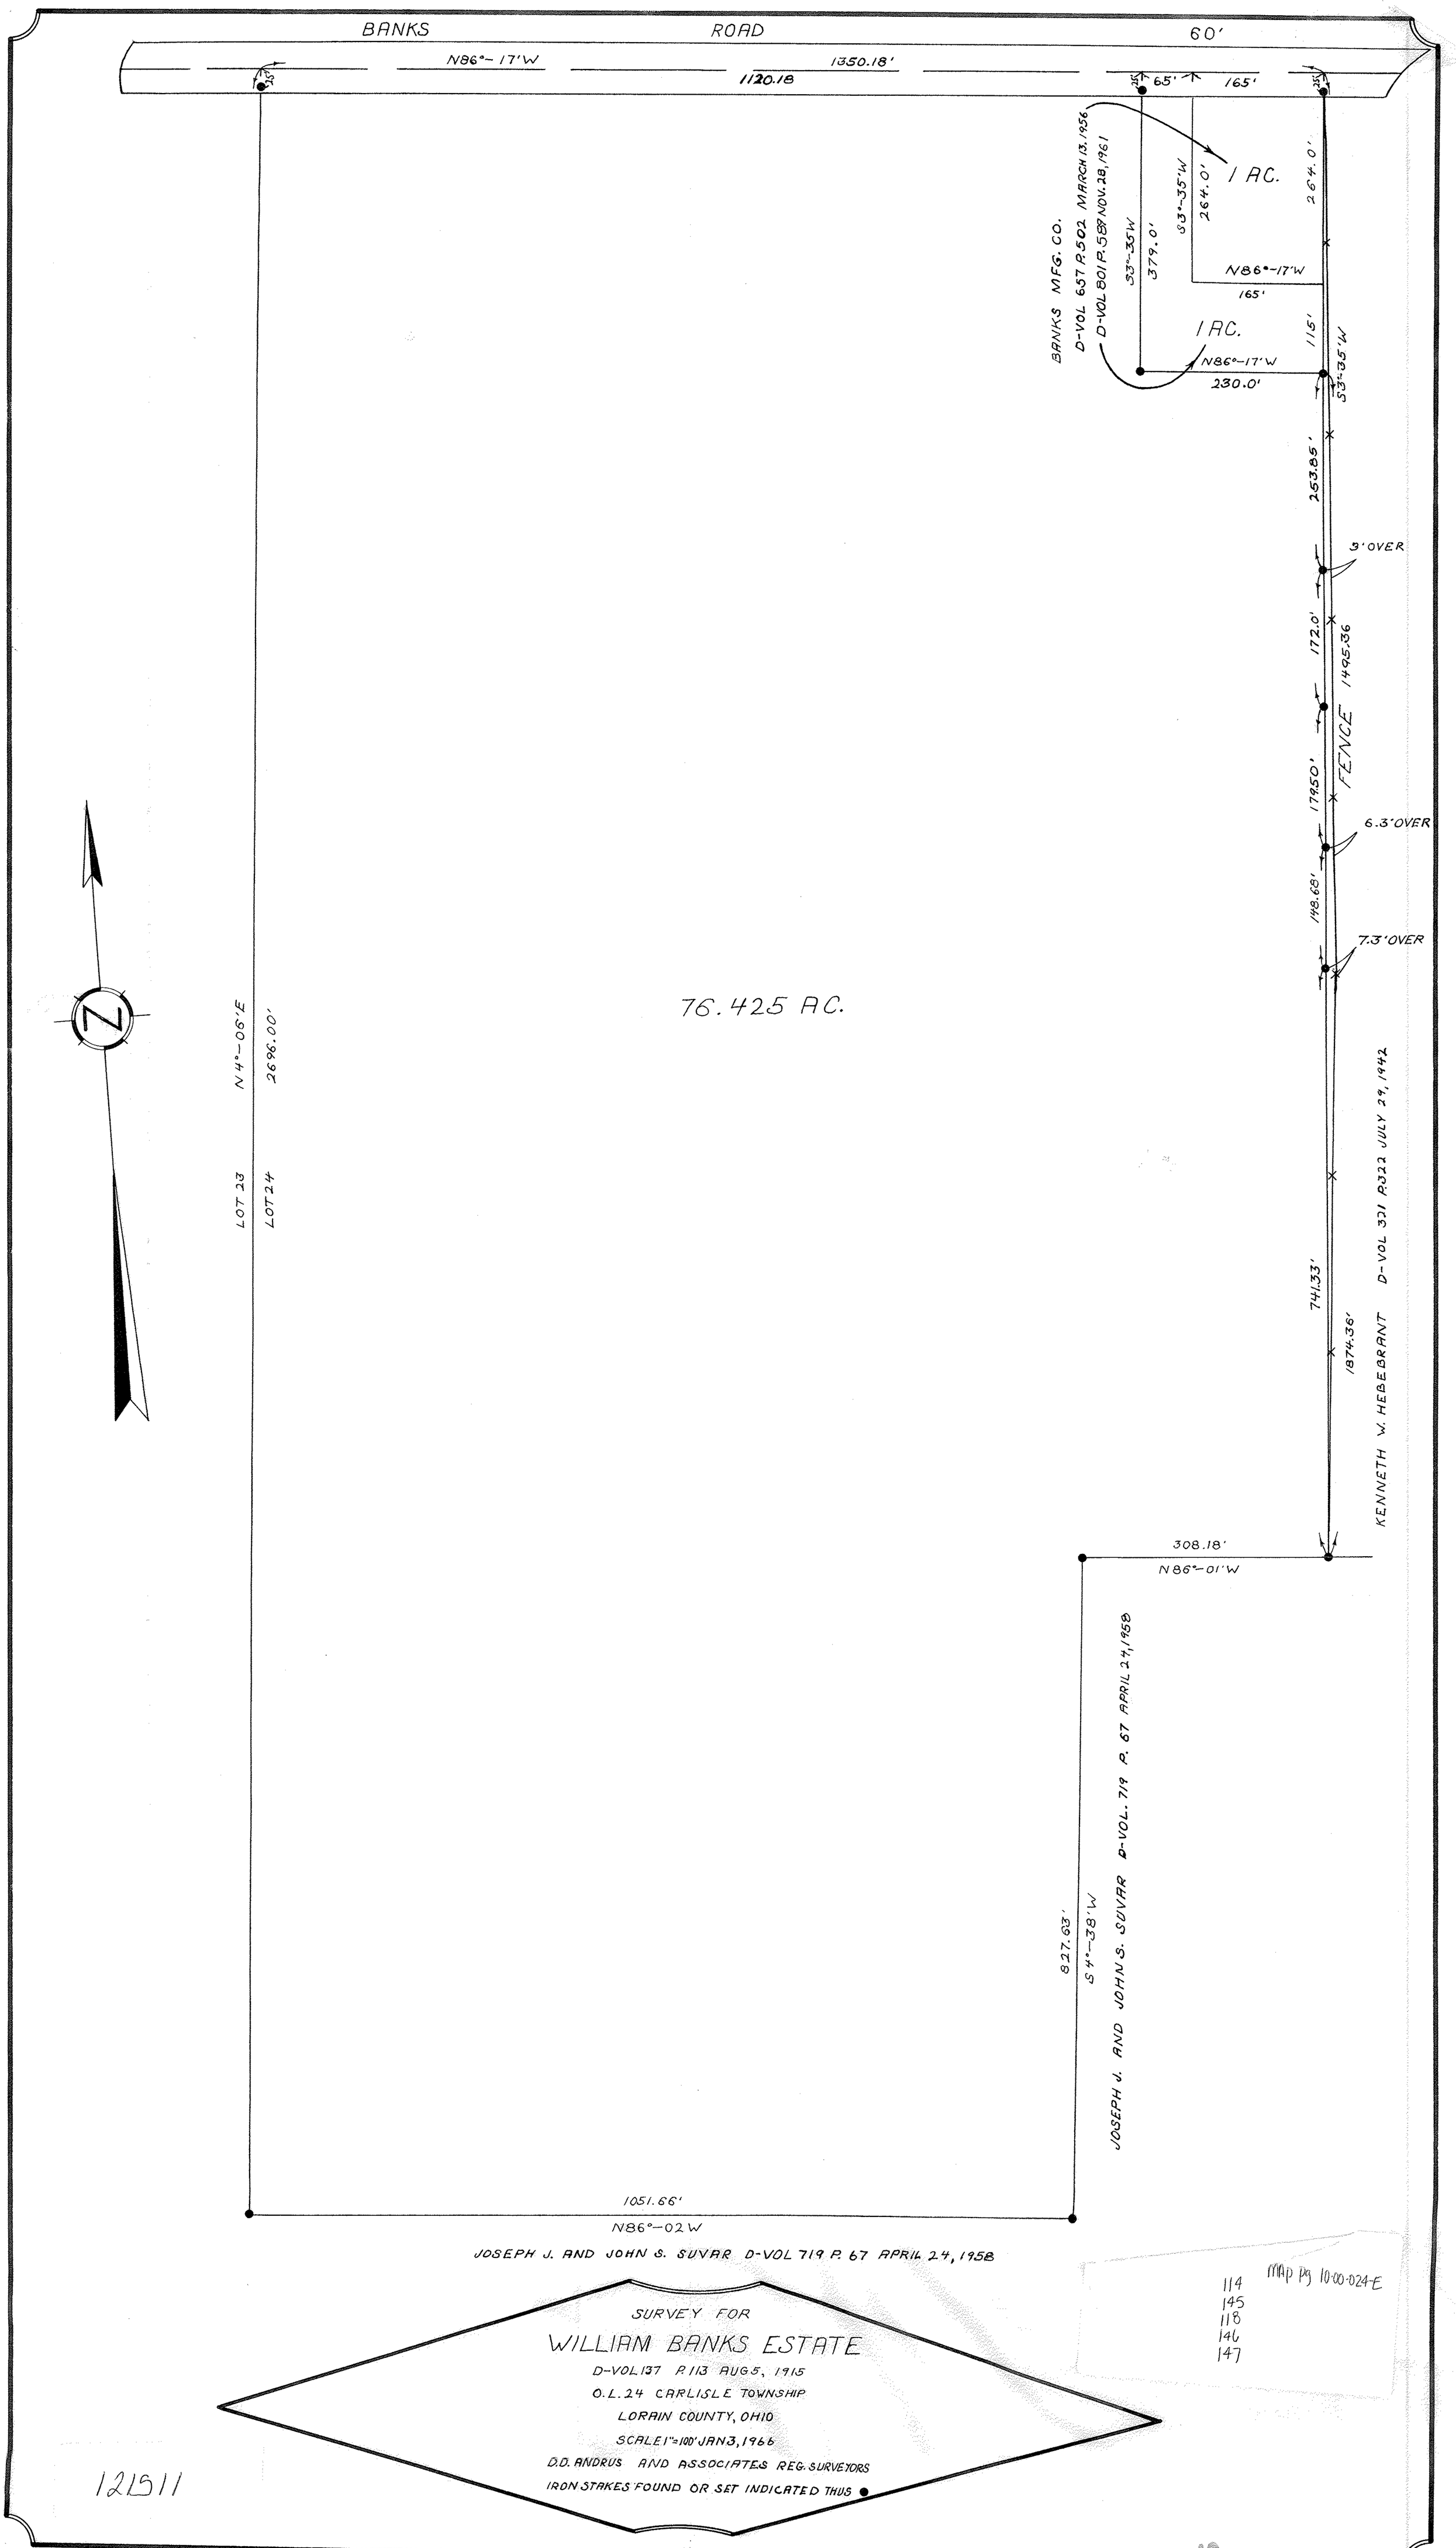
BANKS ROAD 60'
N86°-17'W 1350.18'
1120.18
65' 165'
BANKS MFG. CO.
D-VOL 657 P.502 MARCH 13, 1956
D-VOL 801 P.589 NOV. 28, 1961
S3°-35'W 379.0'
S3°-35'W 264.0'
264.0'
1 AC.
N86°-17'W
165'
1 AC.
N86°-17'W
230.0'
115'
S3°-35'W
253.85'
3' OVER
172.0'
1495.36
FENCE
174.50'
6.3' OVER
148.68'
7.3' OVER
741.33'
1874.36'
KENNETH W. HEBEBRANT D-VOL 321 P.322 JULY 29, 1942
76.425 AC.
N4°-06'E 2696.00'
LOT 23
LOT 24
308.18'
N86°-01'W
827.63'
S4°-38'W
JOSEPH J. AND JOHN S. SUVAR D-VOL. 719 P. 67 APRIL 24, 1958
1051.66'
N86°-02W
JOSEPH J. AND JOHN S. SUVAR D-VOL 719 P. 67 APRIL 24, 1958
SURVEY FOR
WILLIAM BANKS ESTATE
D-VOL 137 P.113 AUG 5, 1915
O.L. 24 CARLISLE TOWNSHIP
LORAIN COUNTY, OHIO
SCALE 1"=100' JAN 3, 1966
D.D. ANDRUS AND ASSOCIATES REG. SURVEYORS
IRON STAKES FOUND OR SET INDICATED THUS ●
MAP Pg 10-00-024-E
114
145
118
146
147
121511
19-1211