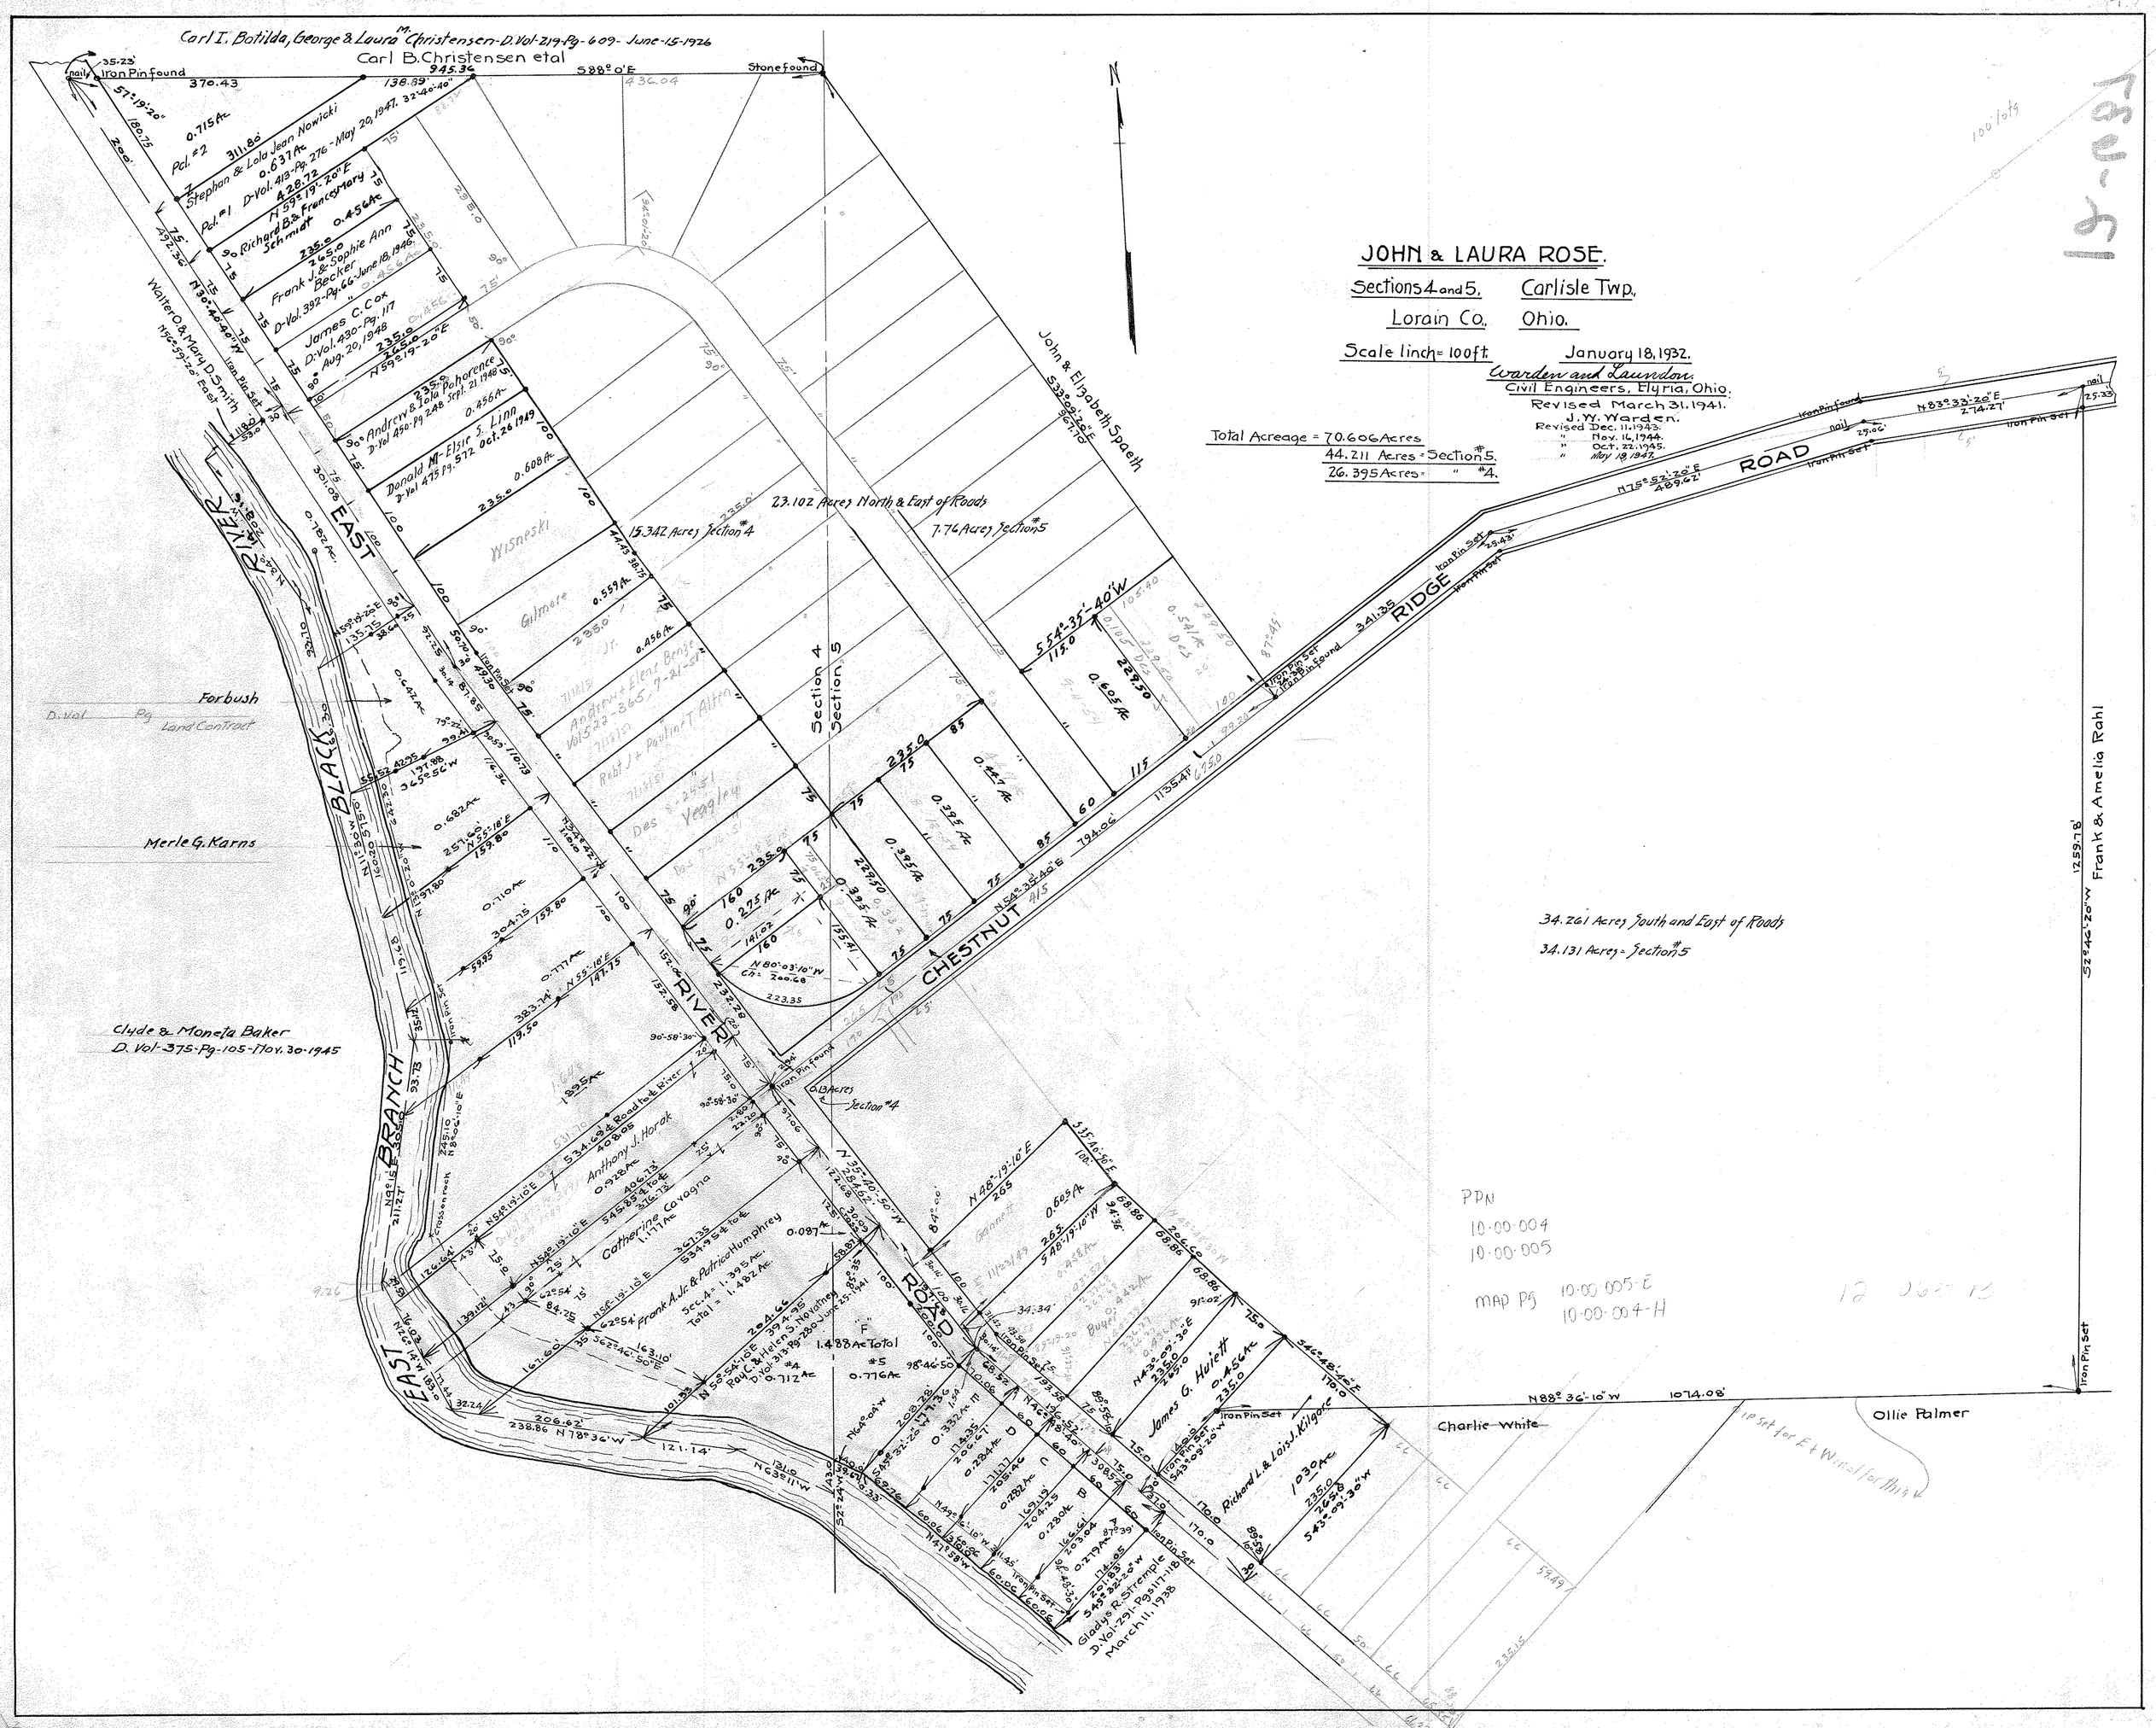
JOHN & LAURA ROSE.
Sections 4 and 5. Carlisle Twp.
Lorain Co. Ohio.
Scale 1 inch = 100 ft.
January 18, 1932.
Warden and Launder.
Civil Engineers, Elyria, Ohio.
Revised March 31, 1941.
J. W. Warden.
Revised Dec. 11, 1943.
" Nov. 16, 1944.
" Oct. 22, 1945.
" May 19, 1947.
Total Acreage = 70.606 Acres
44.211 Acres = Section #5.
26.395 Acres = " #4.
Carl I. Botilda, George & Laura Christensen - D. Vol-219-Pg-609 - June-15-1926
Carl B. Christensen etal
Stephan & Lola Jean Nowicki
D-Vol. 419-Pg. 276 - May 20, 1947.
Richard B. & Frances Mary Schmidt
Frank J. & Sophie Ann Becker
D-Vol. 392-Pg. 66 - June 18, 1946.
James C. Cox
D-Vol. 430-Pg. 117
Aug. 20, 1948
Andrew & Lola Pahorence
D-Vol 450-Pg 248 Sept. 21, 1948
Donald M. & Elsie S. Linn
D-Vol 475 Pg. 572 Oct. 26 1949
Walter O. & Mary D. Smith
Forbush
Land Contract
Merle G. Karns
Clyde & Moneta Baker
D. Vol-375-Pg-105-Nov. 30-1945
Andrew & Elena Benjo
Robt J. & Pauline T. Allen
Yeagley
Anthony J. Horak
Catherine Cavagna
Frank A. Jr. & Patricia Humphrey
Sec. 4 - 1.395 Ac.
Total = 1.482 Ac.
Paul C. & Helen S. Novotney
D. Vol. 313 Pg. 280 - June 25 - 1941
Gladys R. Stremple
D. Vol-251-Pg-117
March 11, 1938
John & Elizabeth Spaeth
Section 4
Section 5
23.102 Acres North & East of Roads
15.342 Acres Section #4
7.76 Acres Section #5
34.261 Acres South and East of Roads
34.131 Acres = Section #5
0.13 Acres Section #4
EAST RIVER ROAD
BLACK BRANCH
CHESTNUT RIDGE ROAD
EAST RIVER ROAD
Frank & Amelia Rahl
Charlie White
Ollie Palmer
James G. Hoiett
Richard L. & Lois J. Kilgore
PPN
10-00-004
10-00-005
MAP Pg 10-00-005-E
10-00-004-H