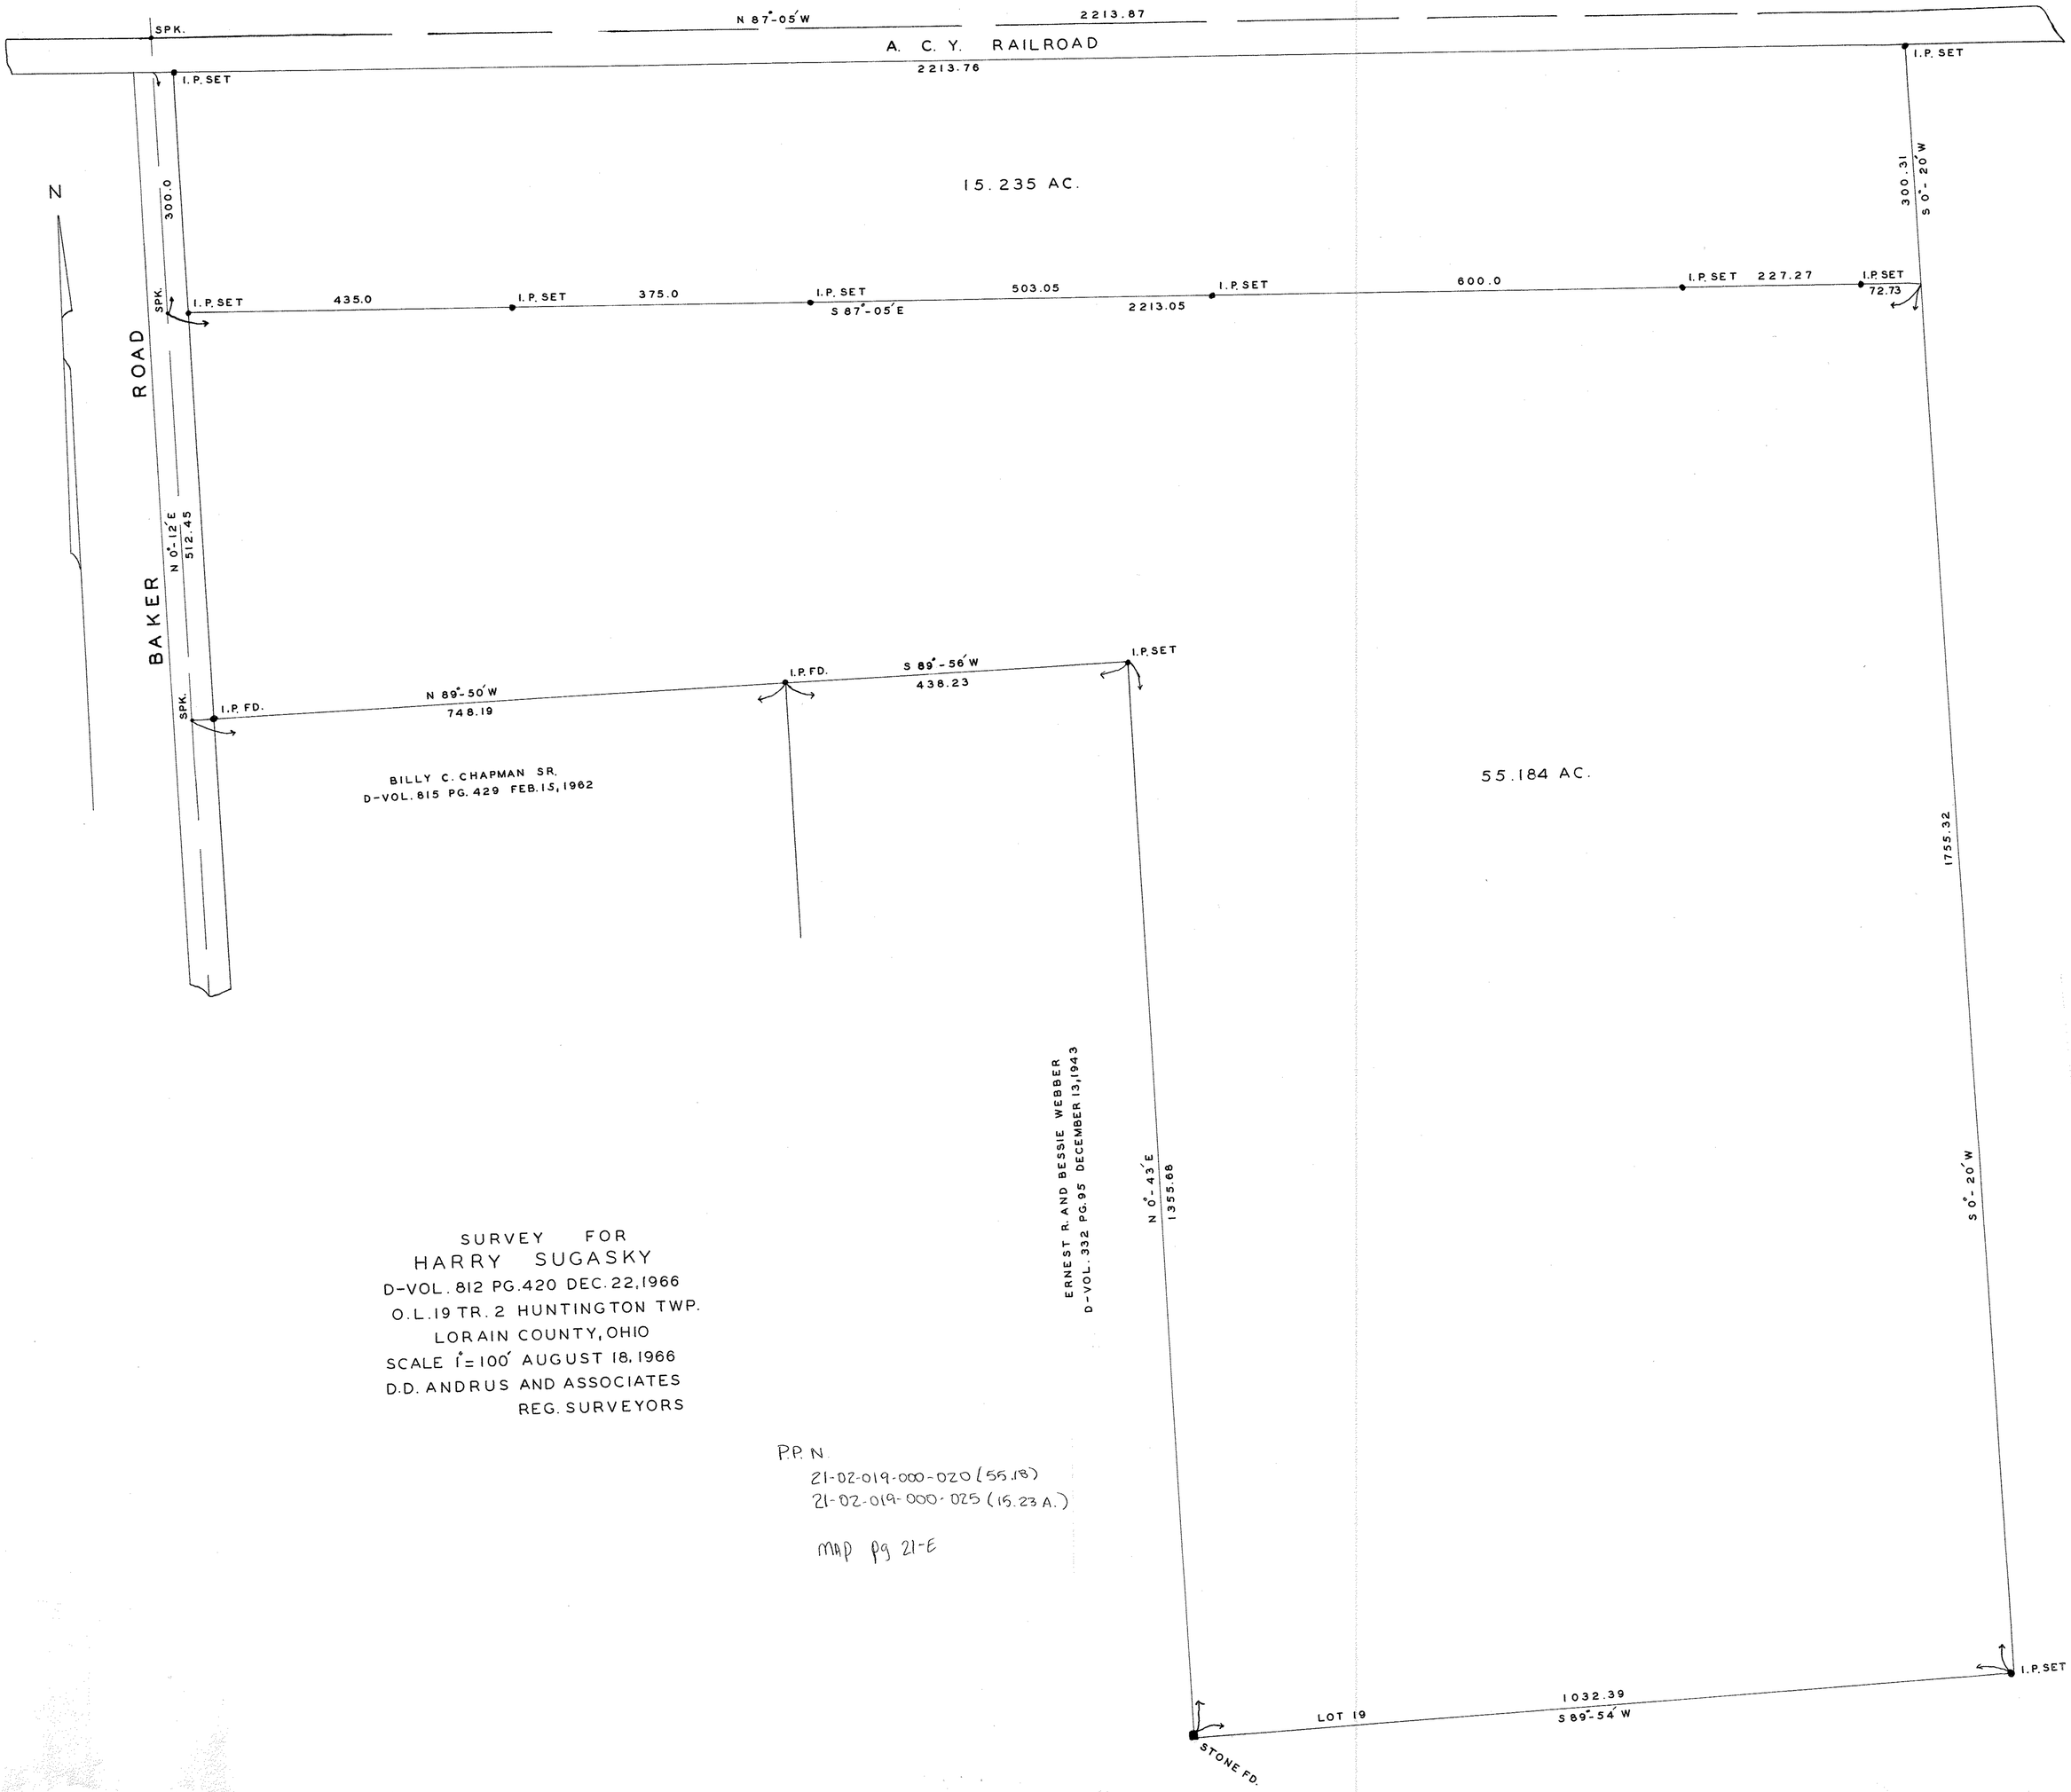

SURVEY FOR
HARRY SUGASKY
D-VOL. 812 PG. 420 DEC. 22, 1966
O.L. 19 TR. 2 HUNTINGTON TWP.
LORAIN COUNTY, OHIO
SCALE 1" = 100' AUGUST 18, 1966
D.D. ANDRUS AND ASSOCIATES
REG. SURVEYORS

P.P.N.
21-02-019-000-020 (55.18)
21-02-019-000-025 (15.23 A.)

MAP pg 21-E

12.1523 A

R-235