

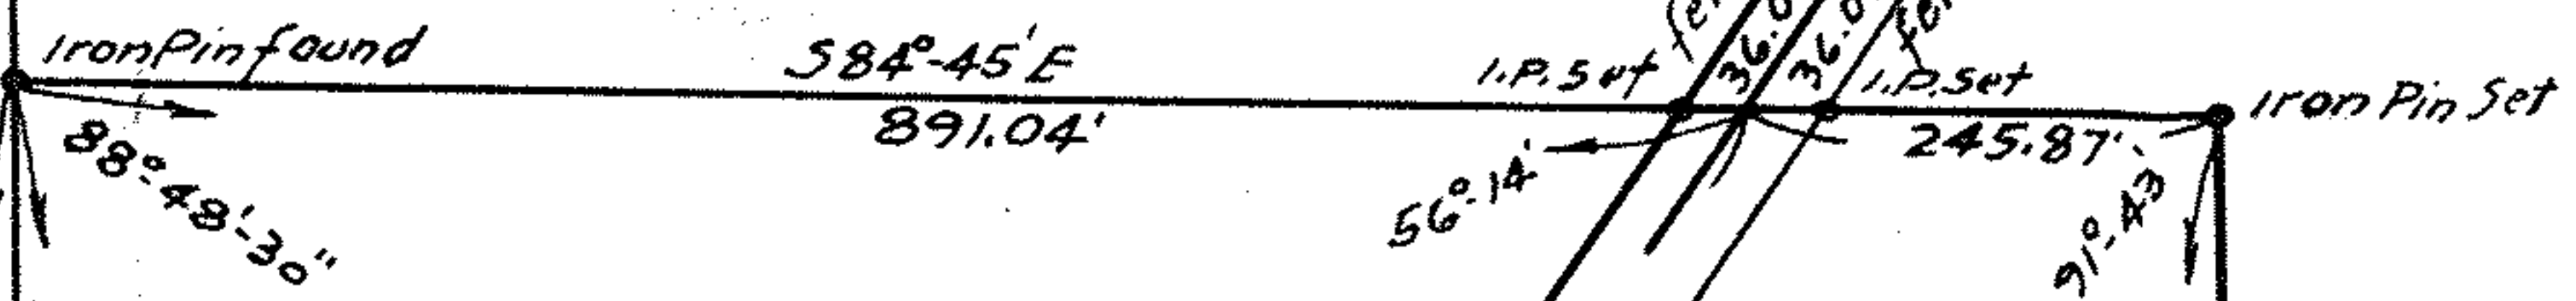


Benjamin Michael

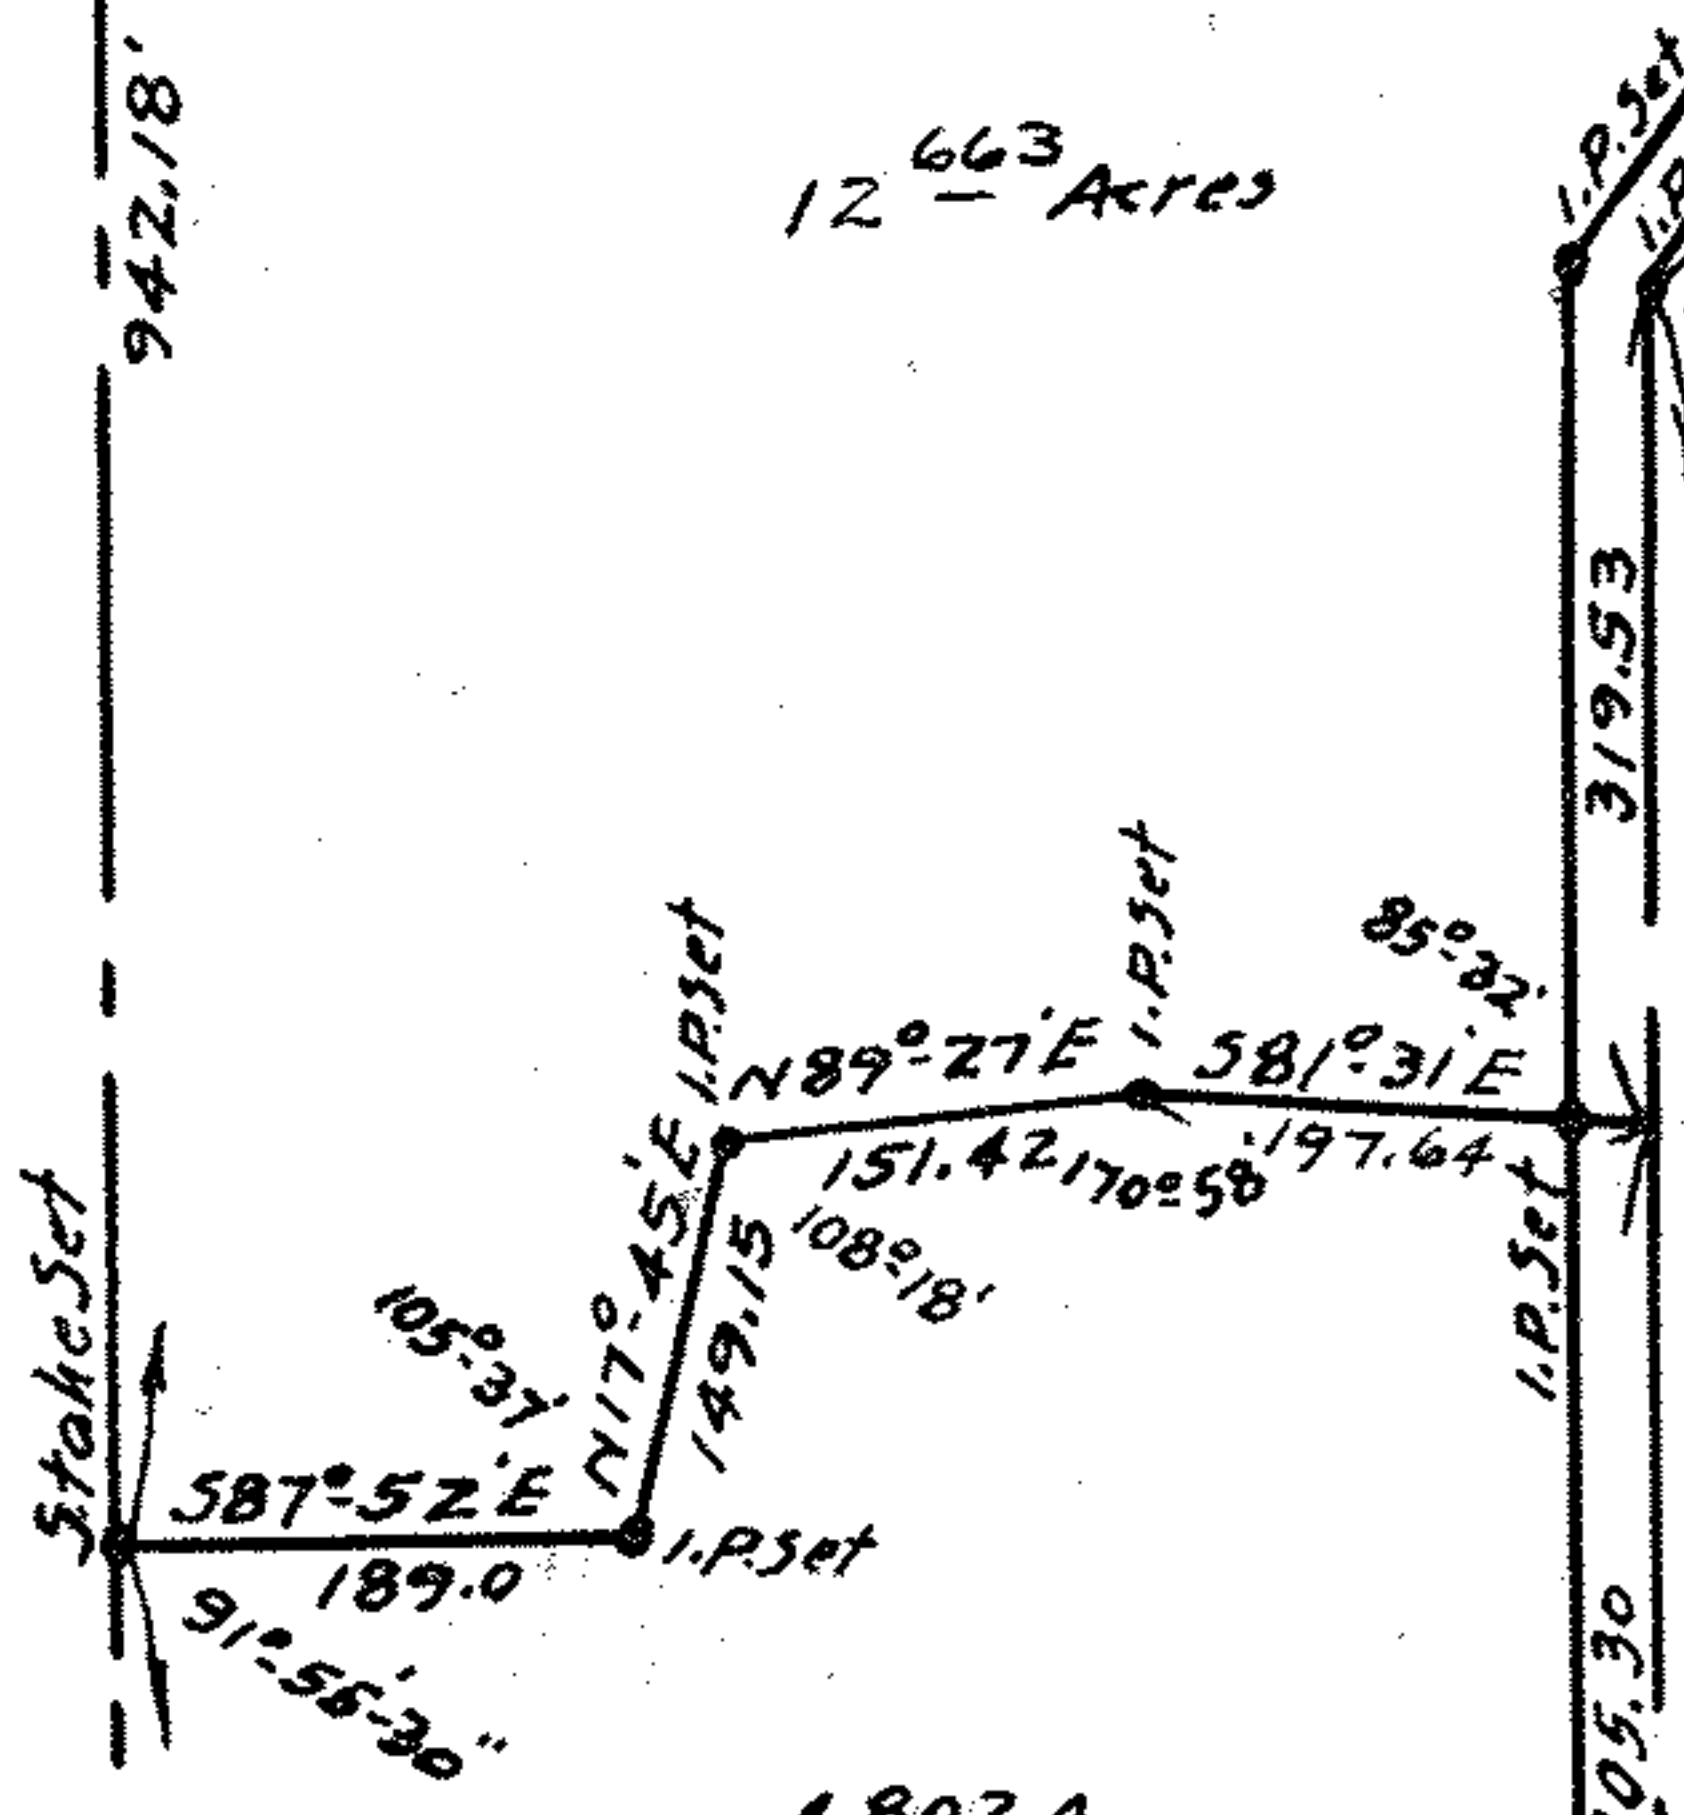


Wm. A⁹/₁₆ Matilda E. Bauer
D-Vol. 403-Pg 438 Oct. 17, 1946.

12⁶⁶³ Acres

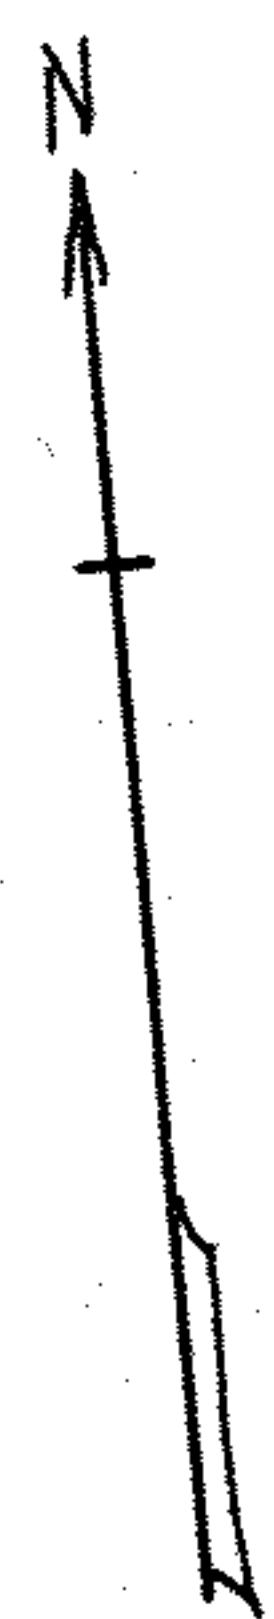


4.802 Ac

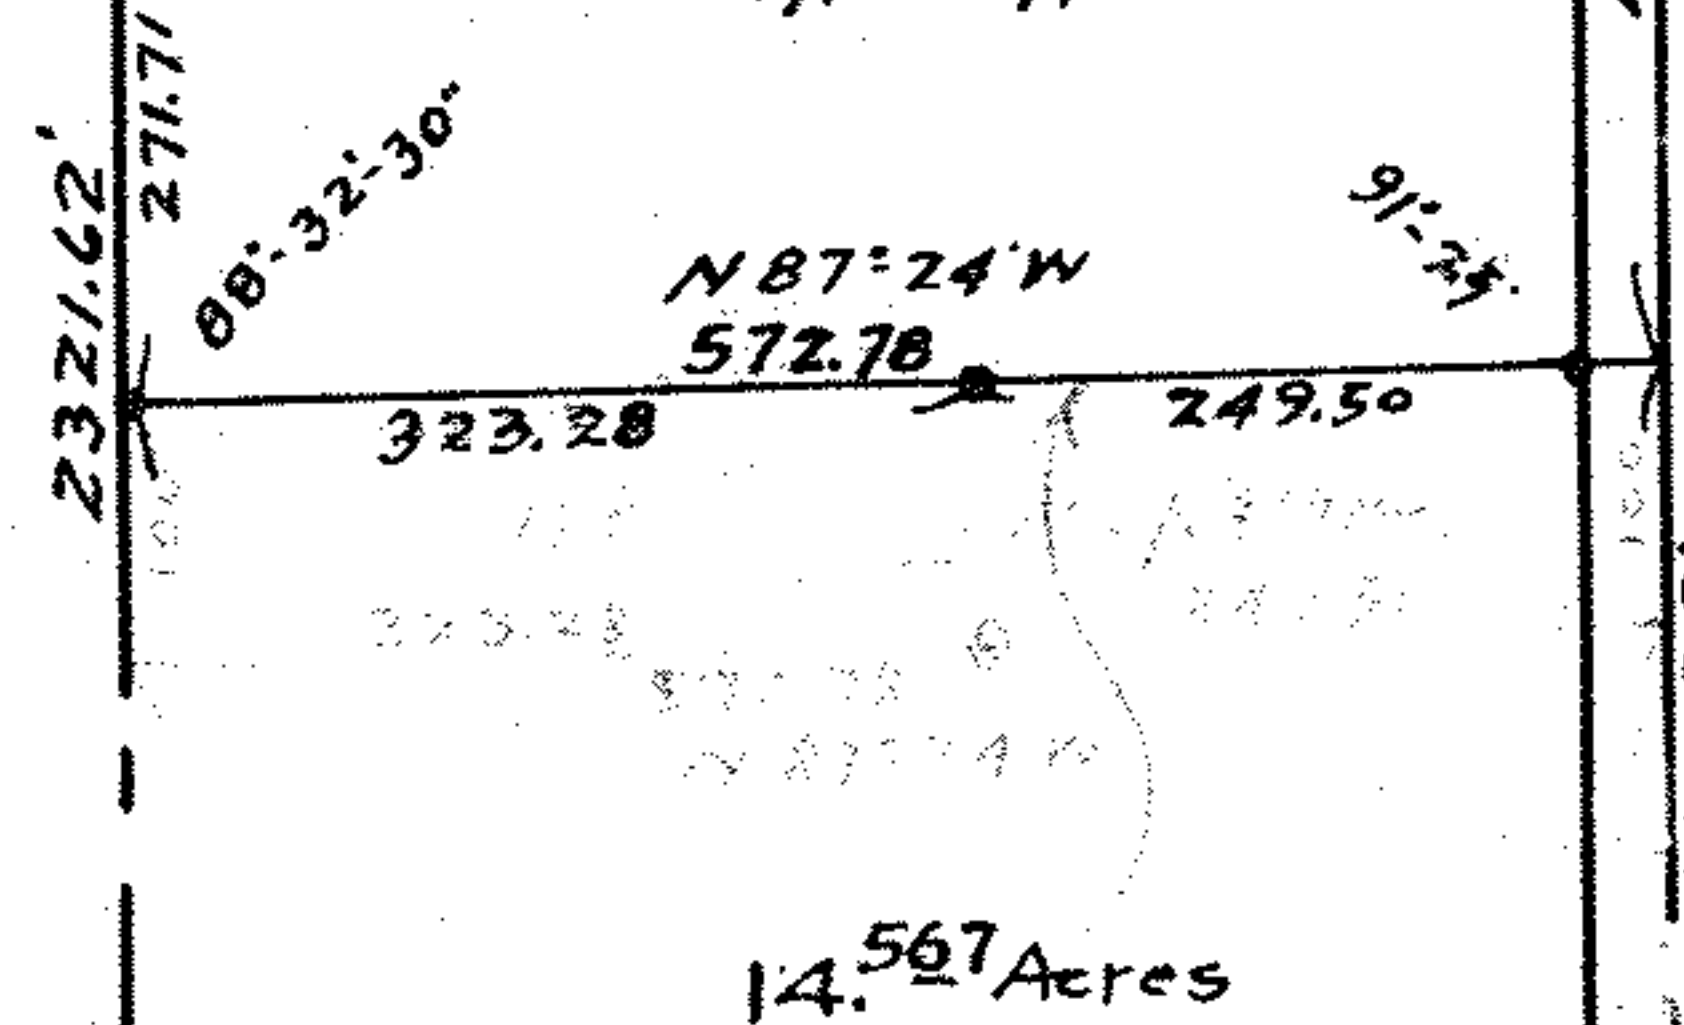

14.567 Acres

LEAVITT

28⁴¹³ Acres
East of $\frac{1}{2}$ Road

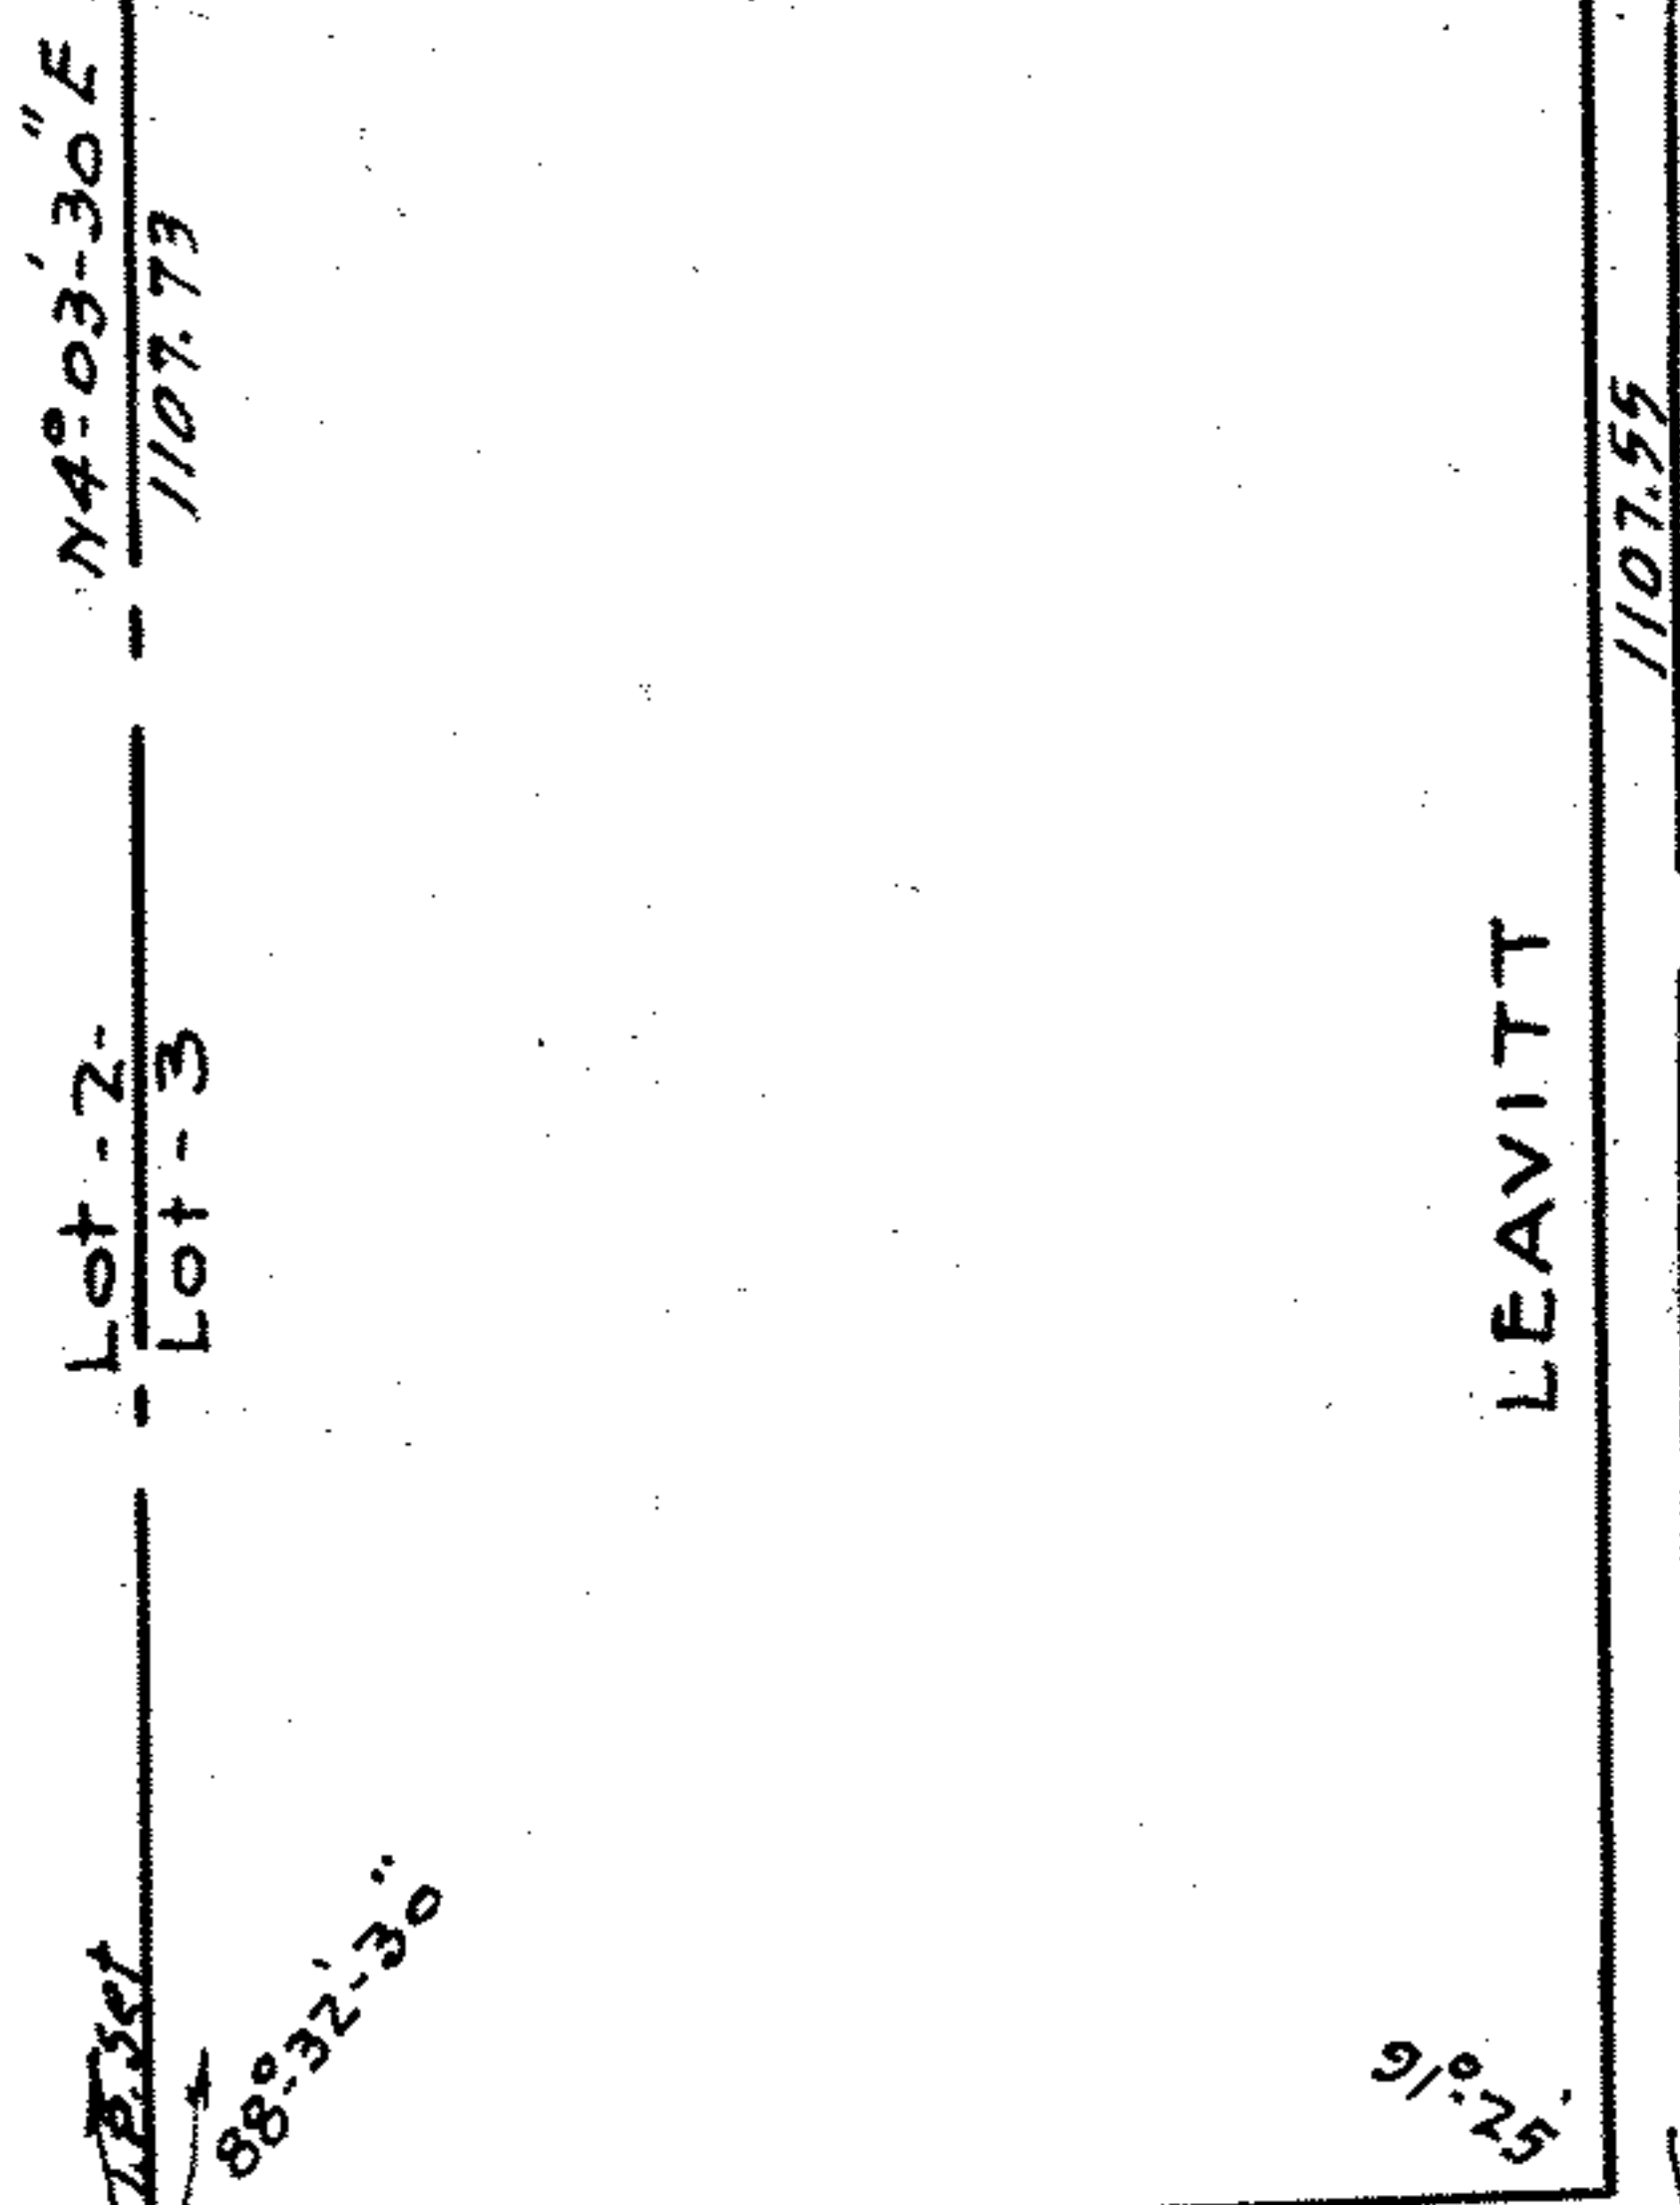

Black River Twp
Amherst R.R. Spike


COOPER-FOSTER PARK

Drill hole

ROAD

Chas. A. Hahn et al

Albert R. Lapp

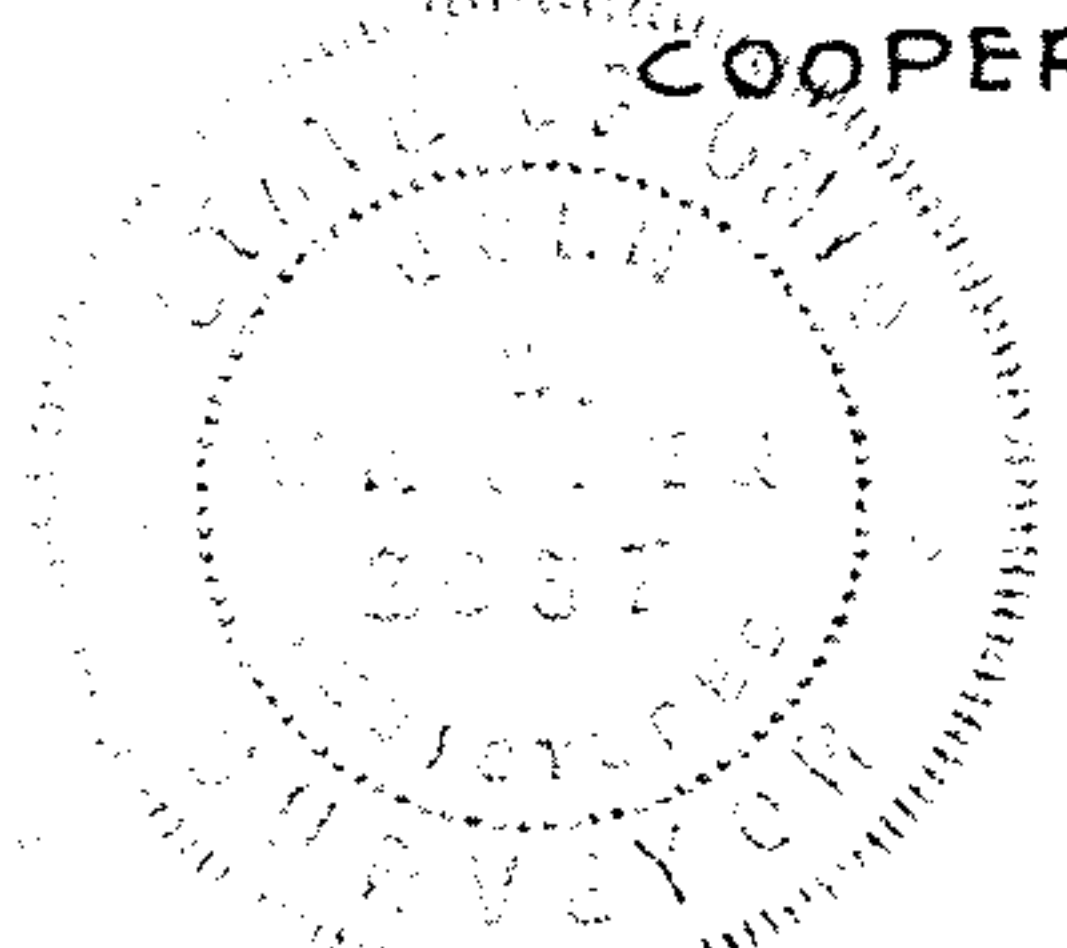

Survey for
Charles & Amelia Lapp.
Lot-3-Tract-2- Black River Twp.,
Lorain Co., Ohio.
Total Survey = 60.445 Acres.
Oct. 9-1942. Scale 1" = 200'.
J. W. Warden, Registered Surveyor.
Revised Dec. 2, 1947.