9 oo A
Oct. 31 1927
1277
13
Mrs S. Mitchell

PPN 04-00-019-102-???
MAP PG 04-00-019-C

MAP OF

SUNSET PARK

Section 19, Avon Lake Village,
Lorain County, Ohio.
Oct. 24, 1927. Scale 1 inch = 50 ft.
Warden and Laundon Civil Engineers.

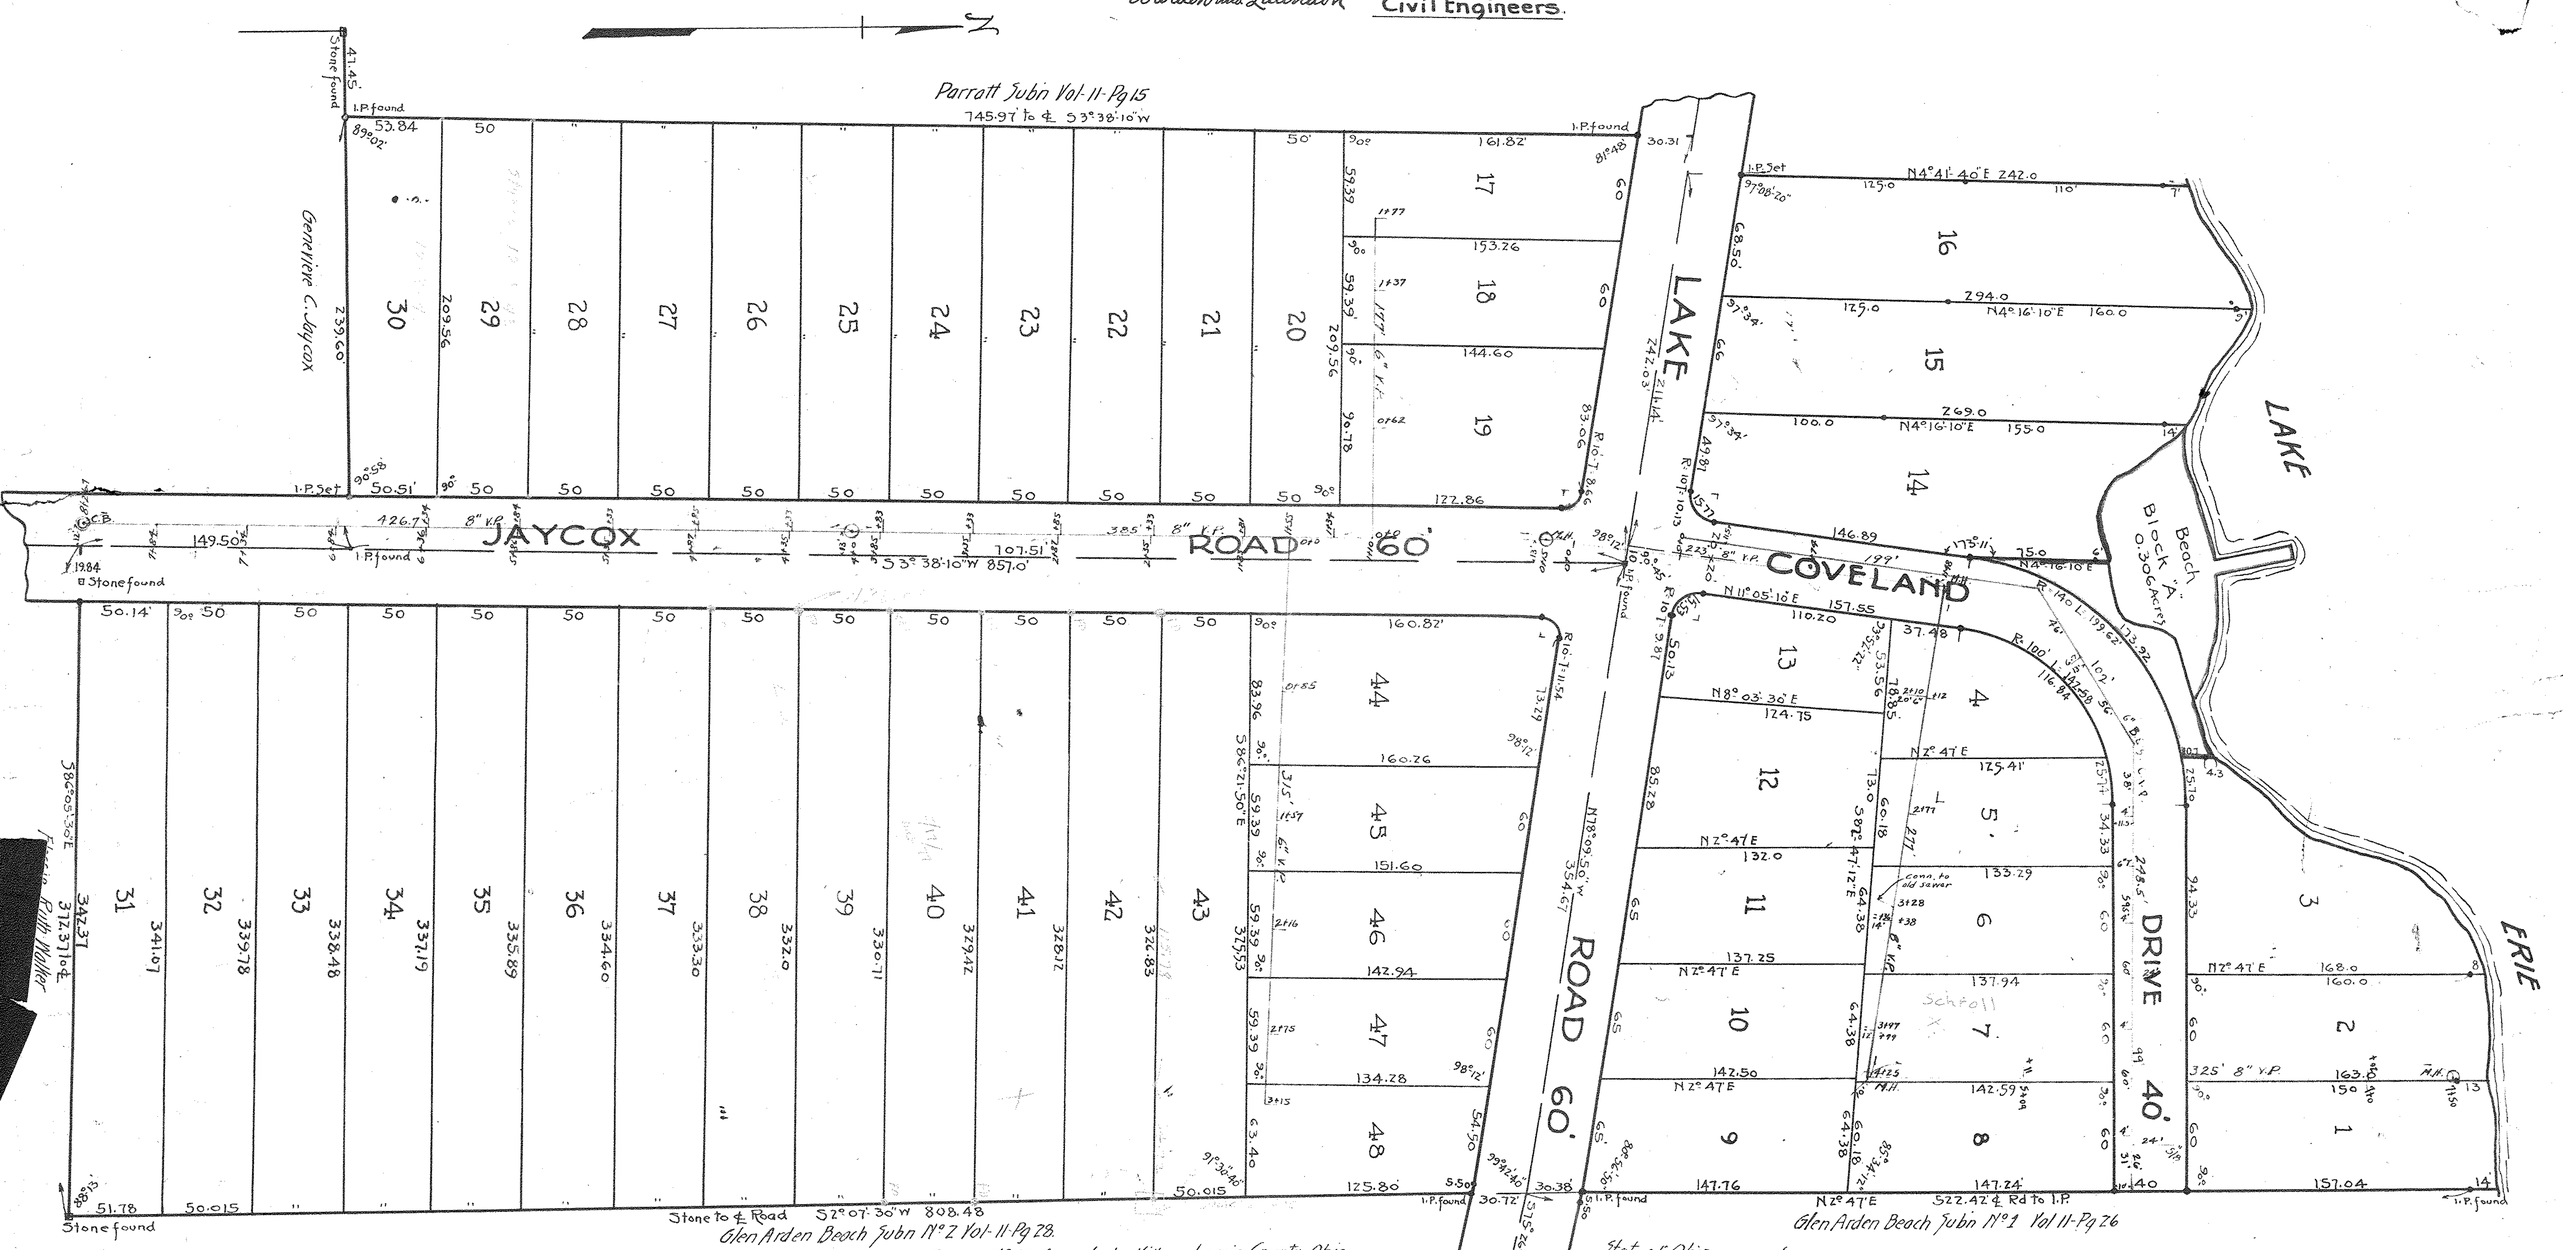

This is to certify that we have surveyed and platted the above subdivision of Sunset Park situated in Section No 19, Avon Lake Village, Lorain County, Ohio, containing 15.904 Acres of land, 11.018 Acres being south of Lake Road and 4.886 Acres north of Lake Road. Monuments were found or set at all points indicated on said map. Measurements shown are in feet and decimal parts thereof. Iron pins are set or found at all points marked thus •. All of which we certify to be correct.

Oct. 24. 1927.

Warden and Laundon. Civil Engineers.
by J. E. Warden

This is to certify that we the undersigned The Pearl Street Savings and Trust Company, Trustee and Mortgagee of the land embraced by the accompanying plat of Sunset Park hereby accept said plat to be correct and dedicate to public use for street purposes the streets shown upon said plat.
In Witness whereof we have set our hands and corporate seal at Cleveland, Ohio this 24th day of October 1927.

The Pearl Street Savings and Trust Company.
by- Ralph H. McQuat
Asst Trust Officer

Approved by The Planning Commission of Avon Lake Village, Lorain County, Ohio, Oct. 24, 1927.
The Avon Lake Planning Commission
by. _____ President.
_____ Secretary.

State of Ohio.
Cuyahoga County ss. { Before me a Notary Public in and for said County and State personally came The Pearl Street Savings and Trust Company, a corporation by its PRESIDENT - - - - - - and its ASST. TRUST OFFICER - - - who acknowledged the signing of the accompanying plat to be its and their free act and deed.
In Witness whereof I have hereunto set my hand and official seal at Cleveland, Ohio, this 24th day of October, 1927.

_____
Notary Public.

This is to certify that the accompanying plat of Sunset Park was approved and the streets shown thereon were accepted as village streets by the Council of The Village of Avon Lake, by Ordinance No 141 duly passed for that purpose on Oct. 24, 1927.

Avon Lake Village
Attest _____ Clerk.
by _____ Mayor