


No 02416

Daniel J. Farley # 2002 083 635 90

APPROVED LORAIN CO. MAP DEPT	
DATE	7-31-08
PAGE	05-00-052-000-038,051 05-00-052-0
BY	J. H. FIELD
#	08 02416

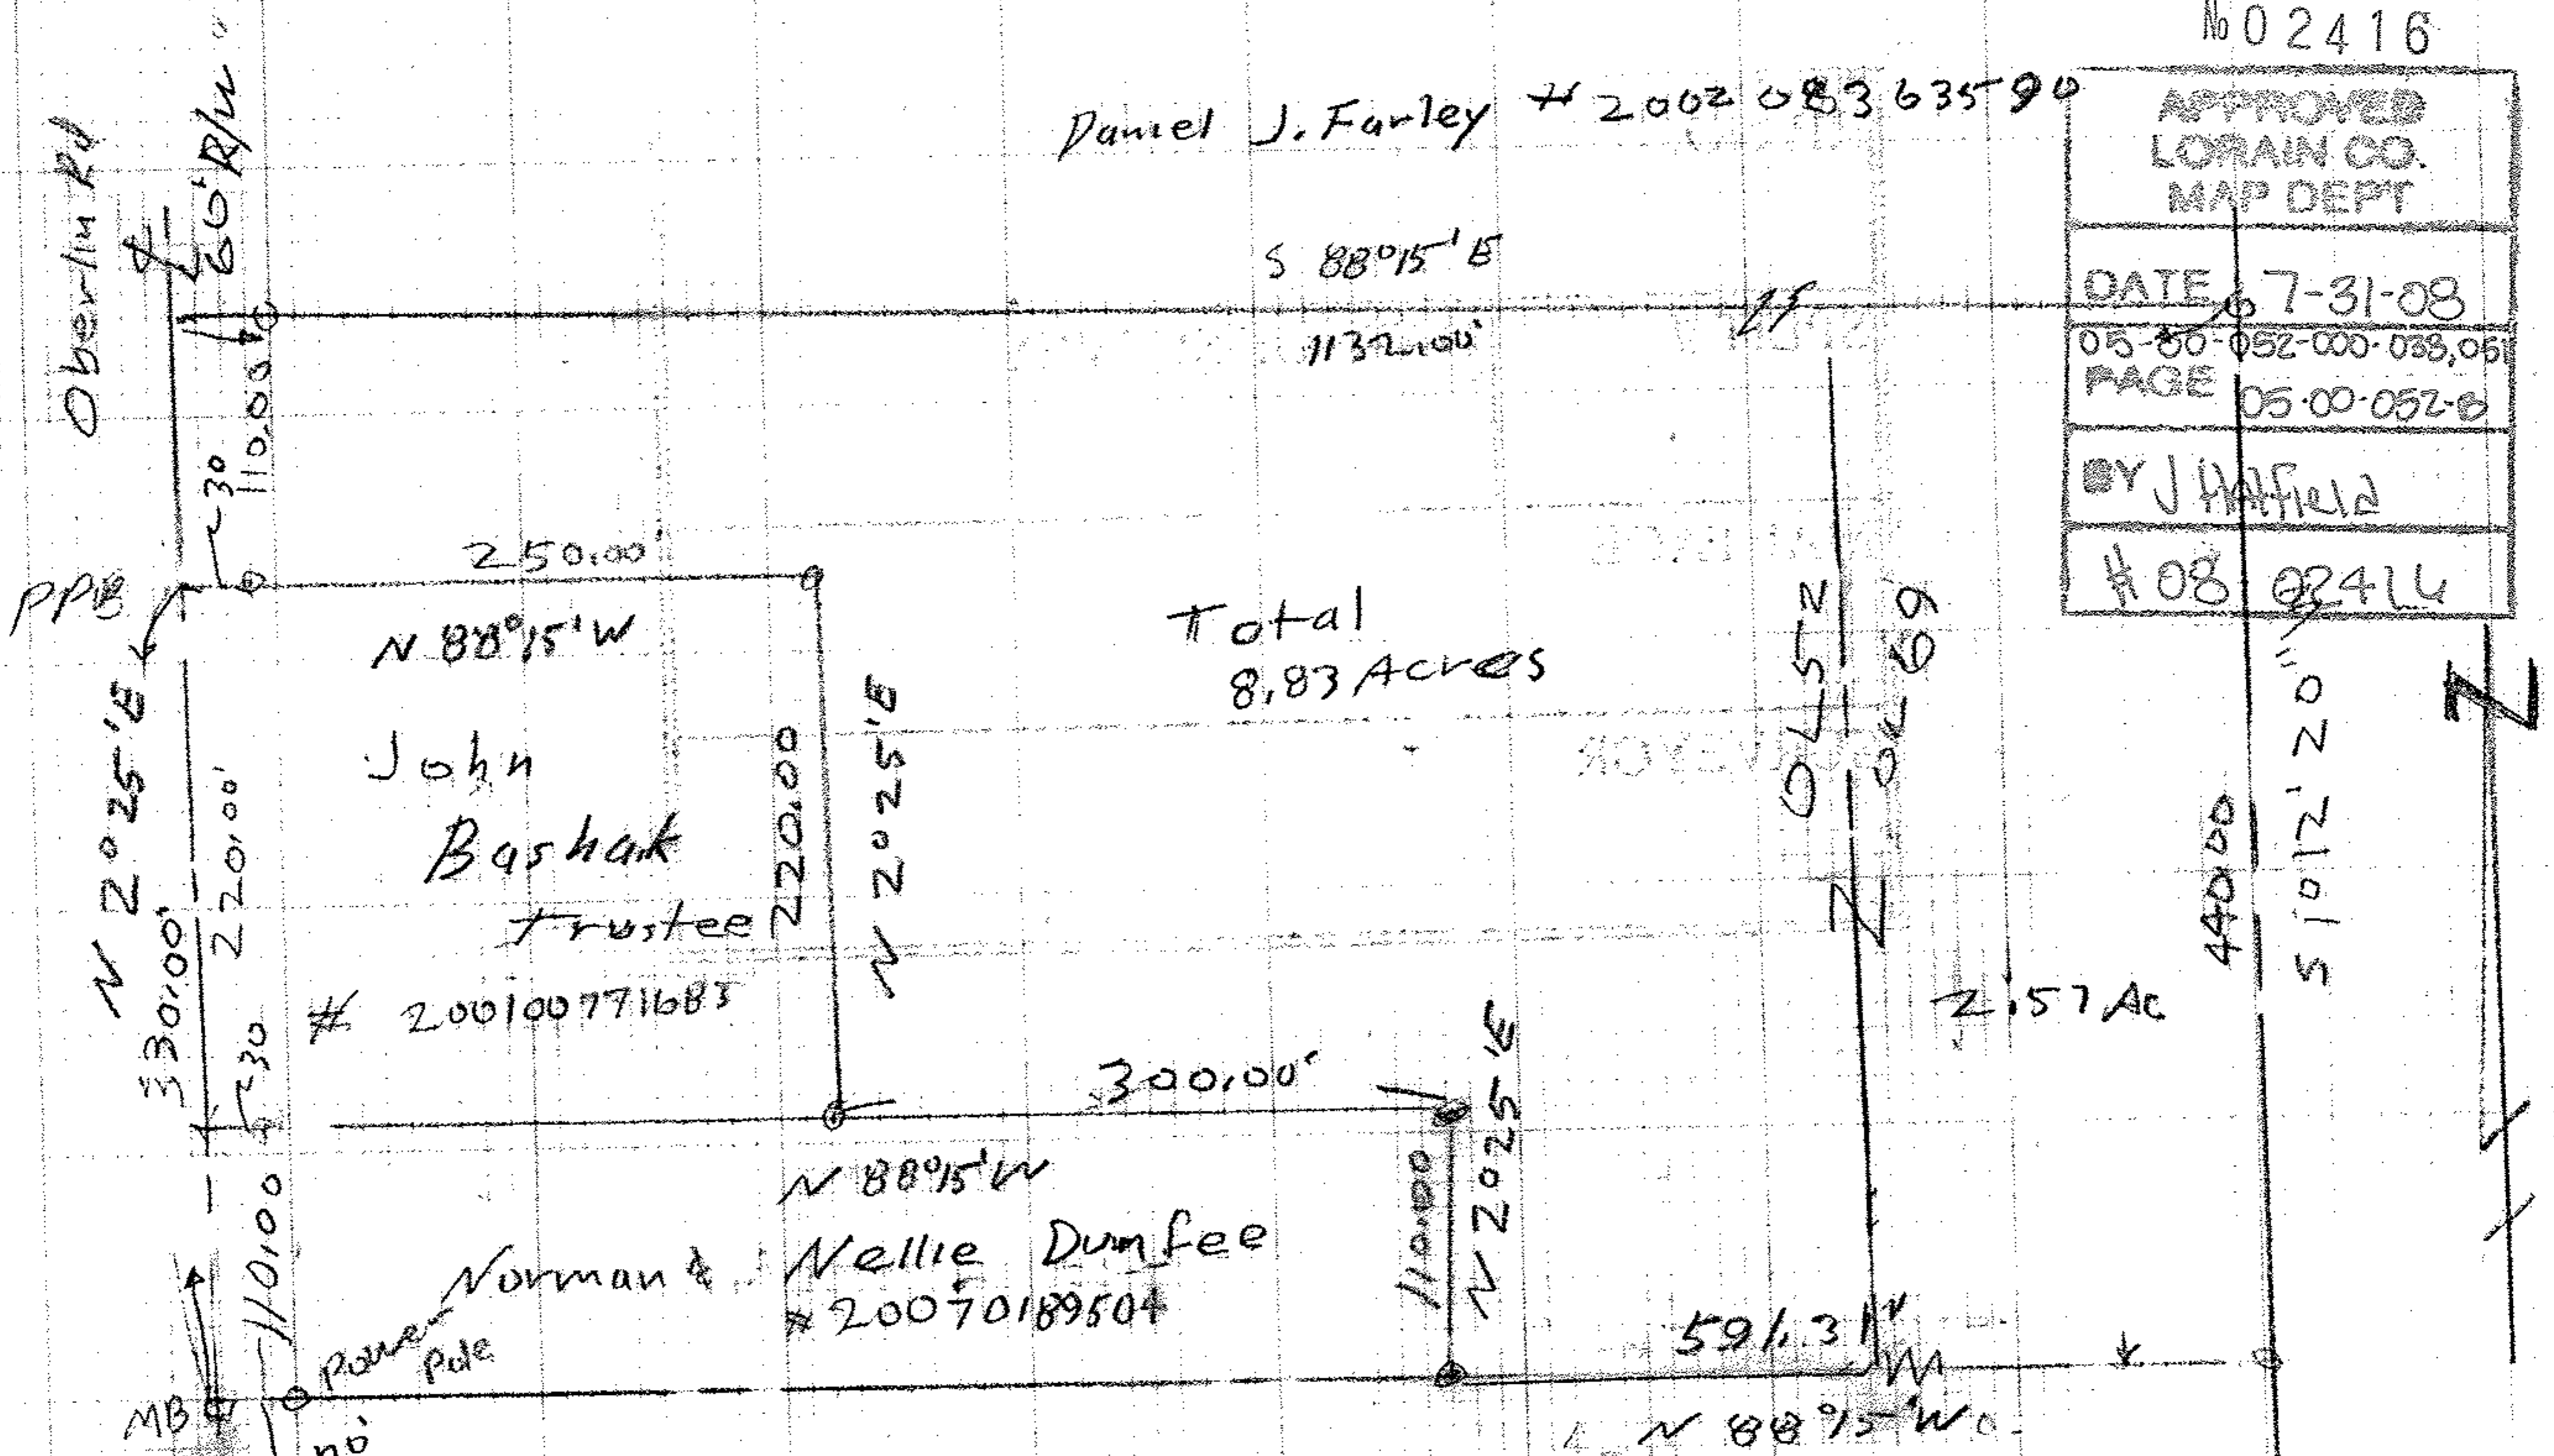

Total 8.83 Acres

John Bashak Trustee

Nellie Dumfee

Acreage shown in OL 69 Calc. graphically

John Pzyznal # Instrument No. 0 iron pipes fd 0 iron pins set feet

Survey Daniel Bashak # 200170192960

Original Lot 52 & 69 Amherst Twp Lorain County OH Scale 1" = 100' June, 2007 Revised July 07

