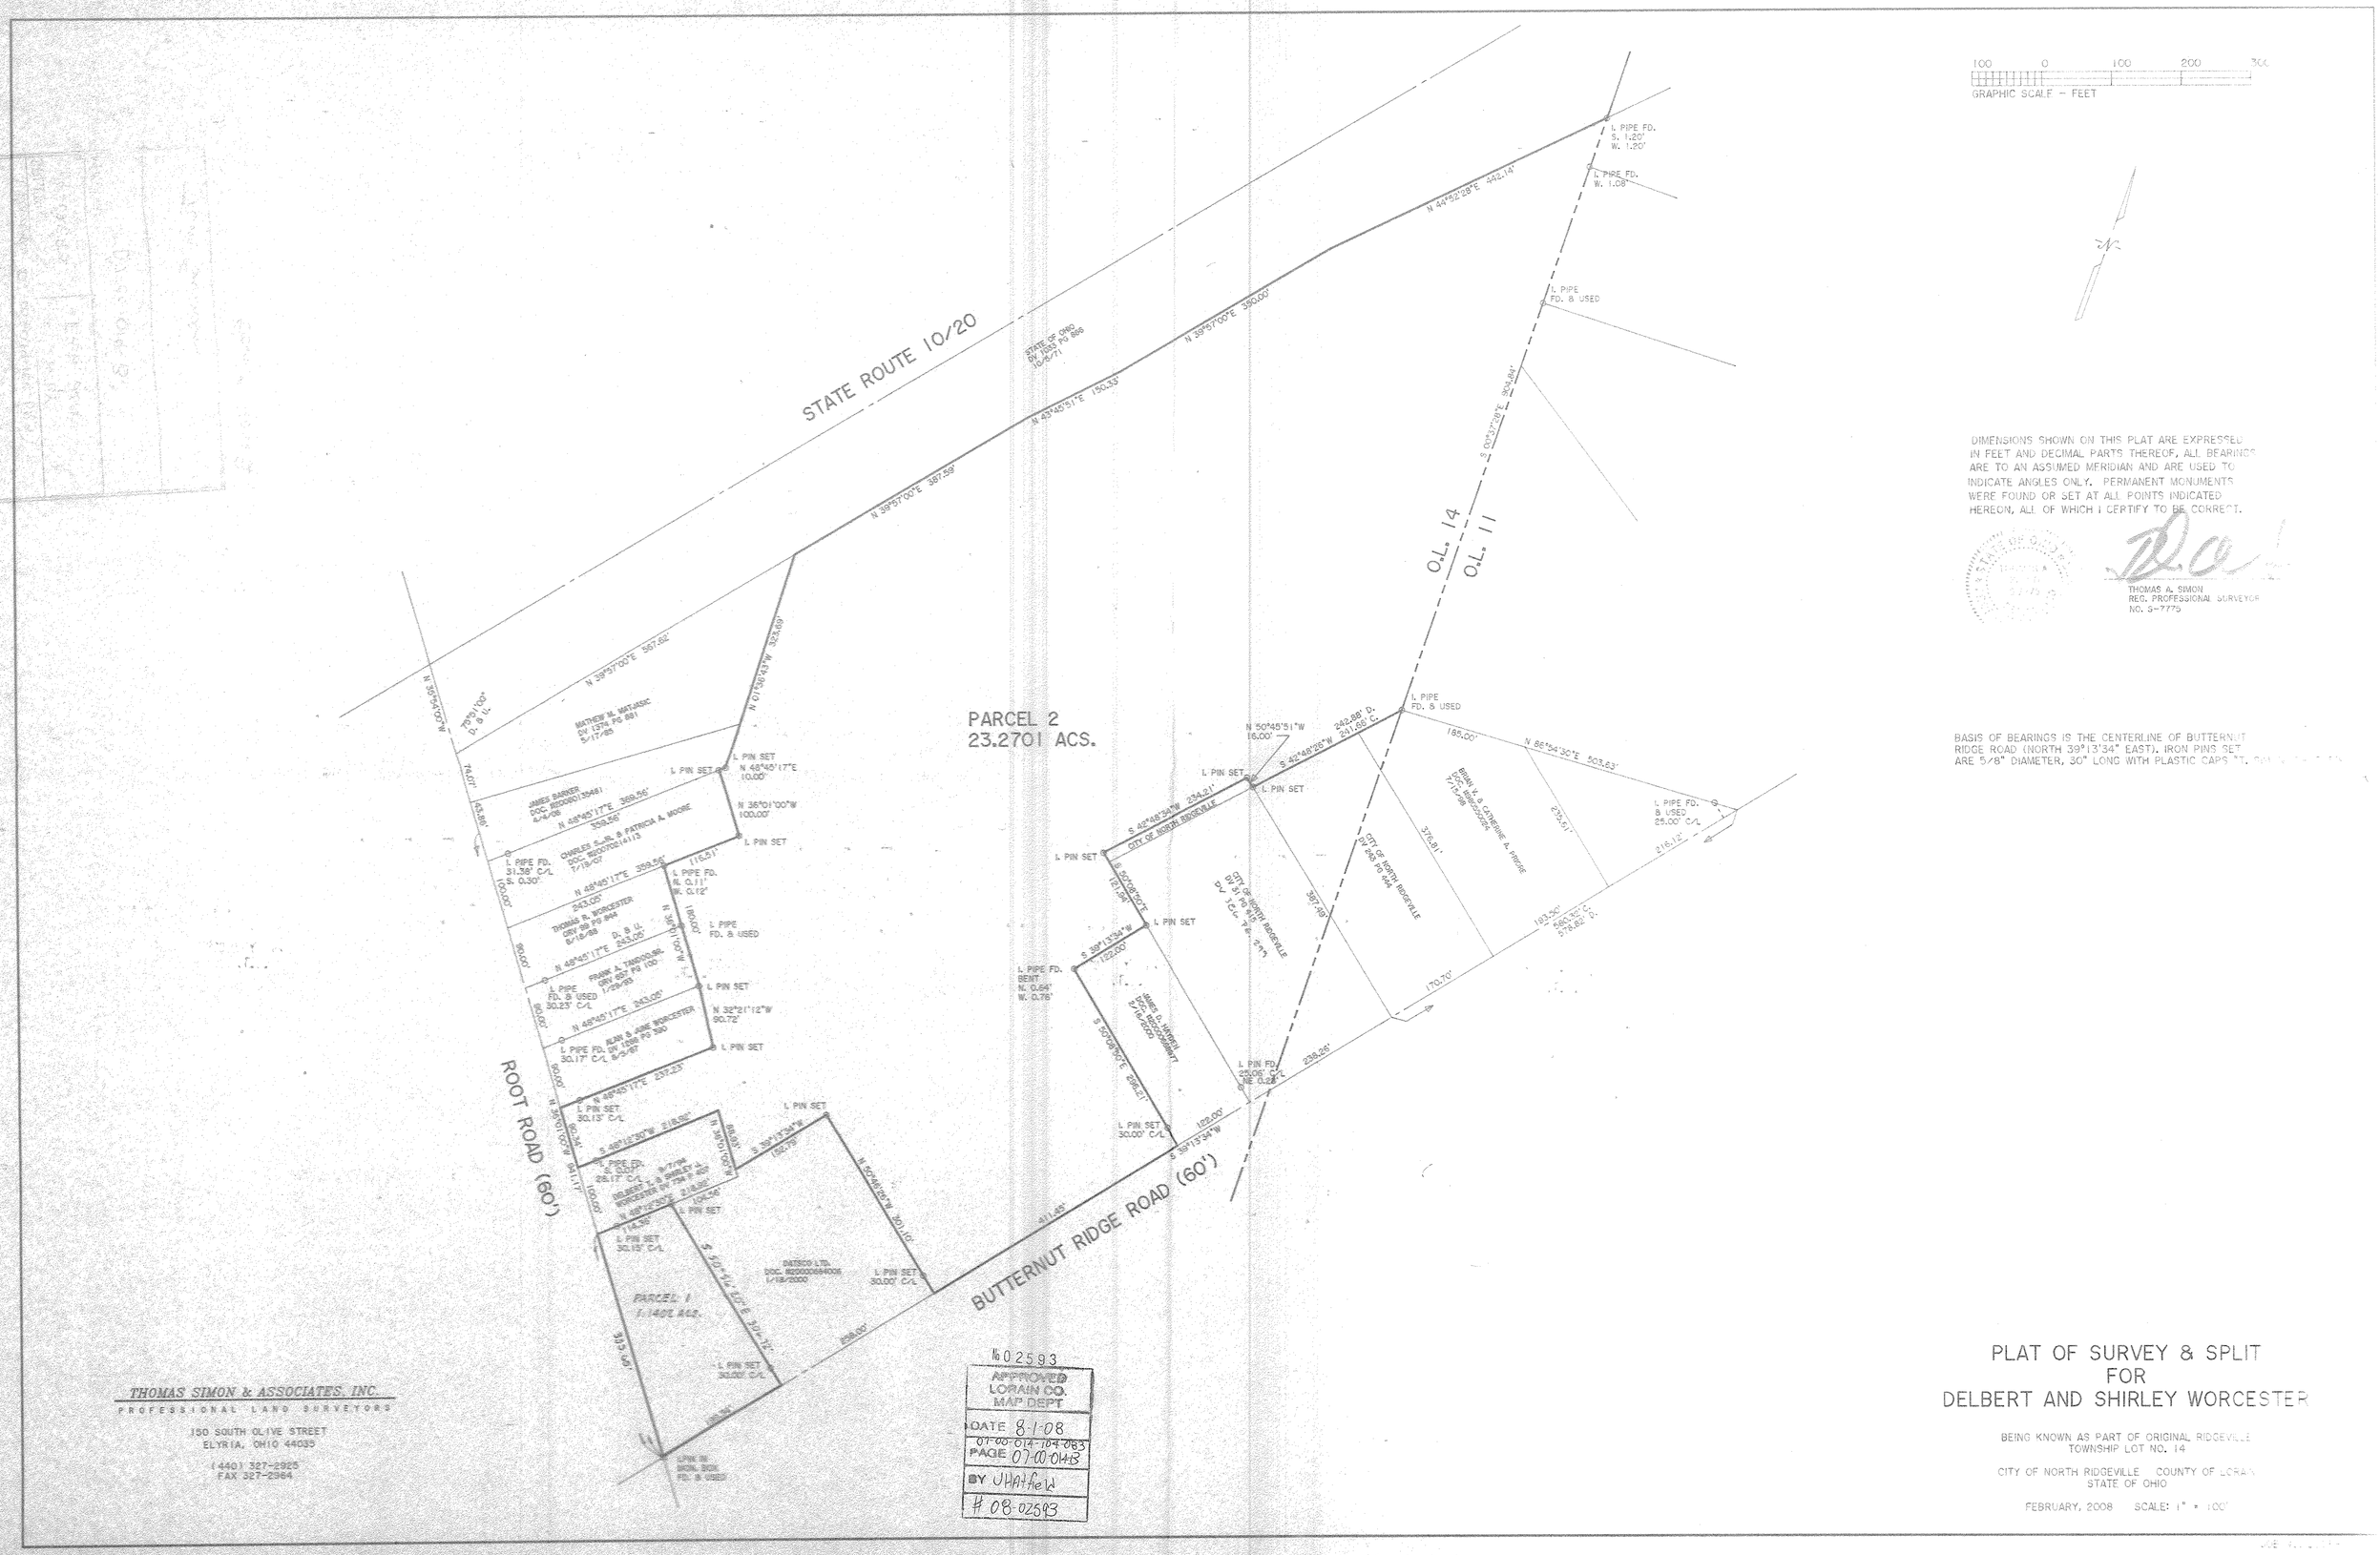

DIMENSIONS SHOWN ON THIS PLAT ARE EXPRESSED IN FEET AND DECIMAL PARTS THEREOF, ALL BEARINGS ARE TO AN ASSUMED MERIDIAN AND ARE USED TO INDICATE ANGLES ONLY. PERMANENT MONUMENTS WERE FOUND OR SET AT ALL POINTS INDICATED HEREON, ALL OF WHICH I CERTIFY TO BE CORRECT.

THOMAS A. SIMON
REG. PROFESSIONAL SURVEYOR
NO. S-7775

BASIS OF BEARINGS IS THE CENTERLINE OF BUTTERNUT RIDGE ROAD (NORTH 39°13'34" EAST). IRON PINS SET ARE 5/8" DIAMETER, 30" LONG WITH PLASTIC CAPS "T. SIMON & ASSOC."

THOMAS SIMON & ASSOCIATES, INC.
PROFESSIONAL LAND SURVEYORS
150 SOUTH OLIVE STREET
ELYRIA, OHIO 44035
(440) 327-2925
FAX 327-2964

#02593
APPROVED
LORAIN CO.
MAP DEPT
DATE 8-1-08
07-00-014-104-083
PAGE 07-00-014B
BY JHatfield
08-02593

PLAT OF SURVEY & SPLIT FOR DELBERT AND SHIRLEY WORCESTER

BEING KNOWN AS PART OF ORIGINAL RIDGEVILLE TOWNSHIP LOT NO. 14

CITY OF NORTH RIDGEVILLE COUNTY OF LORAIN
STATE OF OHIO

FEBRUARY, 2008 SCALE: 1" = 100'