MUNICIPAL ENGINEERING SUBDIVISIONS CITY AND FARM SURVEYS

J. W. WARDEN & ASSOCIATES

CIVIL ENGINEERS AND SURVEYORS

STATE OF OHIO
REGISTERED { PROFESSIONAL ENG. SURVEYOR

D. D. ANDRUS, PRESIDENT
405 ELYRIA BLOCK
ELYRIA, OHIO

TELEPHONES 3211
42871

M. W. JACKSON
SECRETARY

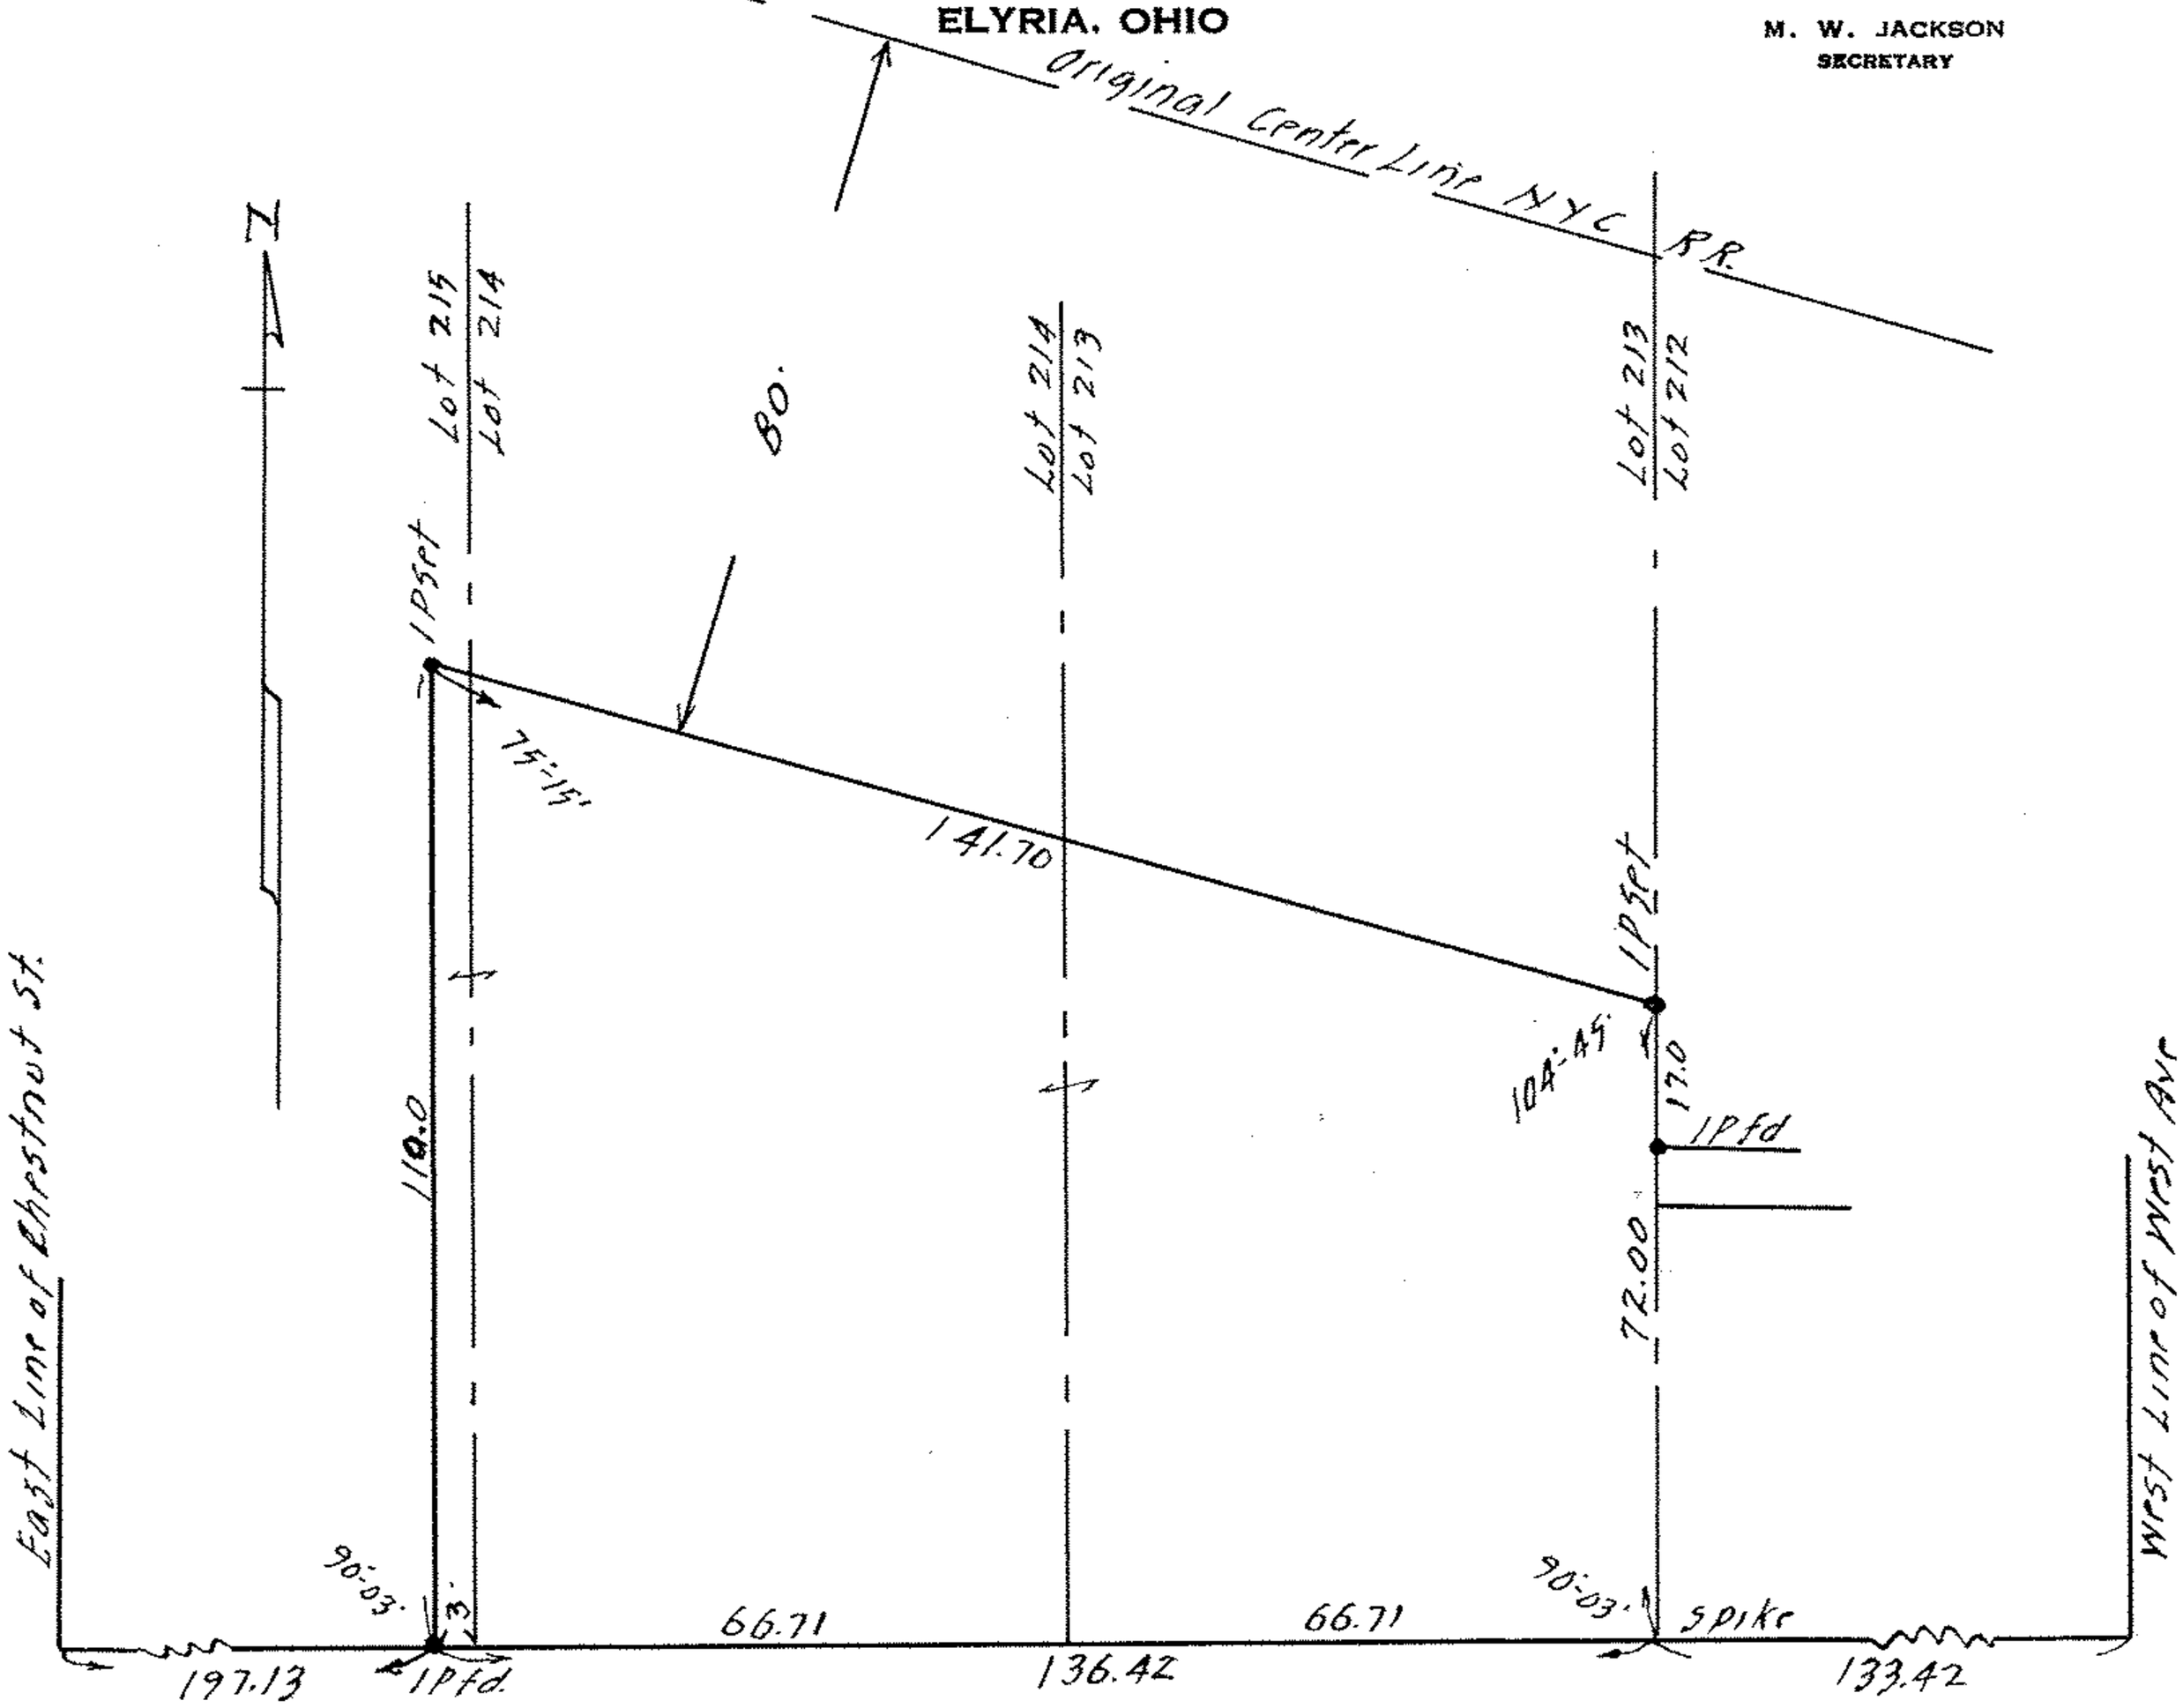

SURVEY FOR
IDA WACHSBERGER
D-VOL 724 PG 482 JULY 11, 1958
BLOCK 72 LOTS 213-214-215
ORIGINAL VILL PLAT-VOL 3 PAG 14
ELYRIA CITY LORAIN COUNTY OHIO
SCALE 1" = 30' MAY 17. 1960

57451 - 201342